

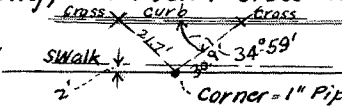
Jan 9, 1939
Arthur Boyer Dep. C.S.
Ted Shellabarger

S.E. 1st "L" Cor D.L.C. 39 on E. side S. Main St near Mosher, set from remains of B.T. which is S. 35° E 190 lks. from corner and is Orig W. Oak B.T. as certified to in a written, filed statement, by Mr. E.L. Giles in V. E. Set a 1" steel Auto axle from which the street monument just south of 331 S. Main St brs. S 50° W. 97. ft ^{9/4} a cross on curb at abt. prop. line bet 315 ^{9/4} 331 S. Main St brs. N 41° W 22.5 ft.

Jan 13, 1939
Arthur Boyer
Ted Shellabarger

SW Ext "L" Cor D.L.C. 38, on Left or W. bank Deer Cr. Set from ^{Fleser, 1914, Established} Orig B.T.s ^{9/4} from notes taken by Fleser Mar 1914 Book 11, P. 46 from surveys made when evidence was more distinct than now ^{9/4} from survey of city (Barn) property, Drove 1" Auto Rear Axle from which New Trees as follows bear N 55° W 81.5' (on slope) 18" Locust, on brow of hill, - S. 1 3/4° W. 46.9' 24" W. Oak - ^{9/4} Trees by Fleser still standing but decayed, S 26 1/2° E. 49', 24" Alder - N 47 1/2° E 13.0', 16" Alder - Willow gone

Jan 13, 1939
Arthur Boyer Dep. C.S.
Ted Shellabarger

S.W. Cor D.L.C. 38 on E Side Fowler St N. of Douglas St bet 417 + 427 Fowler St found 1" Iron Pipe only, chiseled cross on conc. curb S. 56° W. 21.7' ^{9/4} cross on Conc curb N 34° W 30.9' 

1/4 cor bet. Secs. 25 + 30 on Range Line 5 + 6 set from Old B.Ts. Corner set by placing 1/2" x 16" Galv. Iron Pipe from which New Bearing Trees { 8" W. Oak bears N 44° - 30' E 8.2 Feet, 10" W. Oak " N 46° W 137.8 "

1934 - 1937 - 1938
Claude Crocker
Arthur Boyer
J.H. Wolford
B.H. Lane

Cor. Sec. ^{24/19}/_{25/30} Set from W. Oak. Original B.T. S 36° E 116.8 Ft. Set (1/2" x 30" Iron Bar) Oak Stake under Ground. from which 24" W. Oak (see above Original B.T.), Street Monument Rice + Main St. Bears S 67° 06' W. 229.7 feet, + Street Monument Roberts + Main Sts. Bears N 5° 50' W 230.7 feet.

Cor Sec. ^{25/30}/_{36/31} This corner was gone, but was set by proportional distances between 1/4 to 25 + 30 + 1/4 to 31 + 36. Set 3/4" x 30" iron Rod for corner, from which New B.Ts were made, as follows.
24" W. Oak, Bears N 30° E 34.0 feet,
4" Laurel, " N 87° E 158.5 " "
6" BIK. Oak " S 2° E 41.5 " "
18" W. Oak " N 1° W 146.0 " "

1934 - 1937 - 1938

1/4 Cor. bet Sec. 31 & 36. from one Old B.T. Set a stake for corner
 #22 From which New B.Ts. { 10" W Oak. Bears S 59° E, 24.6 Feet.
 { 10" W Oak " S 57° 30' W, 165.1 "

36/31 Sec.
 #23 1/6 Cor to Sec 36 & 31 Township Cor. Set corner from old
 B.Ts. Set 3/4" x 36" round Bolt for corner. from which New B.Ts.
 12" White Oak Bears N 22° W 58.5 Feet.
 14" White Oak Bears N 81° 30' E 26.0 "

N.W. of T 285 R 5 W
 #24 Township Cor. 1/6 was set from old B.Ts. A 3/4" x 36" round Iron
 Bolt 30" in Ground New Bearing Trees was marked as follows.
 18" Black Oak. Bears S 62° 15' E, 152.6 Feet
 14" Black Oak, " S 86° 20' W 226.6 Feet.

1/4 Cor. South Side of Sec. 31. Set from original Bearing Trees
 by driving 3/4" x 36" round Iron Bolt for corner. Marked
 #25 New Bearing Trees. { 14" Forked Fir, Bears N. 56° E, 18.6 Feet.
 { 16" White Oak, " N. 52° W, 20.5 "

1/4 Cor Northside Sec. 6 T. 285. R. 5 W.
 #26 Set Cor. from one Original B.T. by driving 3/4" x 36" round
 Iron Bolt in Ground. Marked New Bearing Trees.
 as follows. { 14" Fir Bears, S 22° 15' E 120.3 Feet.
 { 8" white Oak. " S 46° 45' W 17.3' Feet.

CORNER Sec. 31 & 32.

#27 Found 1 original B.T. Other gone. Set Cor from one
 B.T. by driving 3/4" x 36" Iron Bolt for corner.
 from which { Fir 24" dia Bears N 9° E, 114 Ft. New B.T.
 { Fir 30" dia; Bears N 70° 45' W, 65.3 Ft. Old B.T.

1/4 CORNER bet 31 & 32.

#28 Found one original B.T. almost gone. from which
 corner was set. A stake. from which New Bearing
 Trees as follows. { Pine 24" Dia. bears S 36° 45' W, 18.0 Feet.
 { Fir 12" Dia bears S 54° E, 22.0 Feet.

CORNER.

#29 Sec 30/29 31/32. Found 3/4" Iron Pipe at corner and two
 Original B.Ts. with scribed marks visible.

Marked 4 New Bearing Trees,
 16" white Oak S 76° 45' W 77.2 Feet.
 12" " " N 40° 30' W 57.3 " "
 24" " " S. 5° 13' E 71.5 " "
 16" " " N. 17° E 98.9 " "

1934-1937-1938
 on S.E. R. A. Project.
 Claude Crocker.
 J. H. Wolford
 Arthur Boyer.
 B. A. Lane.