T. 19 S., R. 8 W.
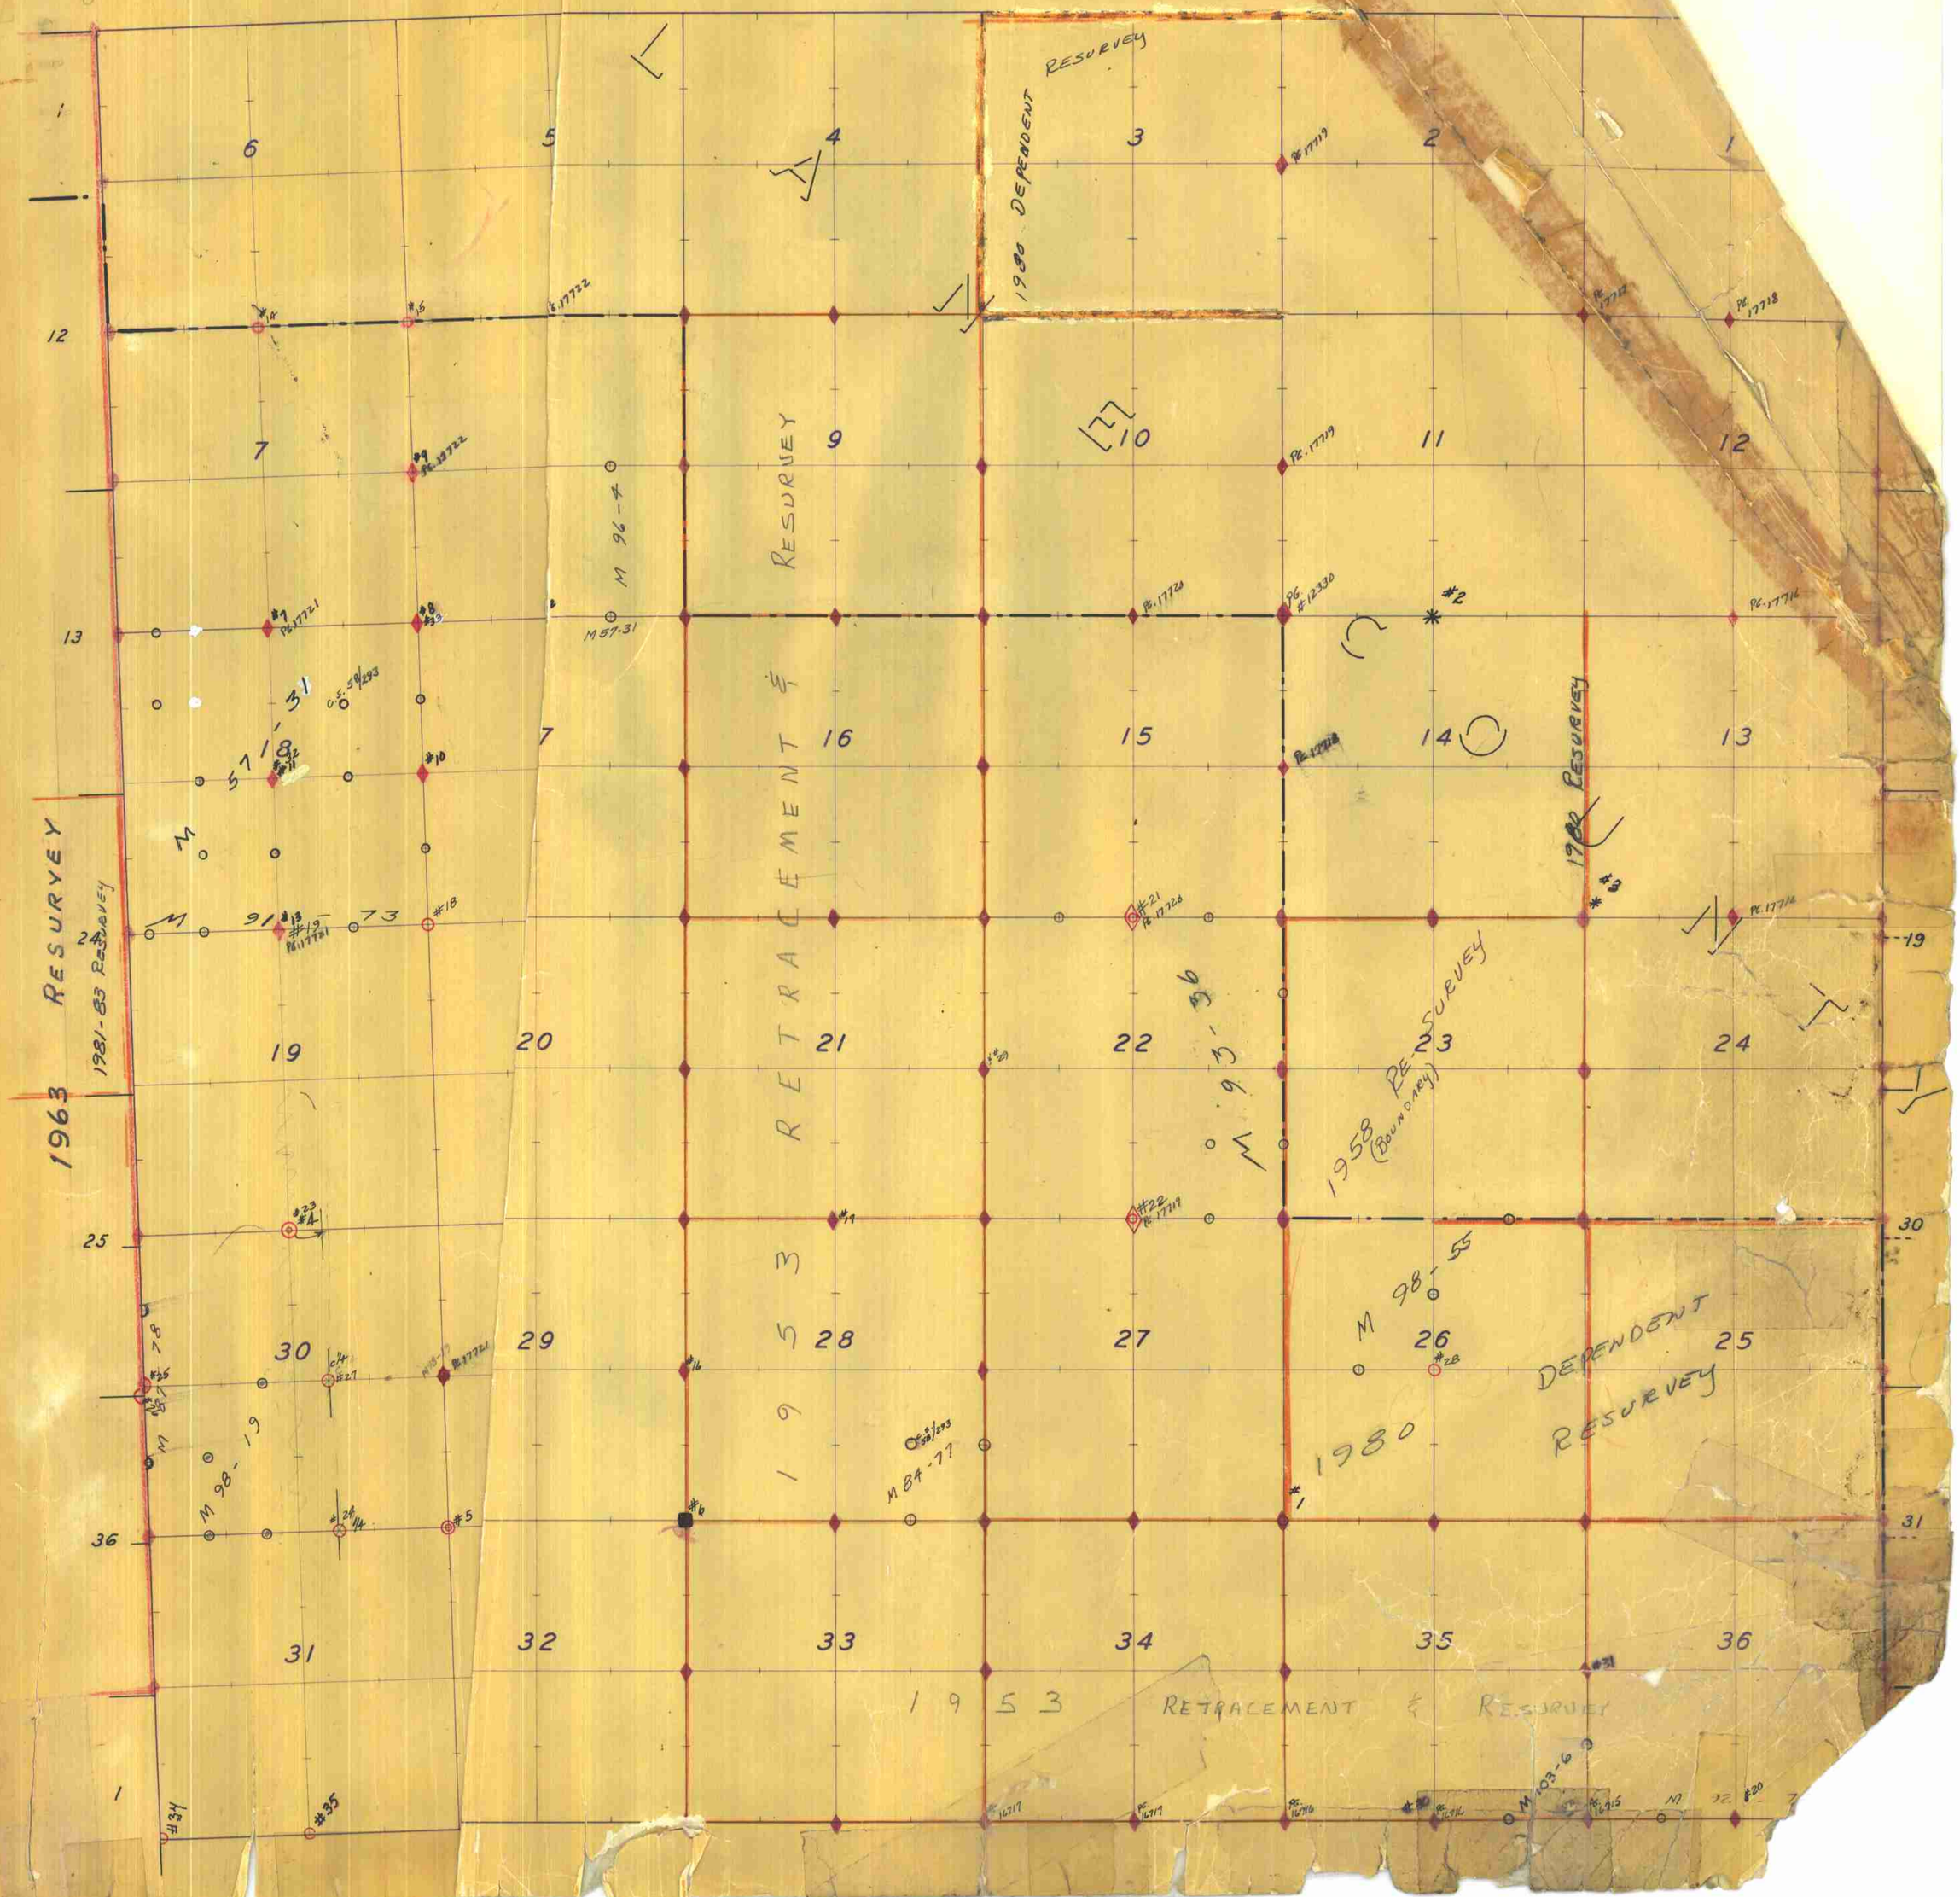
CORNERS RENEWED BY
BUREAU OF LAND MANAGEMENT
COUNTY SURVEYOR'S OFFICE
PRIVATE SURVEYORS
CORNERS FOUND & USED
CORNERS LOOKED FOR AND NOT FOUND
DATA BY LANE CO. SURVEYOR