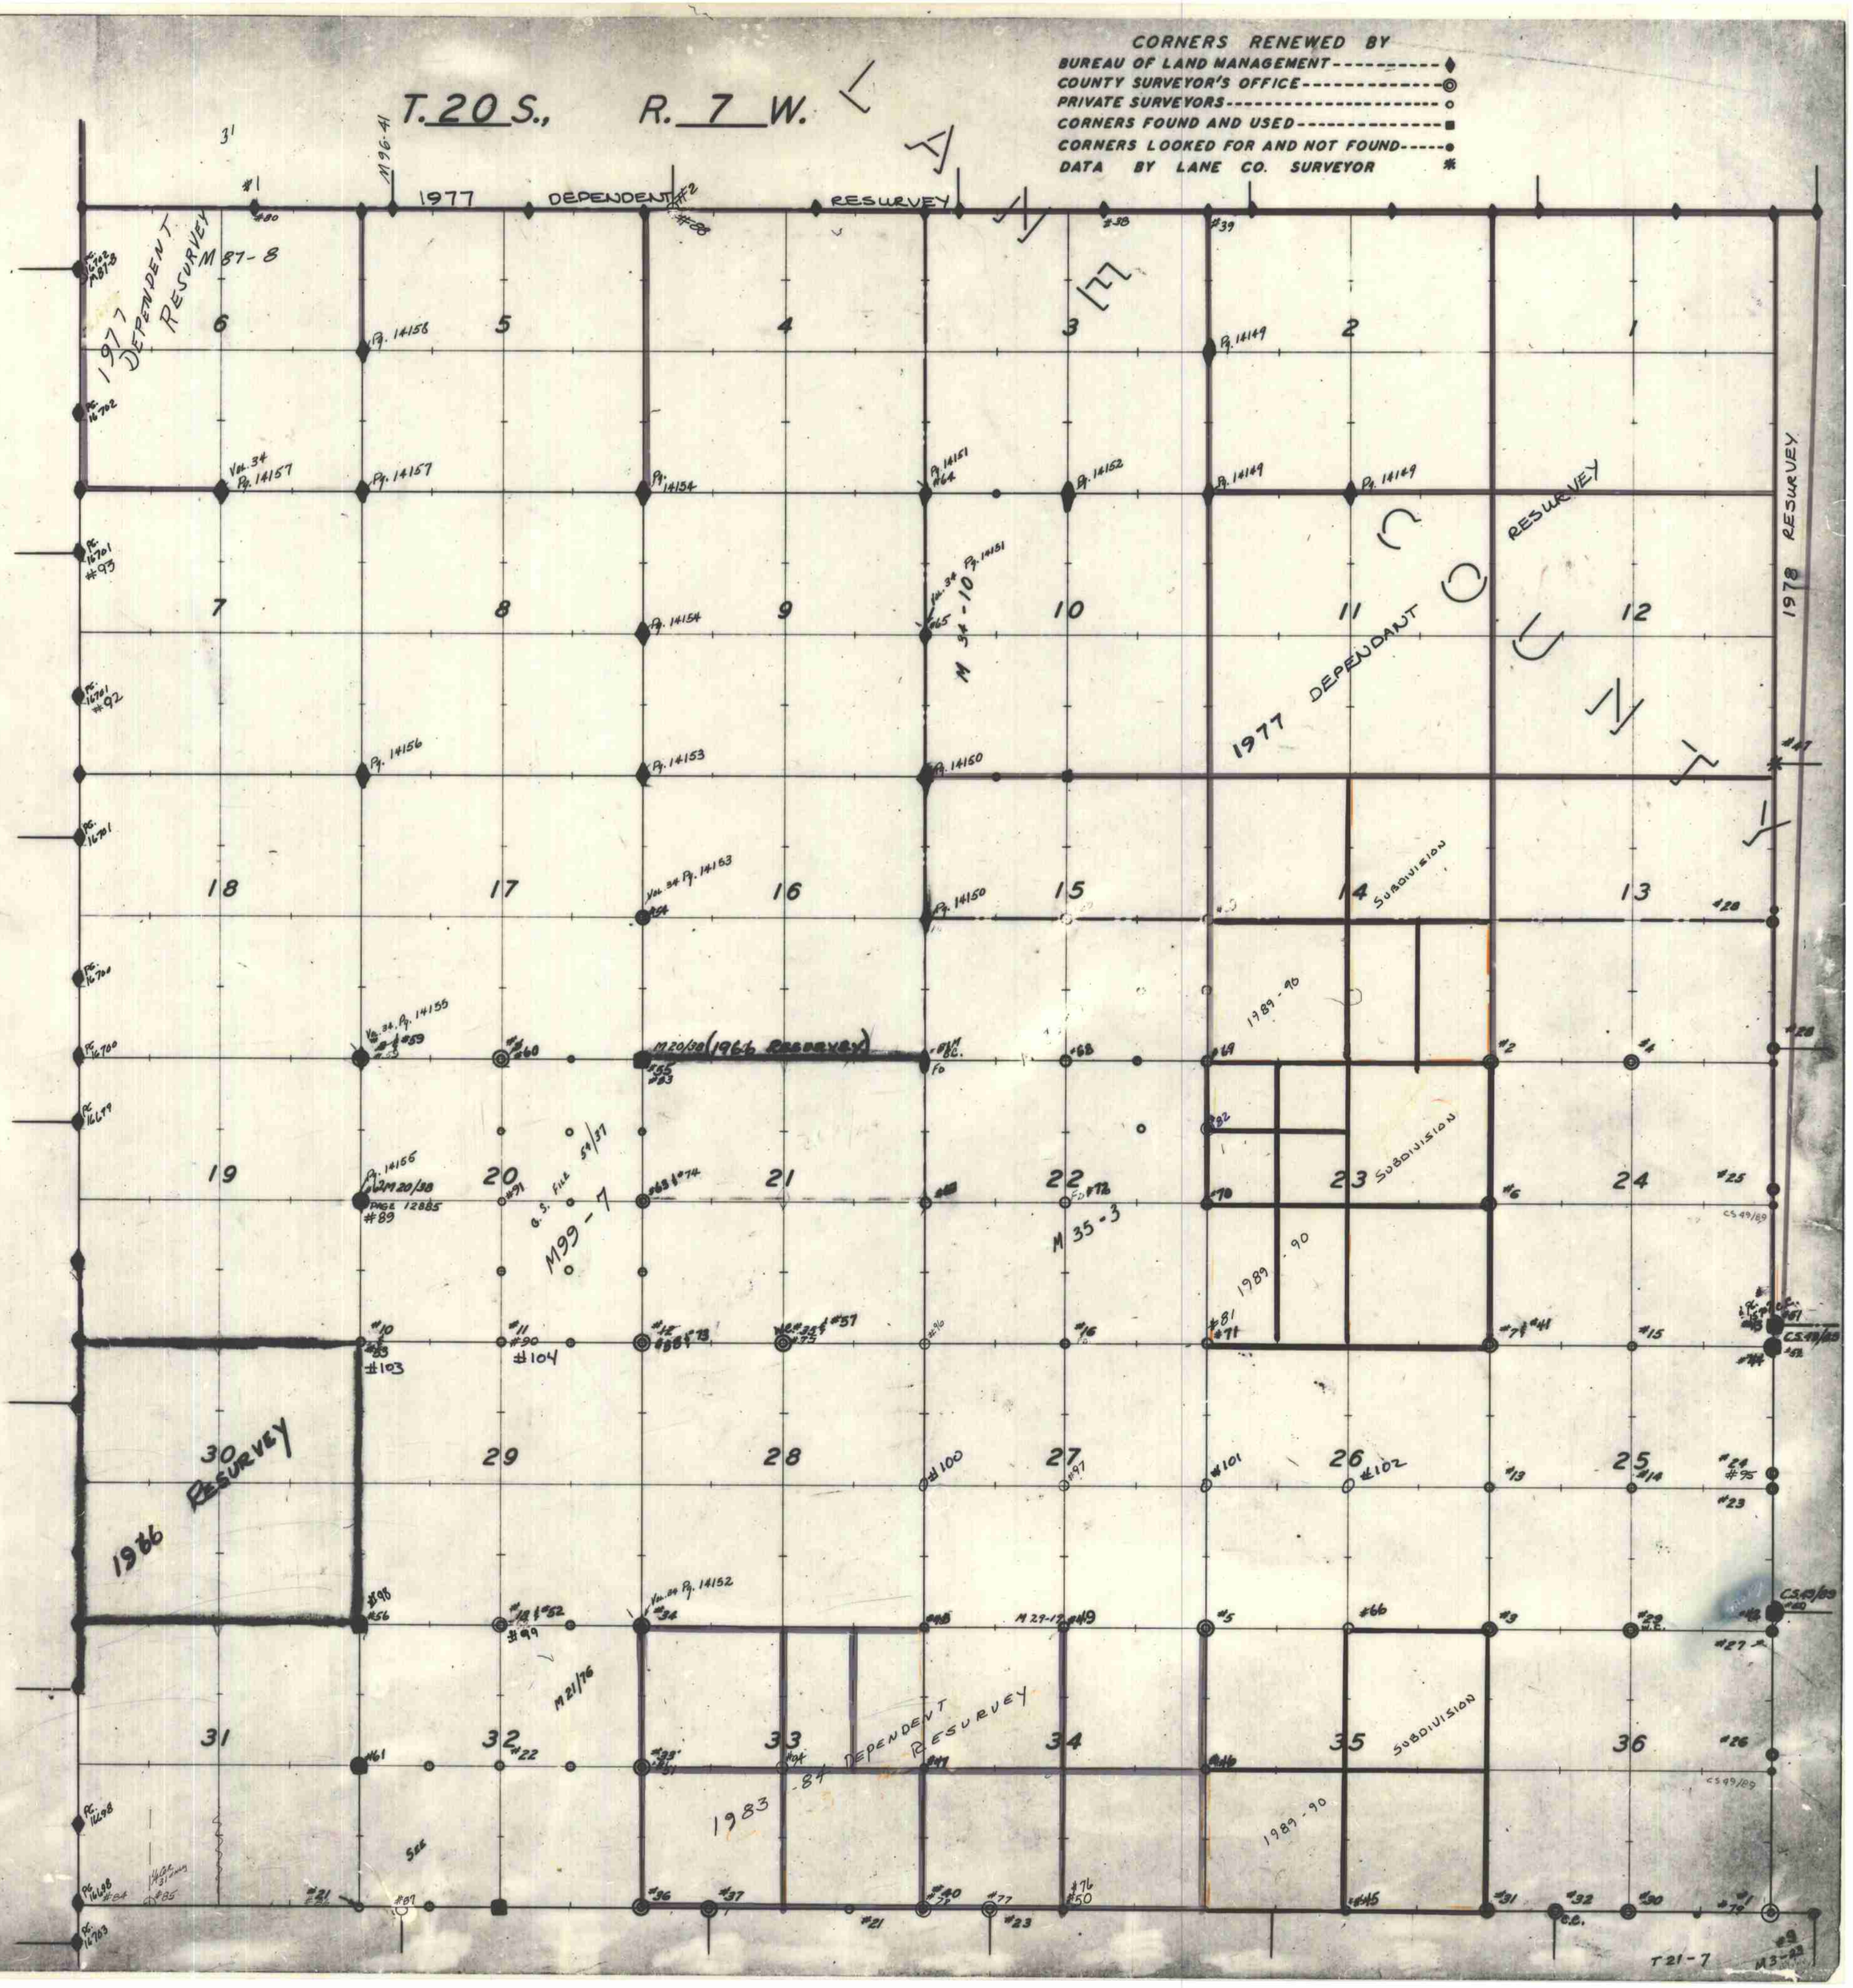
T. 20 S., R. 7 W.
CORNERS RENEWED BY
BUREAU OF LAND MANAGEMENT
COUNTY SURVEYOR'S OFFICE
PRIVATE SURVEYORS
CORNERS FOUND AND USED
CORNERS LOOKED FOR AND NOT FOUND
DATA BY LANE CO. SURVEYOR
1977 DEPENDENT RESURVEY
M 87-8
1977 DEPENDENT RESURVEY
1978 RESURVEY
1977 DEPENDANT RESURVEY
SUBDIVISION
1989-90
M20/38 (1964 RESURVEY)
M 35-3
M99-7
1986 RESURVEY
M 21/76
1983 DEPENDENT RESURVEY
M 27-12
T 21-7