8

T. 20 S., R. 10 W.

CORNERS RENEWED BY
BUREAU OF LAND MANAGEMENT
COUNTY SURVEYOR'S OFFICE
PRIVATE SURVEYORS
CORNERS FOUND AND USED
CORNERS LOOKED FOR AND NOT FOUND
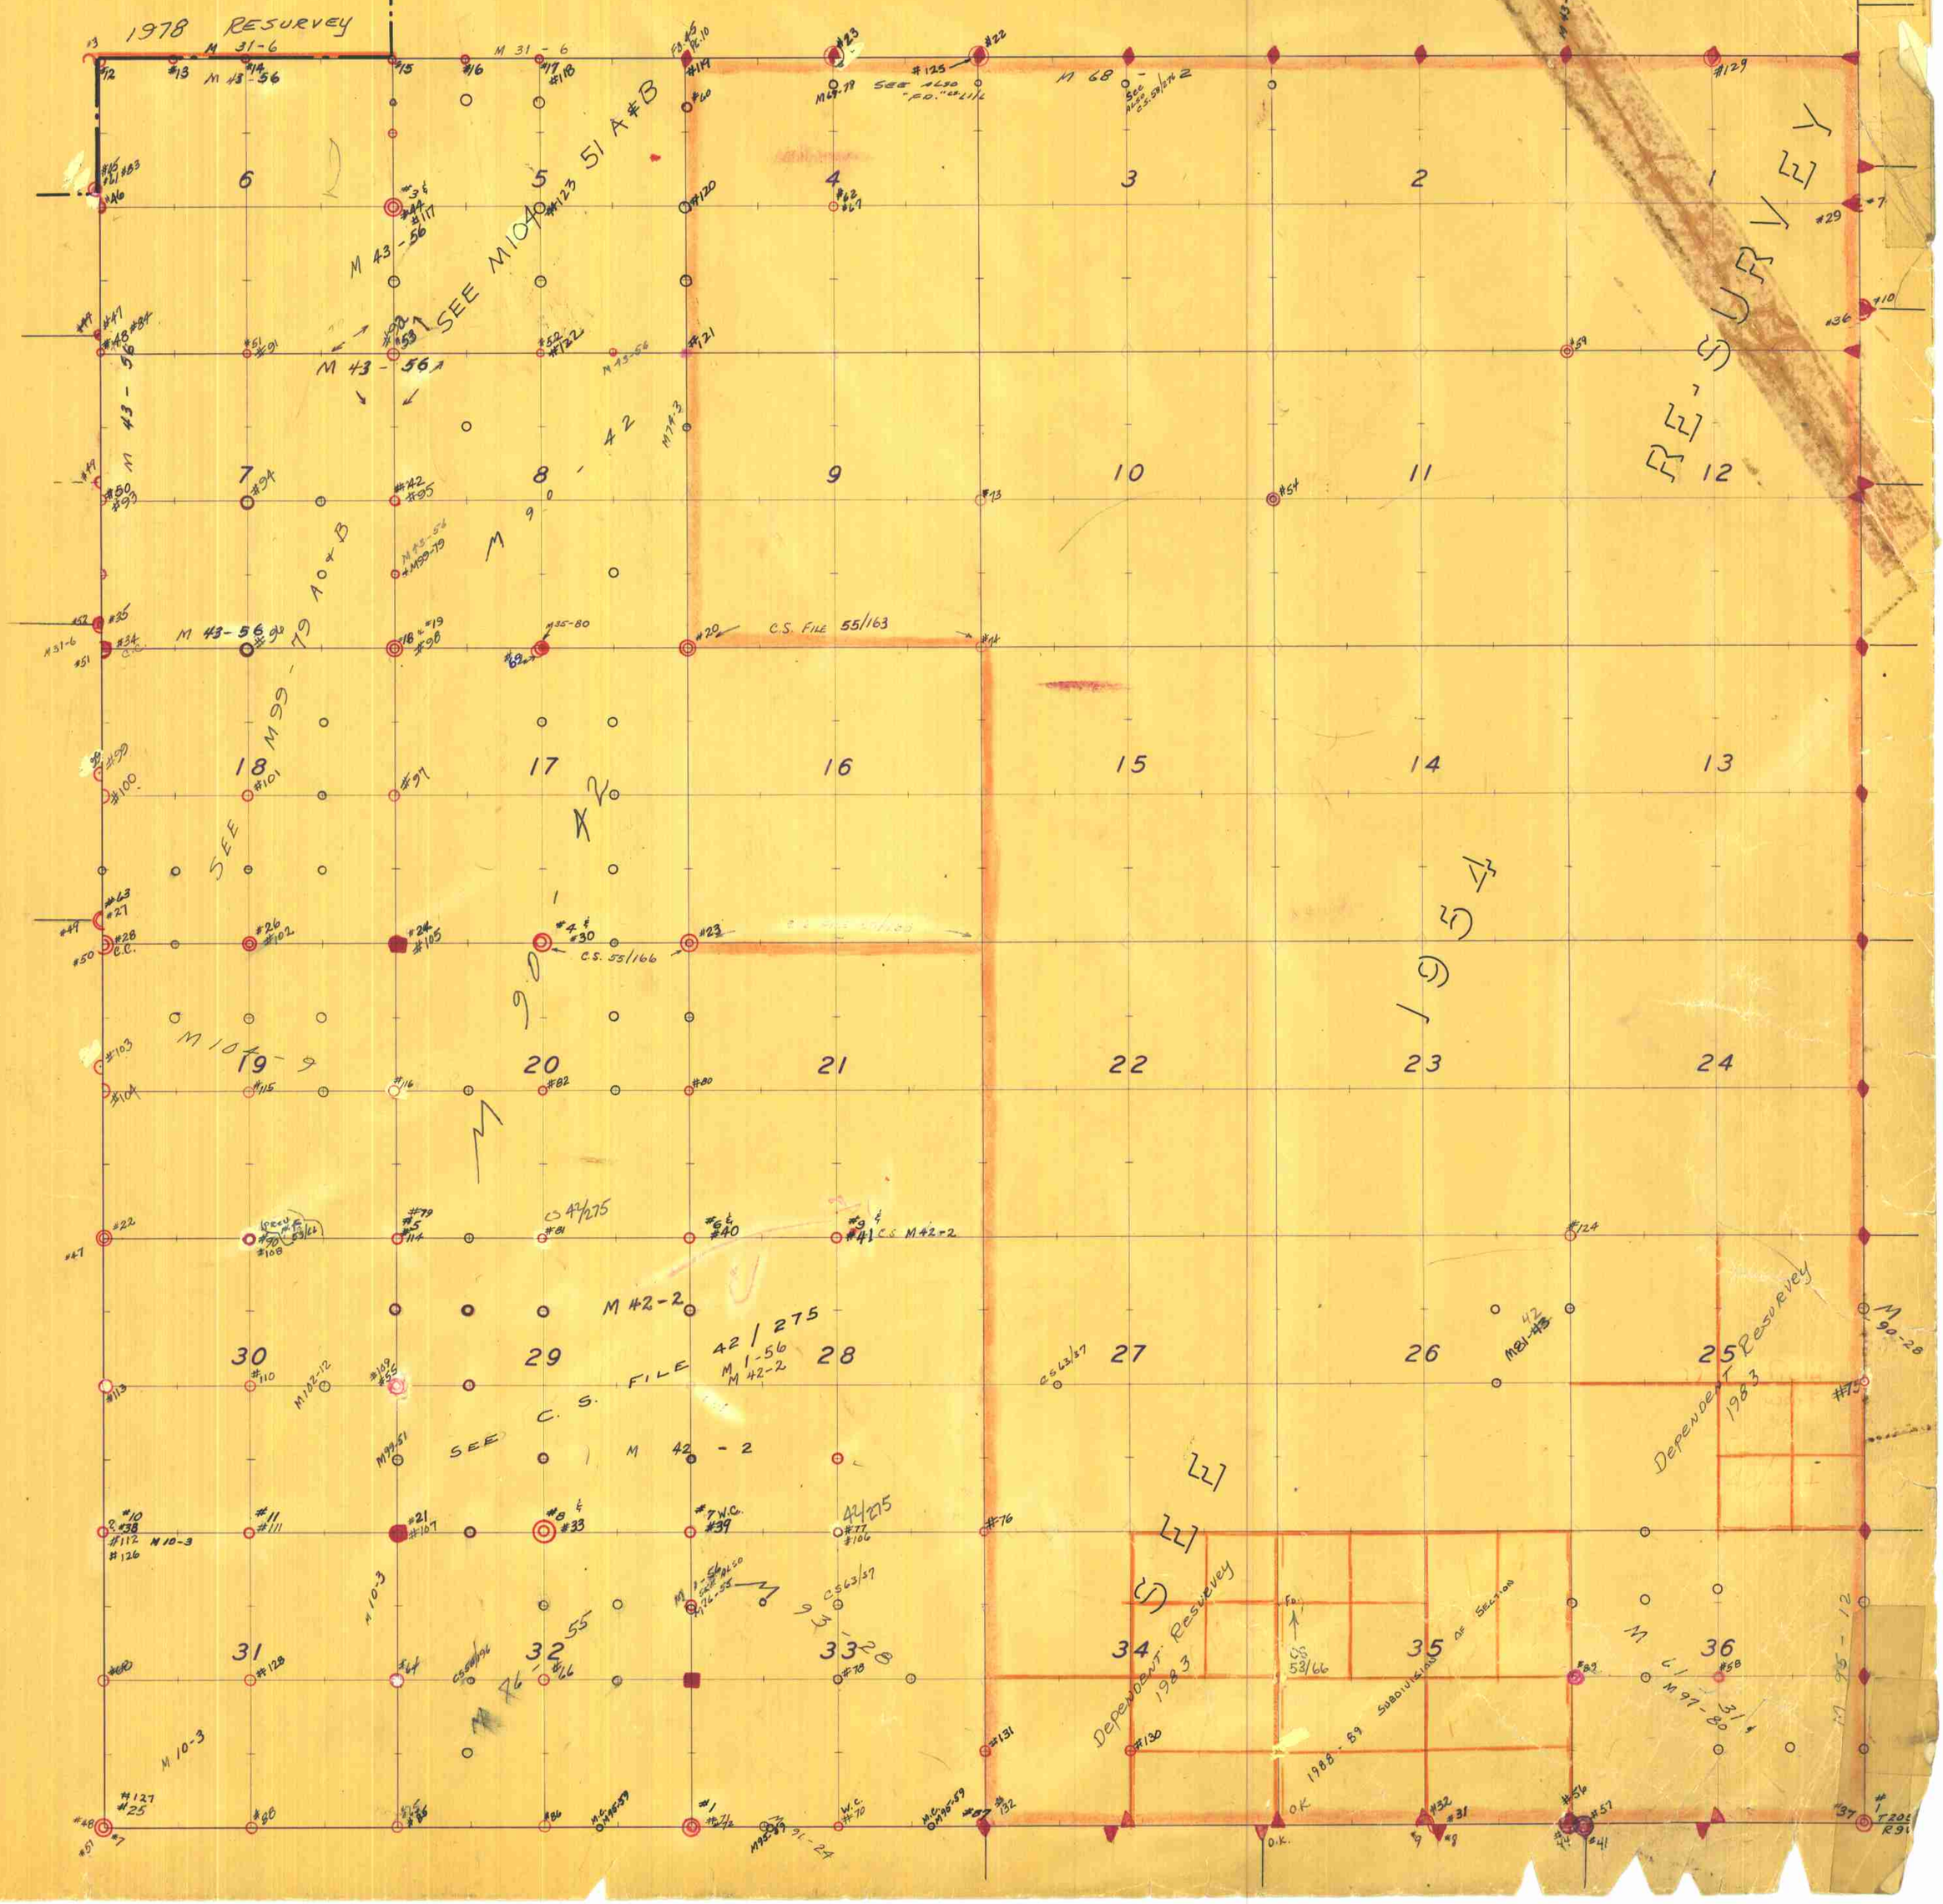
.052