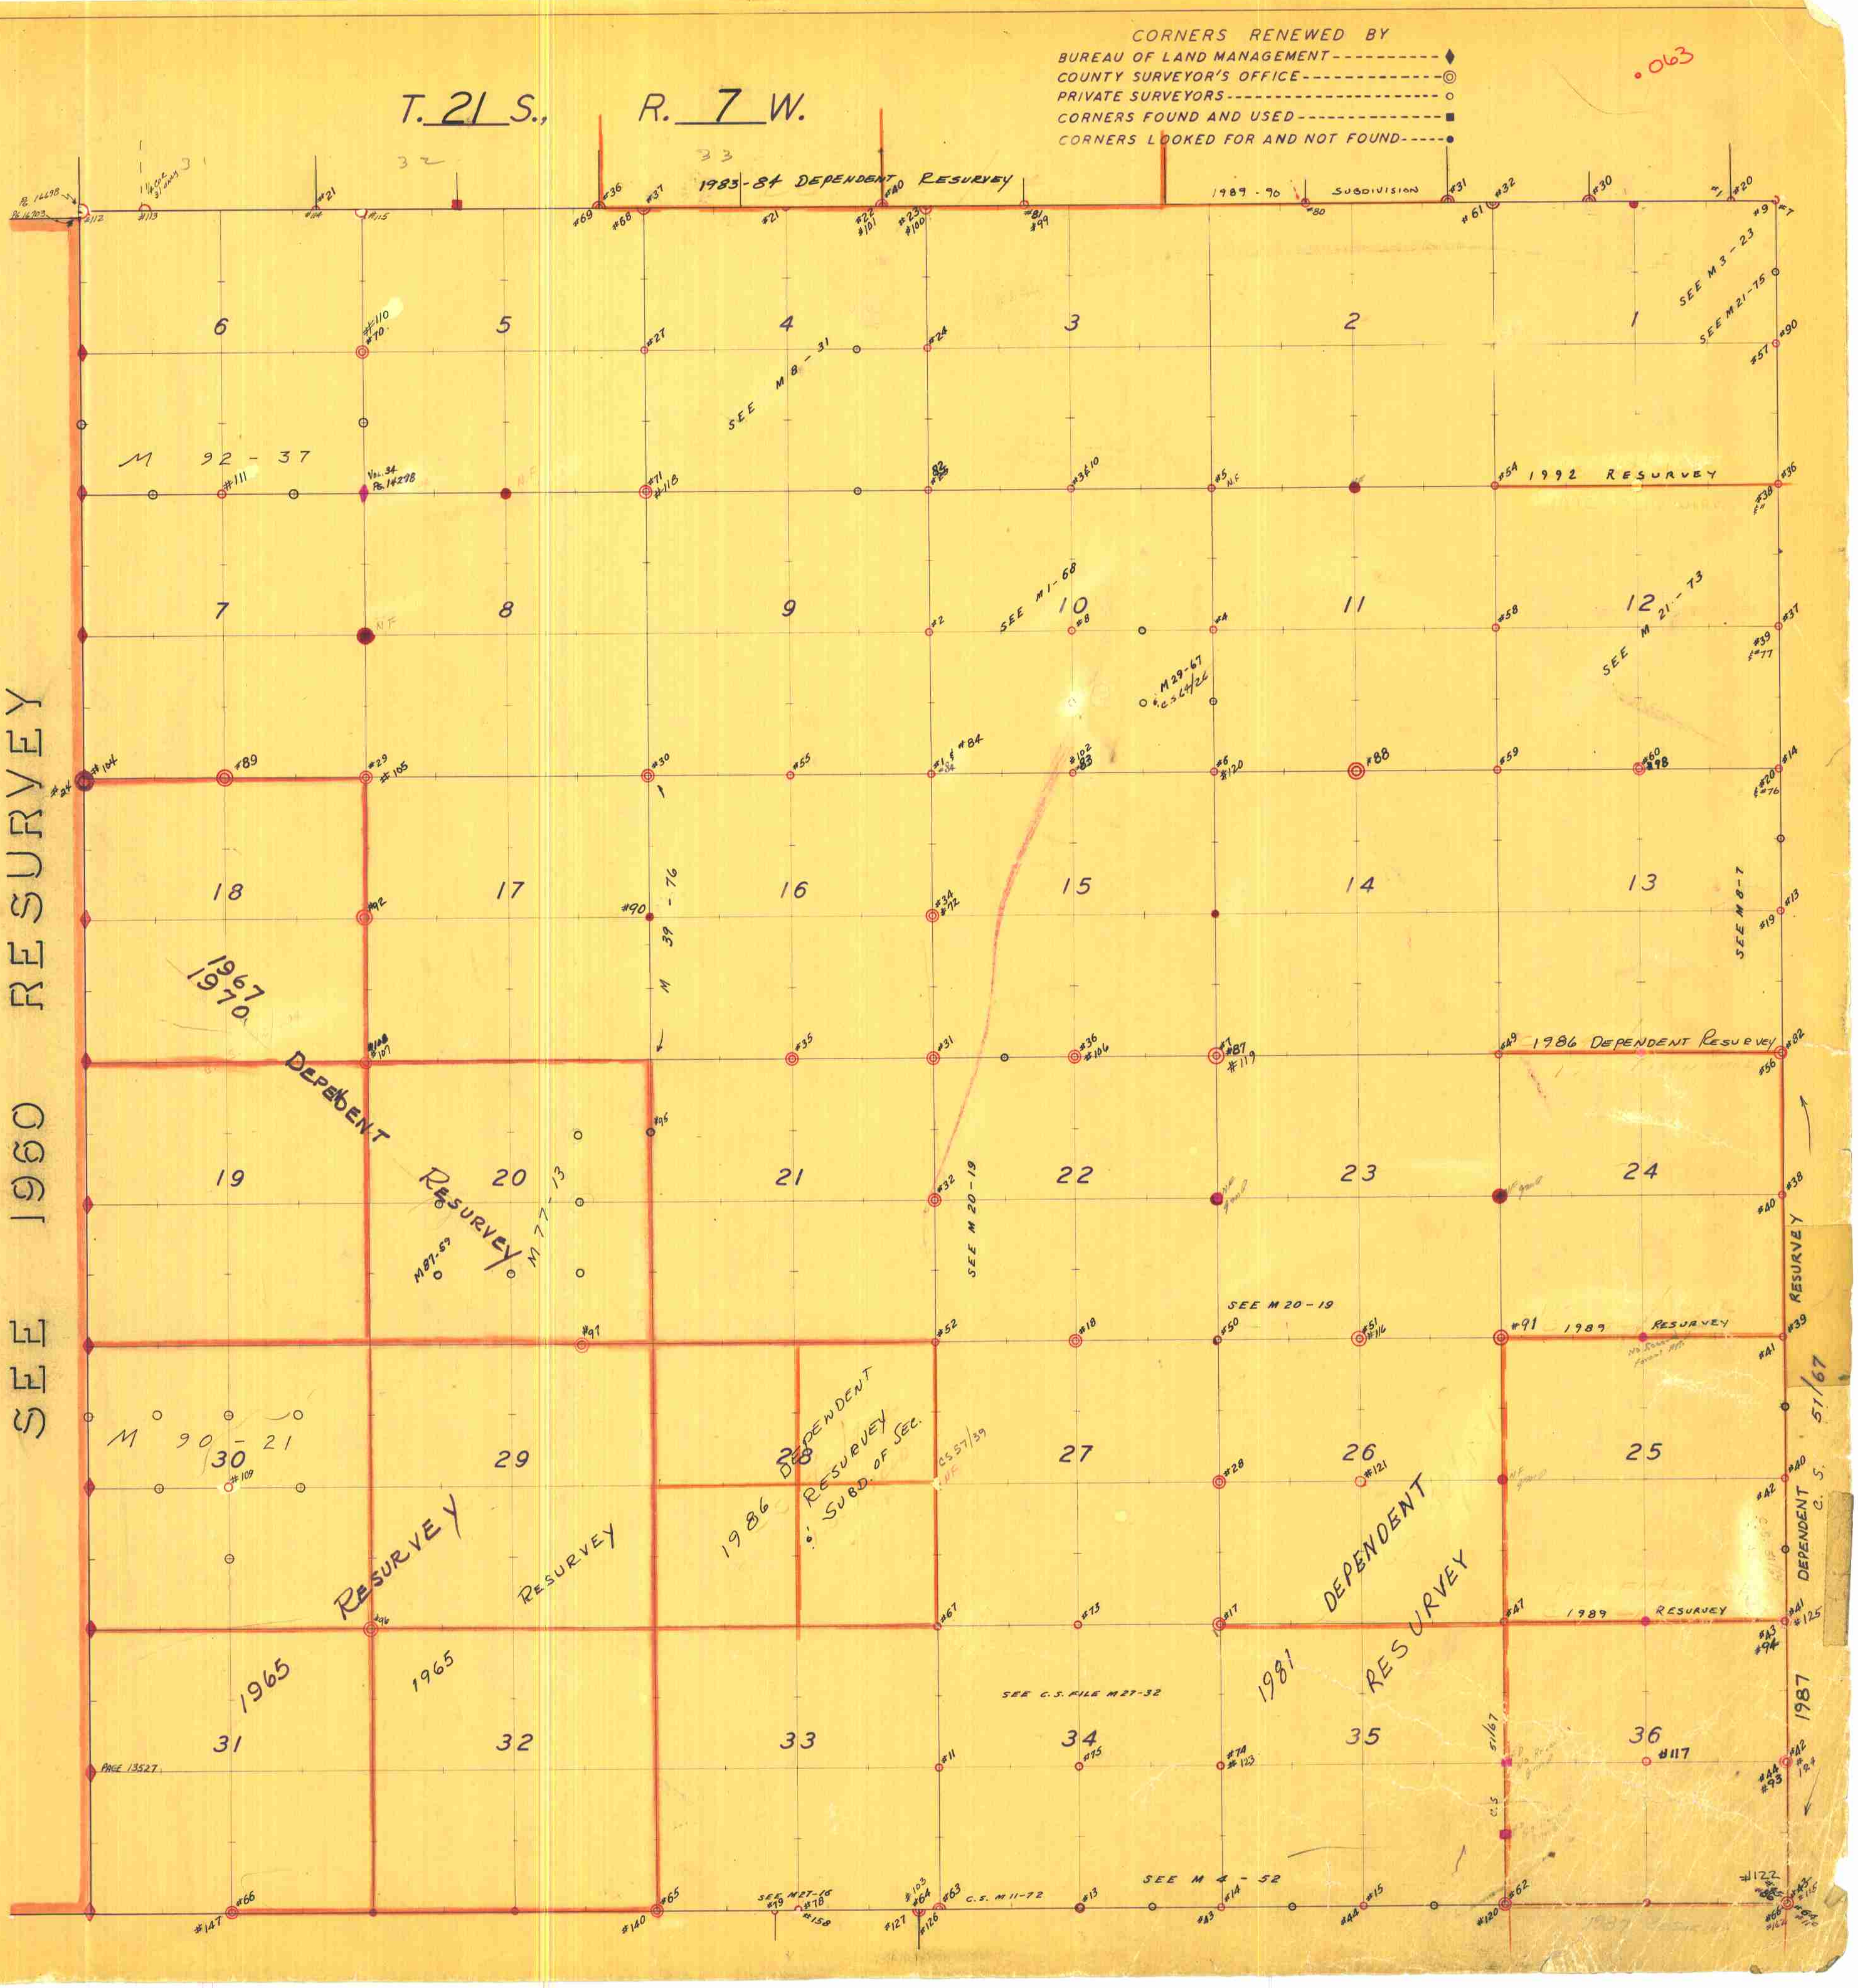
.063
T. 21 S., R. 7 W.
CORNERS RENEWED BY
BUREAU OF LAND MANAGEMENT
COUNTY SURVEYOR'S OFFICE
PRIVATE SURVEYORS
CORNERS FOUND AND USED
CORNERS LOOKED FOR AND NOT FOUND
1983-84 DEPENDENT RESURVEY
1989-90 SUBDIVISION
SEE 1960 RESURVEY
SEE M 3-23
SEE M 21-75
SEE M 8-31
M 92-37
1992 RESURVEY
SEE M 1-68
SEE M 21-73
M 29-67
SEE M 8-7
M 39-76
1967
1970
DEPENDENT RESURVEY
1986 DEPENDENT RESURVEY
M 77-13
M 87-59
SEE M 20-19
1989 RESURVEY
M 90-21
1986 DEPENDENT RESURVEY & SUBD. OF SEC.
C.S. 57/39
RESURVEY
1965
1981 DEPENDENT RESURVEY
SEE C.S. FILE M 27-32
DEPENDENT C.S. 51/67
1987
PAGE 13527
SEE M 4-52
C.S. M 11-72
SEE M 27-16
6
5
4
3
2
1
7
8
9
10
11
12
18
17
16
15
14
13
19
20
21
22
23
24
30
29
28
27
26
25
31
32
33
34
35
36