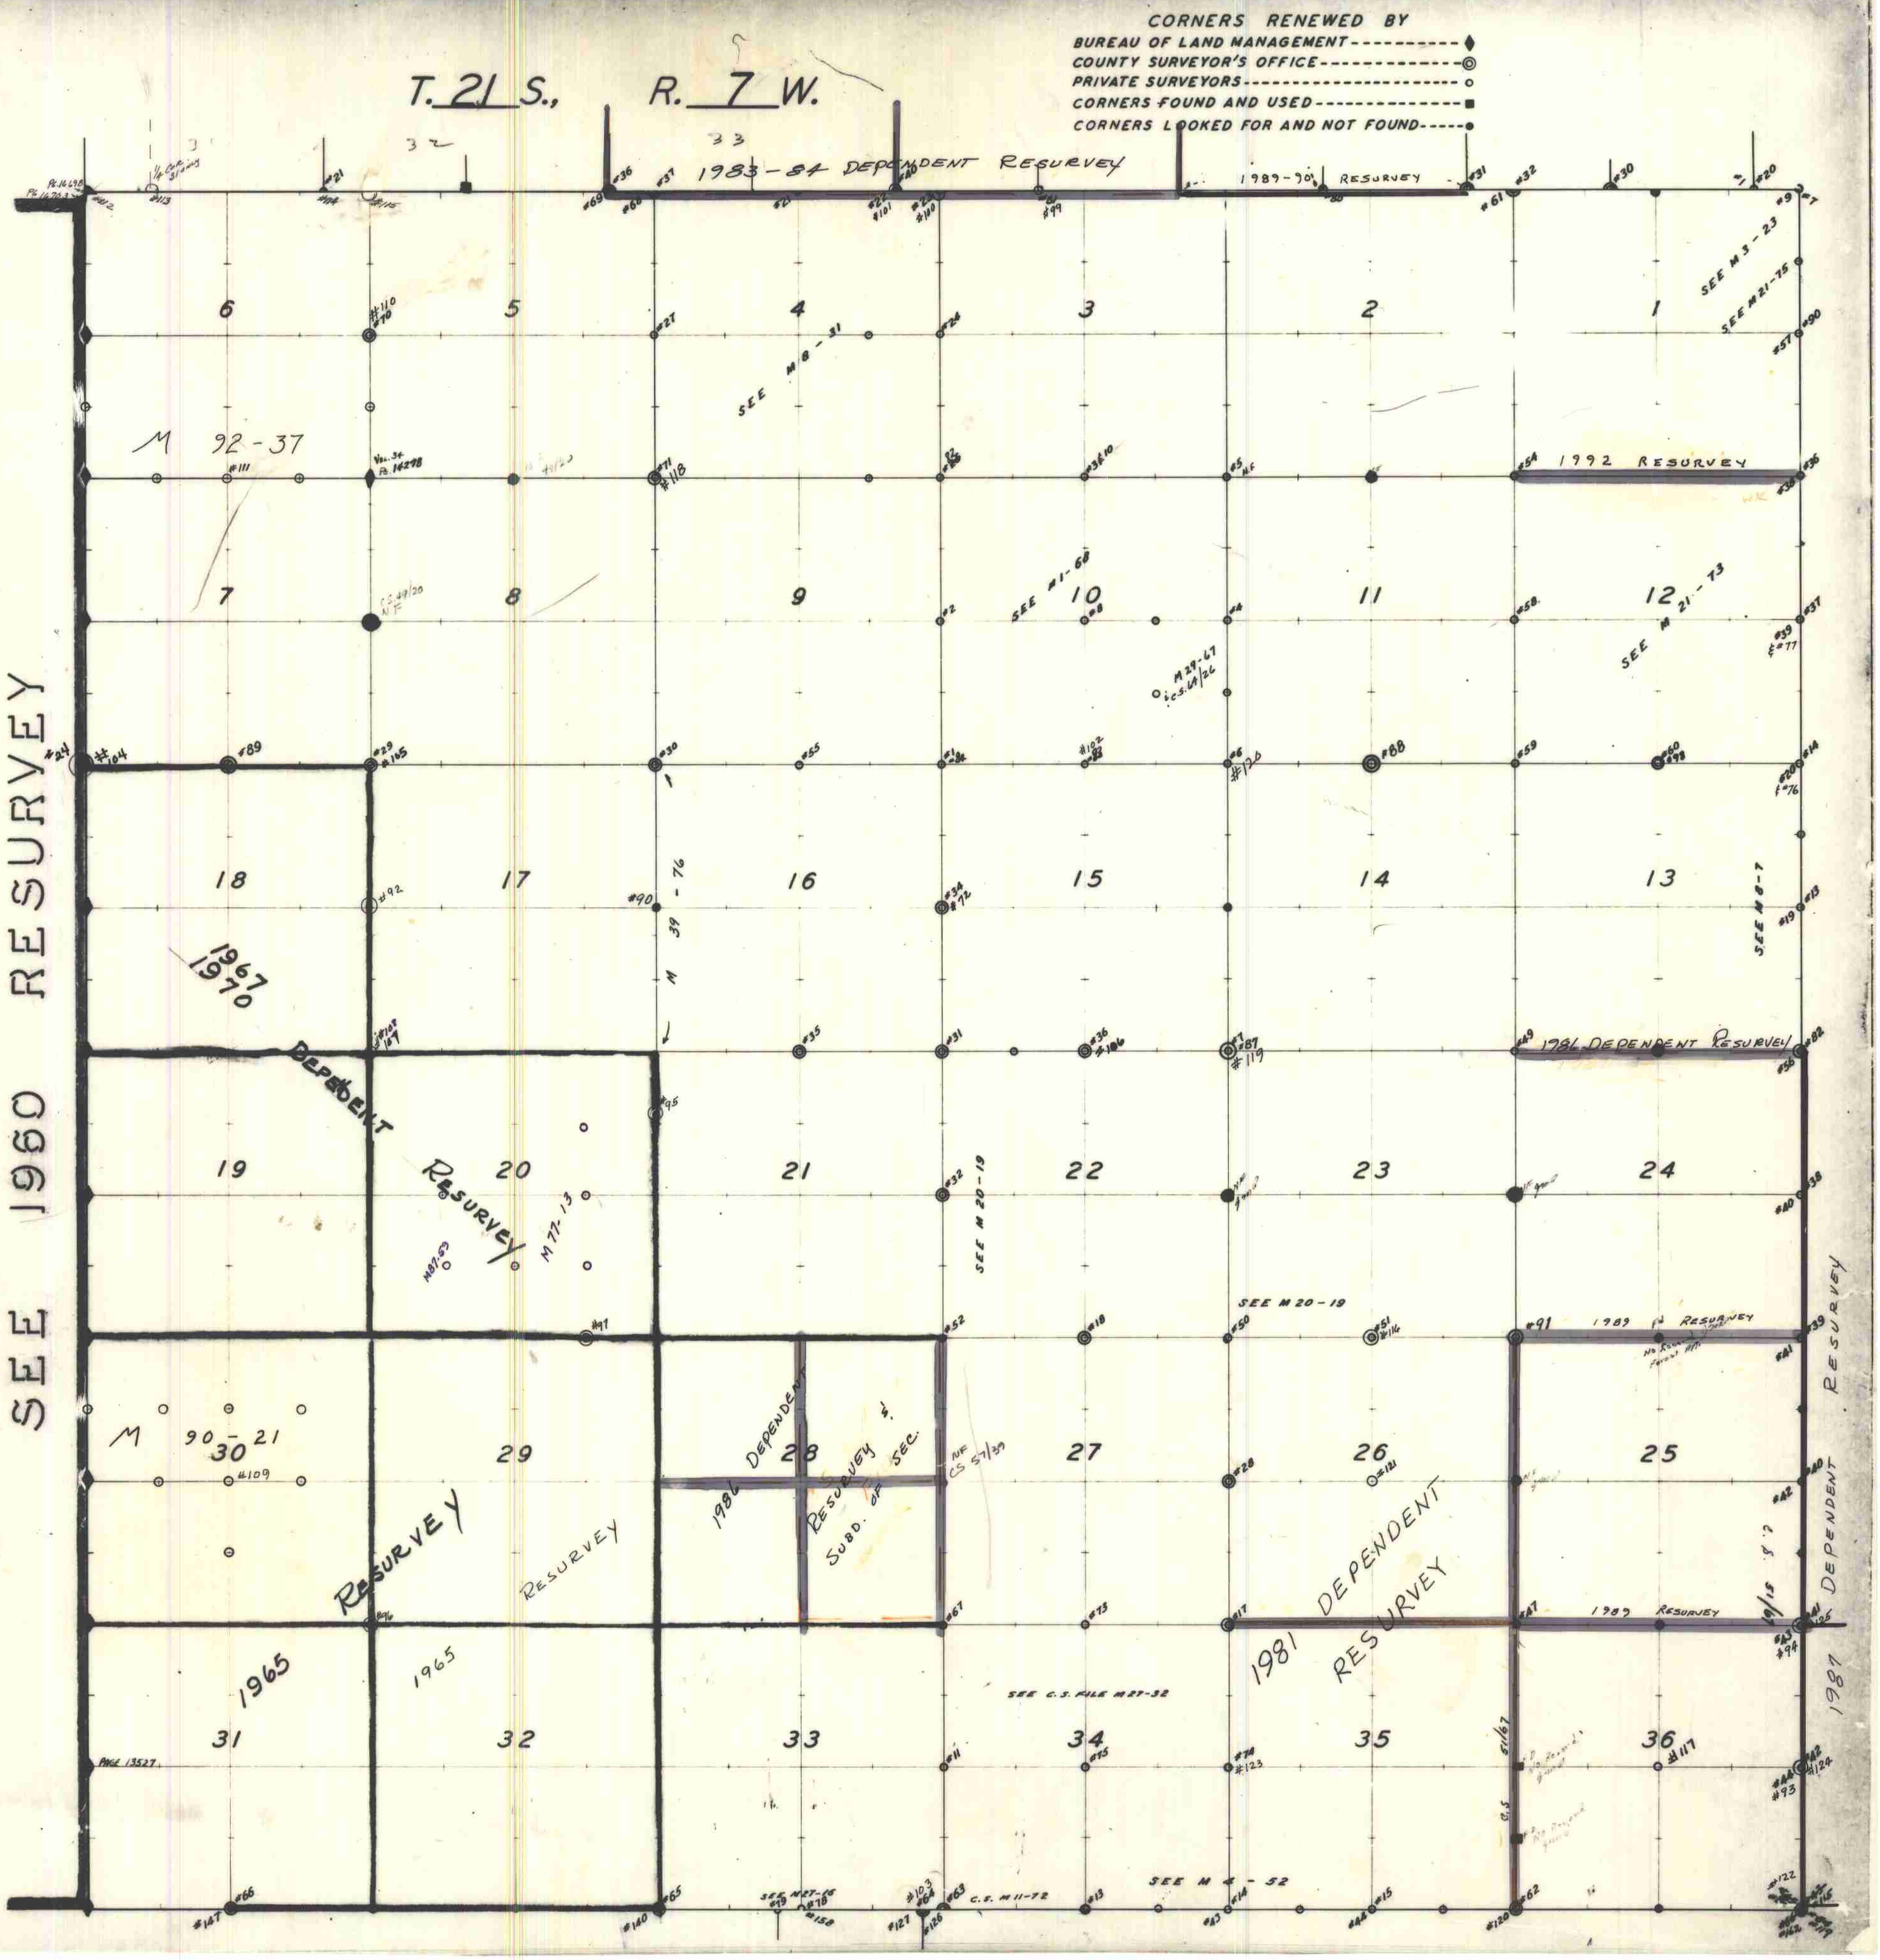
CORNERS RENEWED BY
BUREAU OF LAND MANAGEMENT
COUNTY SURVEYOR'S OFFICE
PRIVATE SURVEYORS
CORNERS FOUND AND USED
CORNERS LOOKED FOR AND NOT FOUND
T. 21 S., R. 7 W.
1983-84 DEPENDENT RESURVEY
1989-90 RESURVEY
1992 RESURVEY
SEE M 3-23
SEE M 21-75
SEE M 8-31
M 92-37
SEE M 1-68
SEE M 21-73
M 29-67
M 39-76
SEE M 8-7
1967
1970
1981 DEPENDENT RESURVEY
DEPENDENT
RESURVEY
M 77-13
SEE M 20-19
1989 RESURVEY
M 90-21
1986 DEPENDENT
RESURVEY
SUBD. OF SEC.
1981 DEPENDENT RESURVEY
1989 RESURVEY
1965
SEE C.S. FILE M 27-32
SEE M 4-52
C.S. M 11-72
RESURVEY
1987 DEPENDENT
RESURVEY
SEE RESURVEY
PAGE 13527