


T. 21 S., R. 9 W.

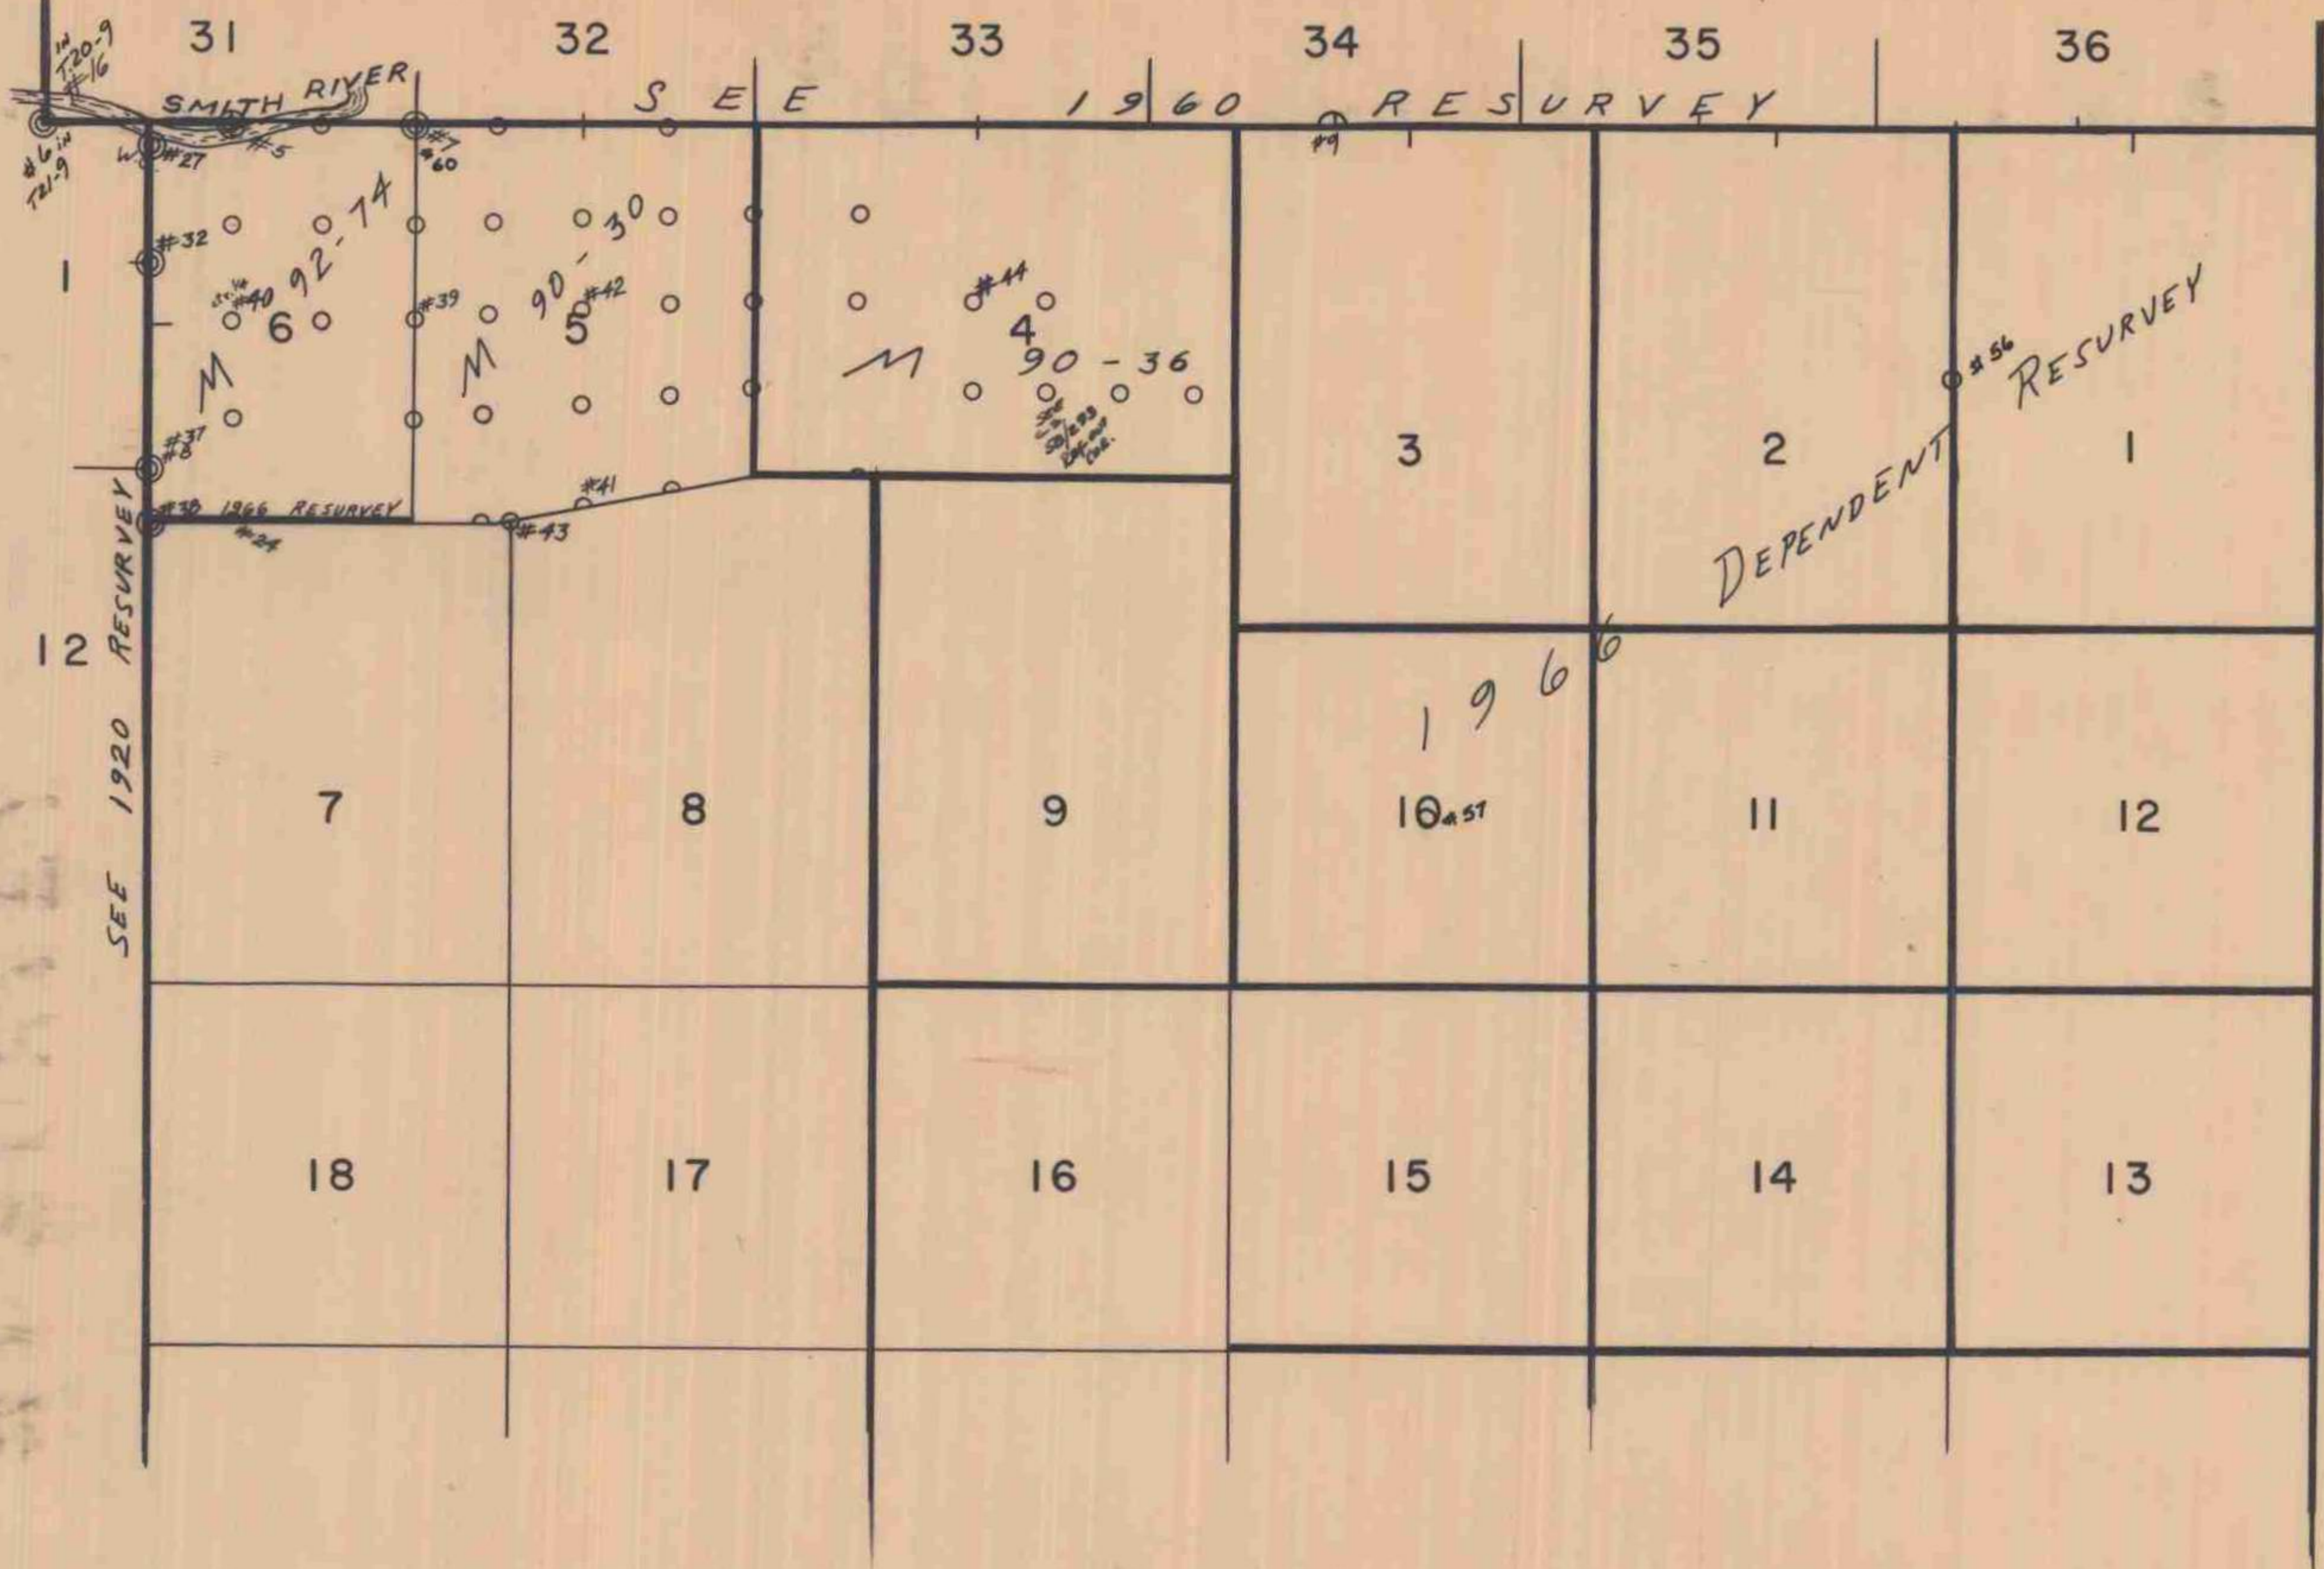

TNSP. 20 S.  
TNSP. 21 S.

SEE 1920 RESURVEY

DEPENDENT RESURVEY

31	32	33	34	35	36
1	2	3	4	5	6
7	8	9	10 <sup>1966</sup>	11	12
18	17	16	15	14	13