31

T. 23 S., R. 2 W.
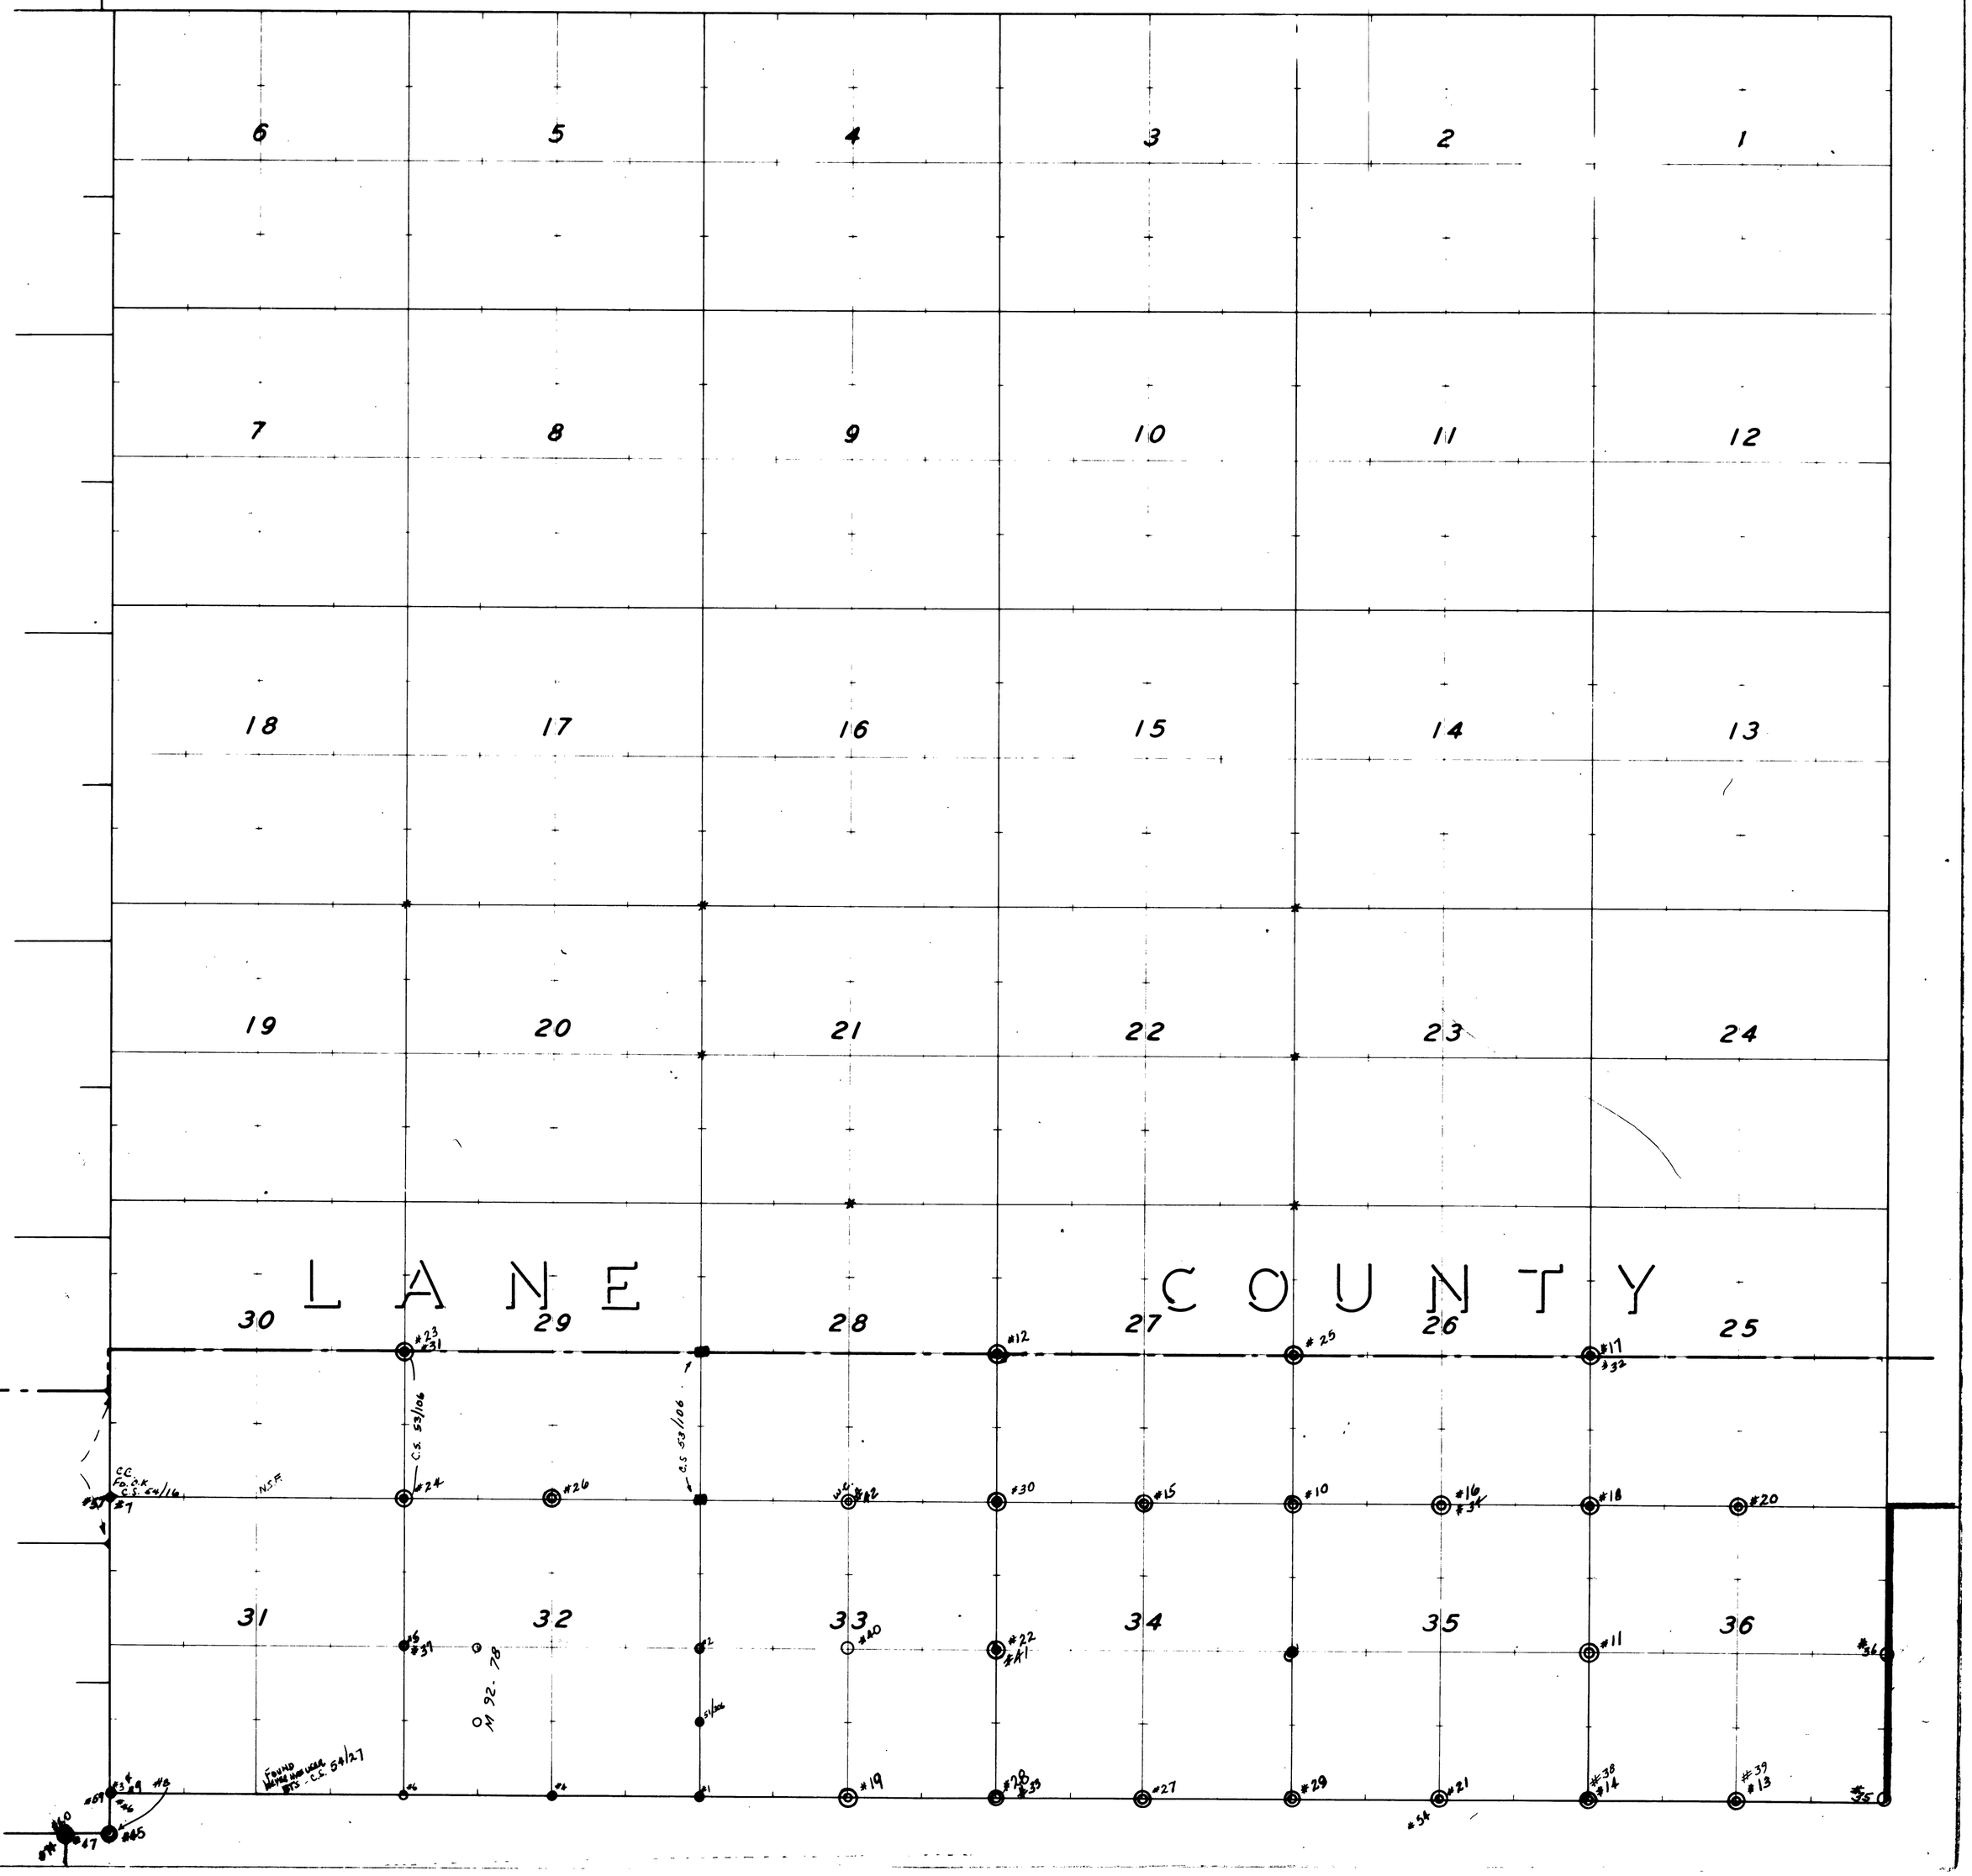
CORNERS RENEWED BY
BUREAU OF LAND MANAGEMENT ---------- ♦
COUNTY SURVEYOR'S OFFICE ---------- ◎
PRIVATE SURVEYORS ---------- ○
CORNERS FOUND AND USED ---------- ■
CORNERS LOOKED FOR AND NOT FOUND ----- ●
DATA BY LANE COUNTY SURVEYOR ---------- ✱ - See C.S. File No. 53/1