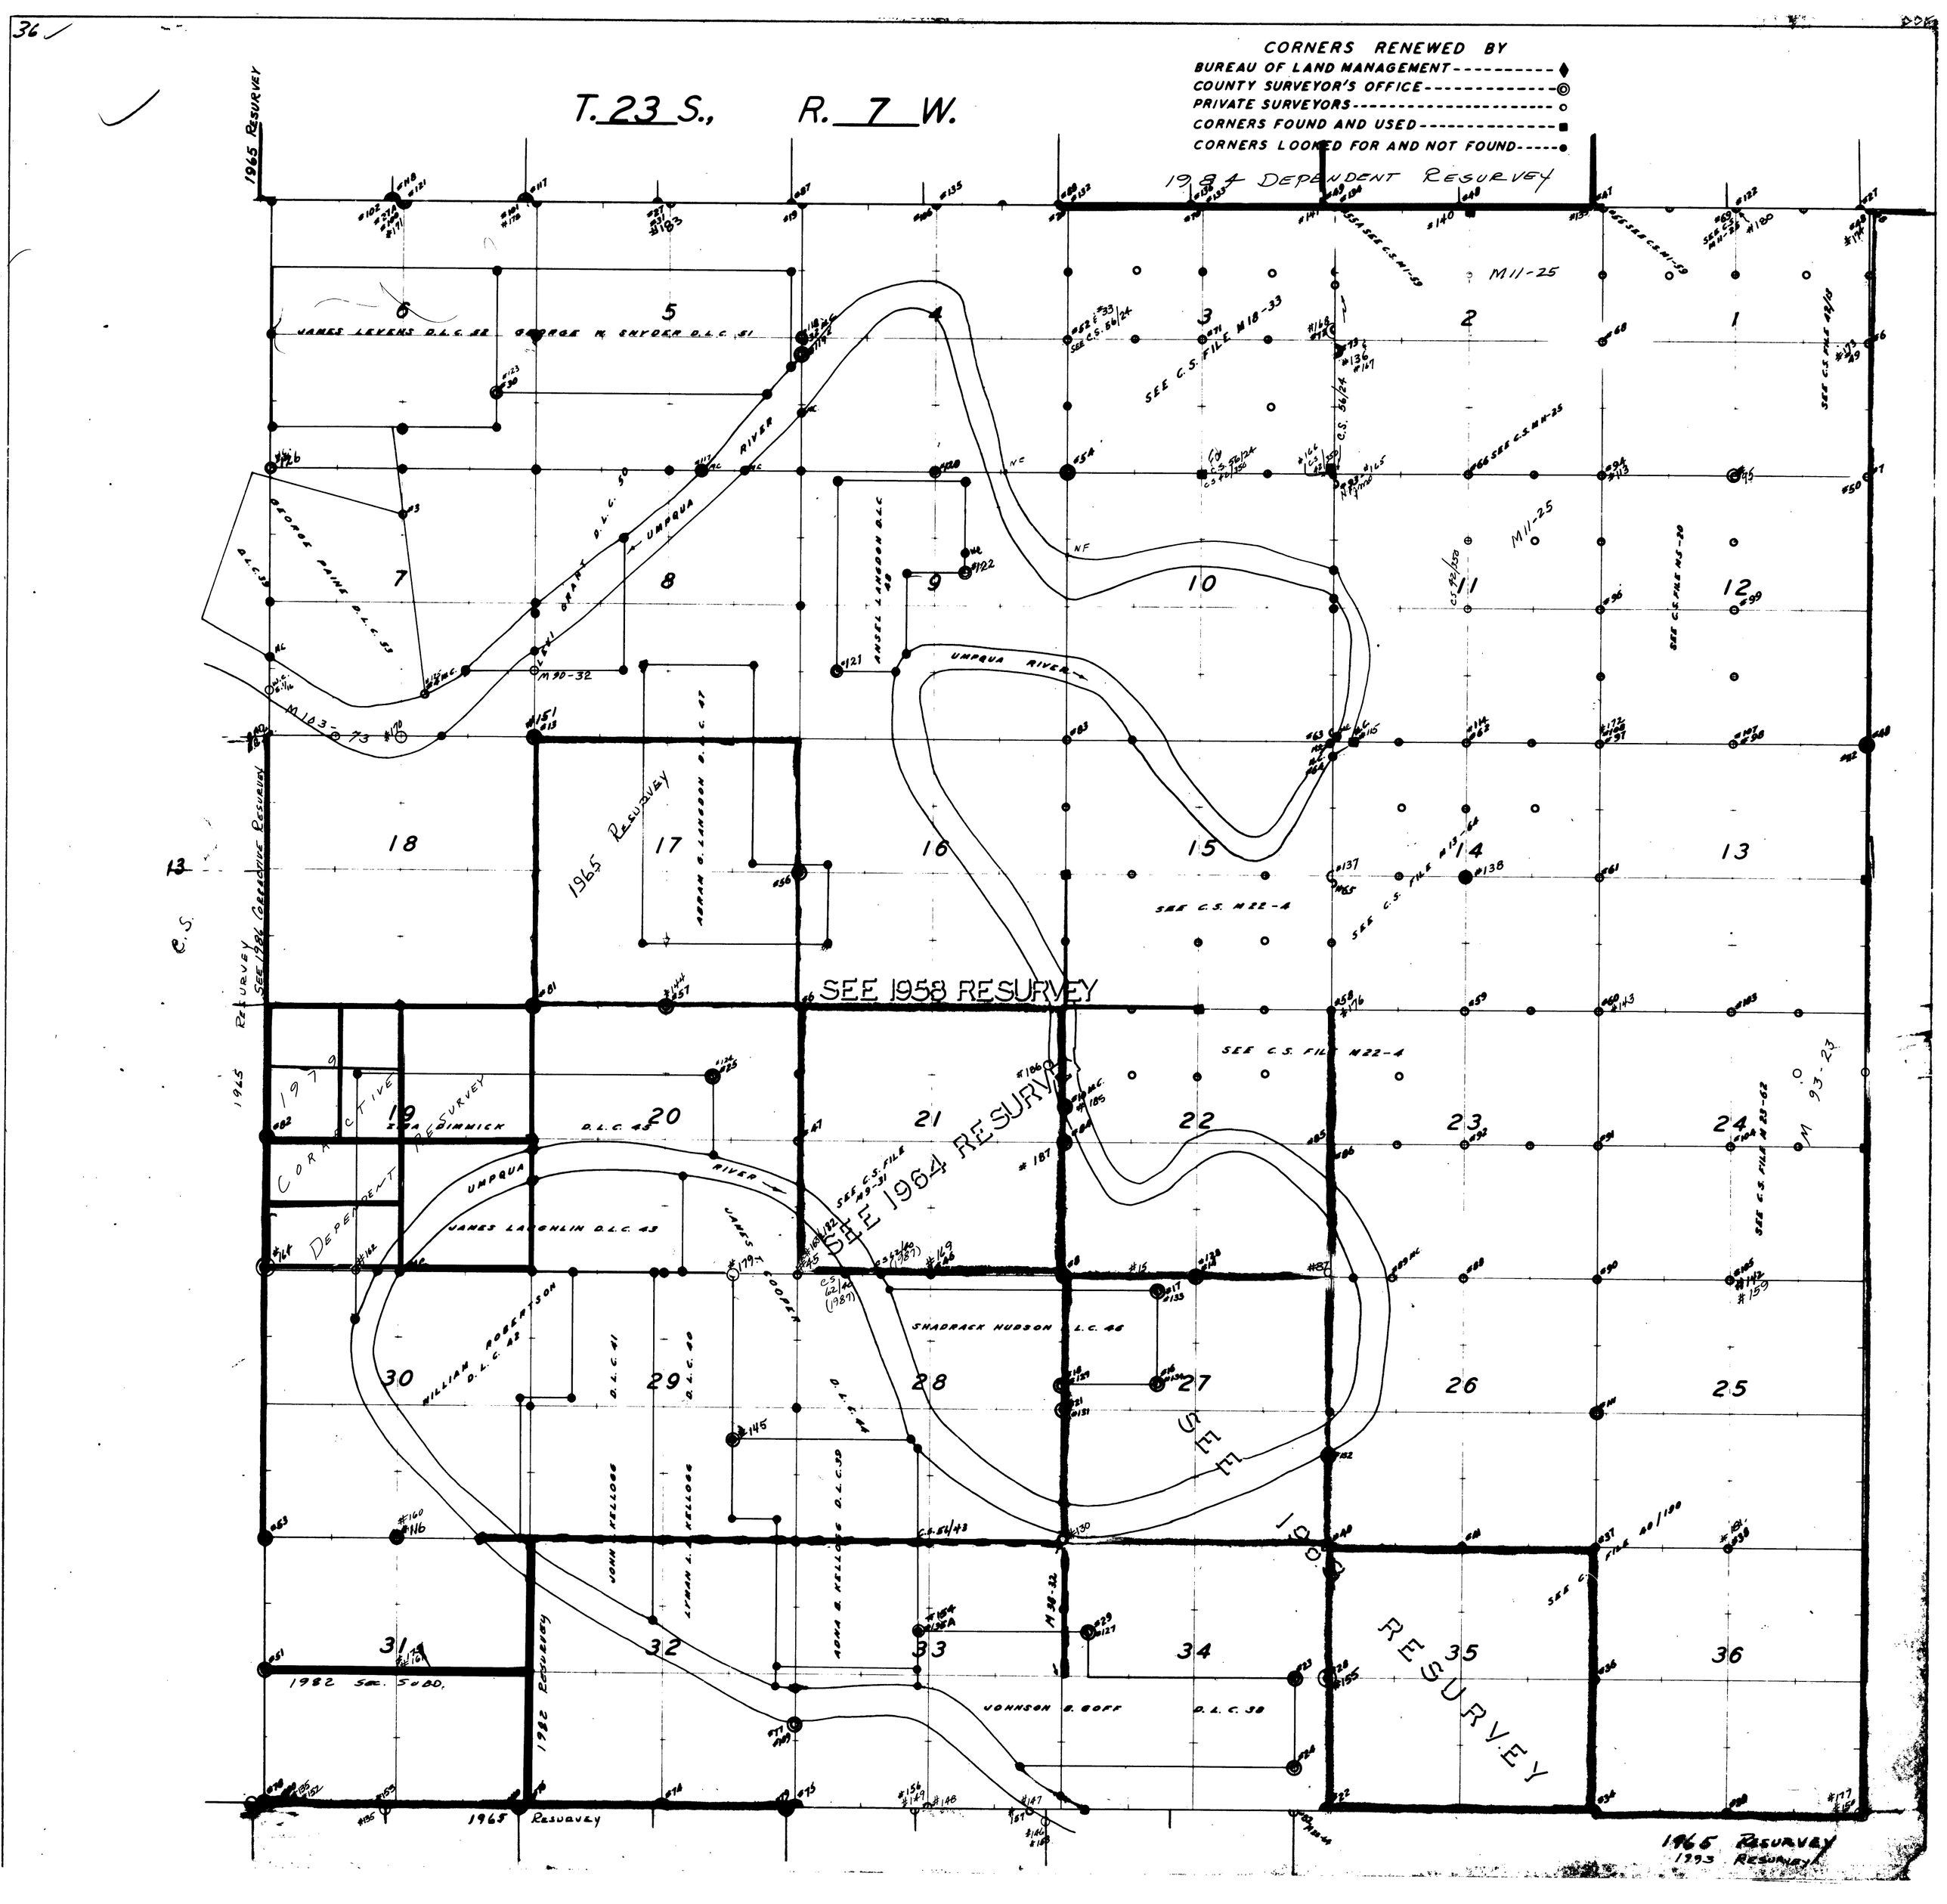

36
T. 23 S., R. 7 W.
CORNERS RENEWED BY
BUREAU OF LAND MANAGEMENT
COUNTY SURVEYOR'S OFFICE
PRIVATE SURVEYORS
CORNERS FOUND AND USED
CORNERS LOOKED FOR AND NOT FOUND
1984 DEPENDENT RESURVEY
1965 RESURVEY
JAMES LEVENS D.L.C. 52
GEORGE W. SNYDER D.L.C. 51
GEORGE PAINE D.L.C. 53
UMPQUA RIVER
ANSEL LANGDON D.L.C. 48
ABRAM G. LANGDON D.L.C. 47
SEE C.S. FILE M18-33
SEE C.S. M22-4
SEE C.S. FILE M22-4
SEE 1958 RESURVEY
SEE 1964 RESURVEY
SEE 1979 CORRECTIVE DEPENDENT RESURVEY
ZIMA DIMMICK D.L.C. 45
JAMES LAUGHLIN D.L.C. 43
WILLIAM ROBERTSON D.L.C. 42
JAMES COOPER D.L.C. 44
SHADRACK HUDSON D.L.C. 46
JOHN KELLOGG D.L.C. 41
LYMAN L. KELLOGG D.L.C. 40
ADNA B. KELLOGG D.L.C. 39
JOHNSON B. GOFF D.L.C. 38
1982 SEC. SUBD.
1982 RESURVEY
1965 RESURVEY
1993 RESURVEY