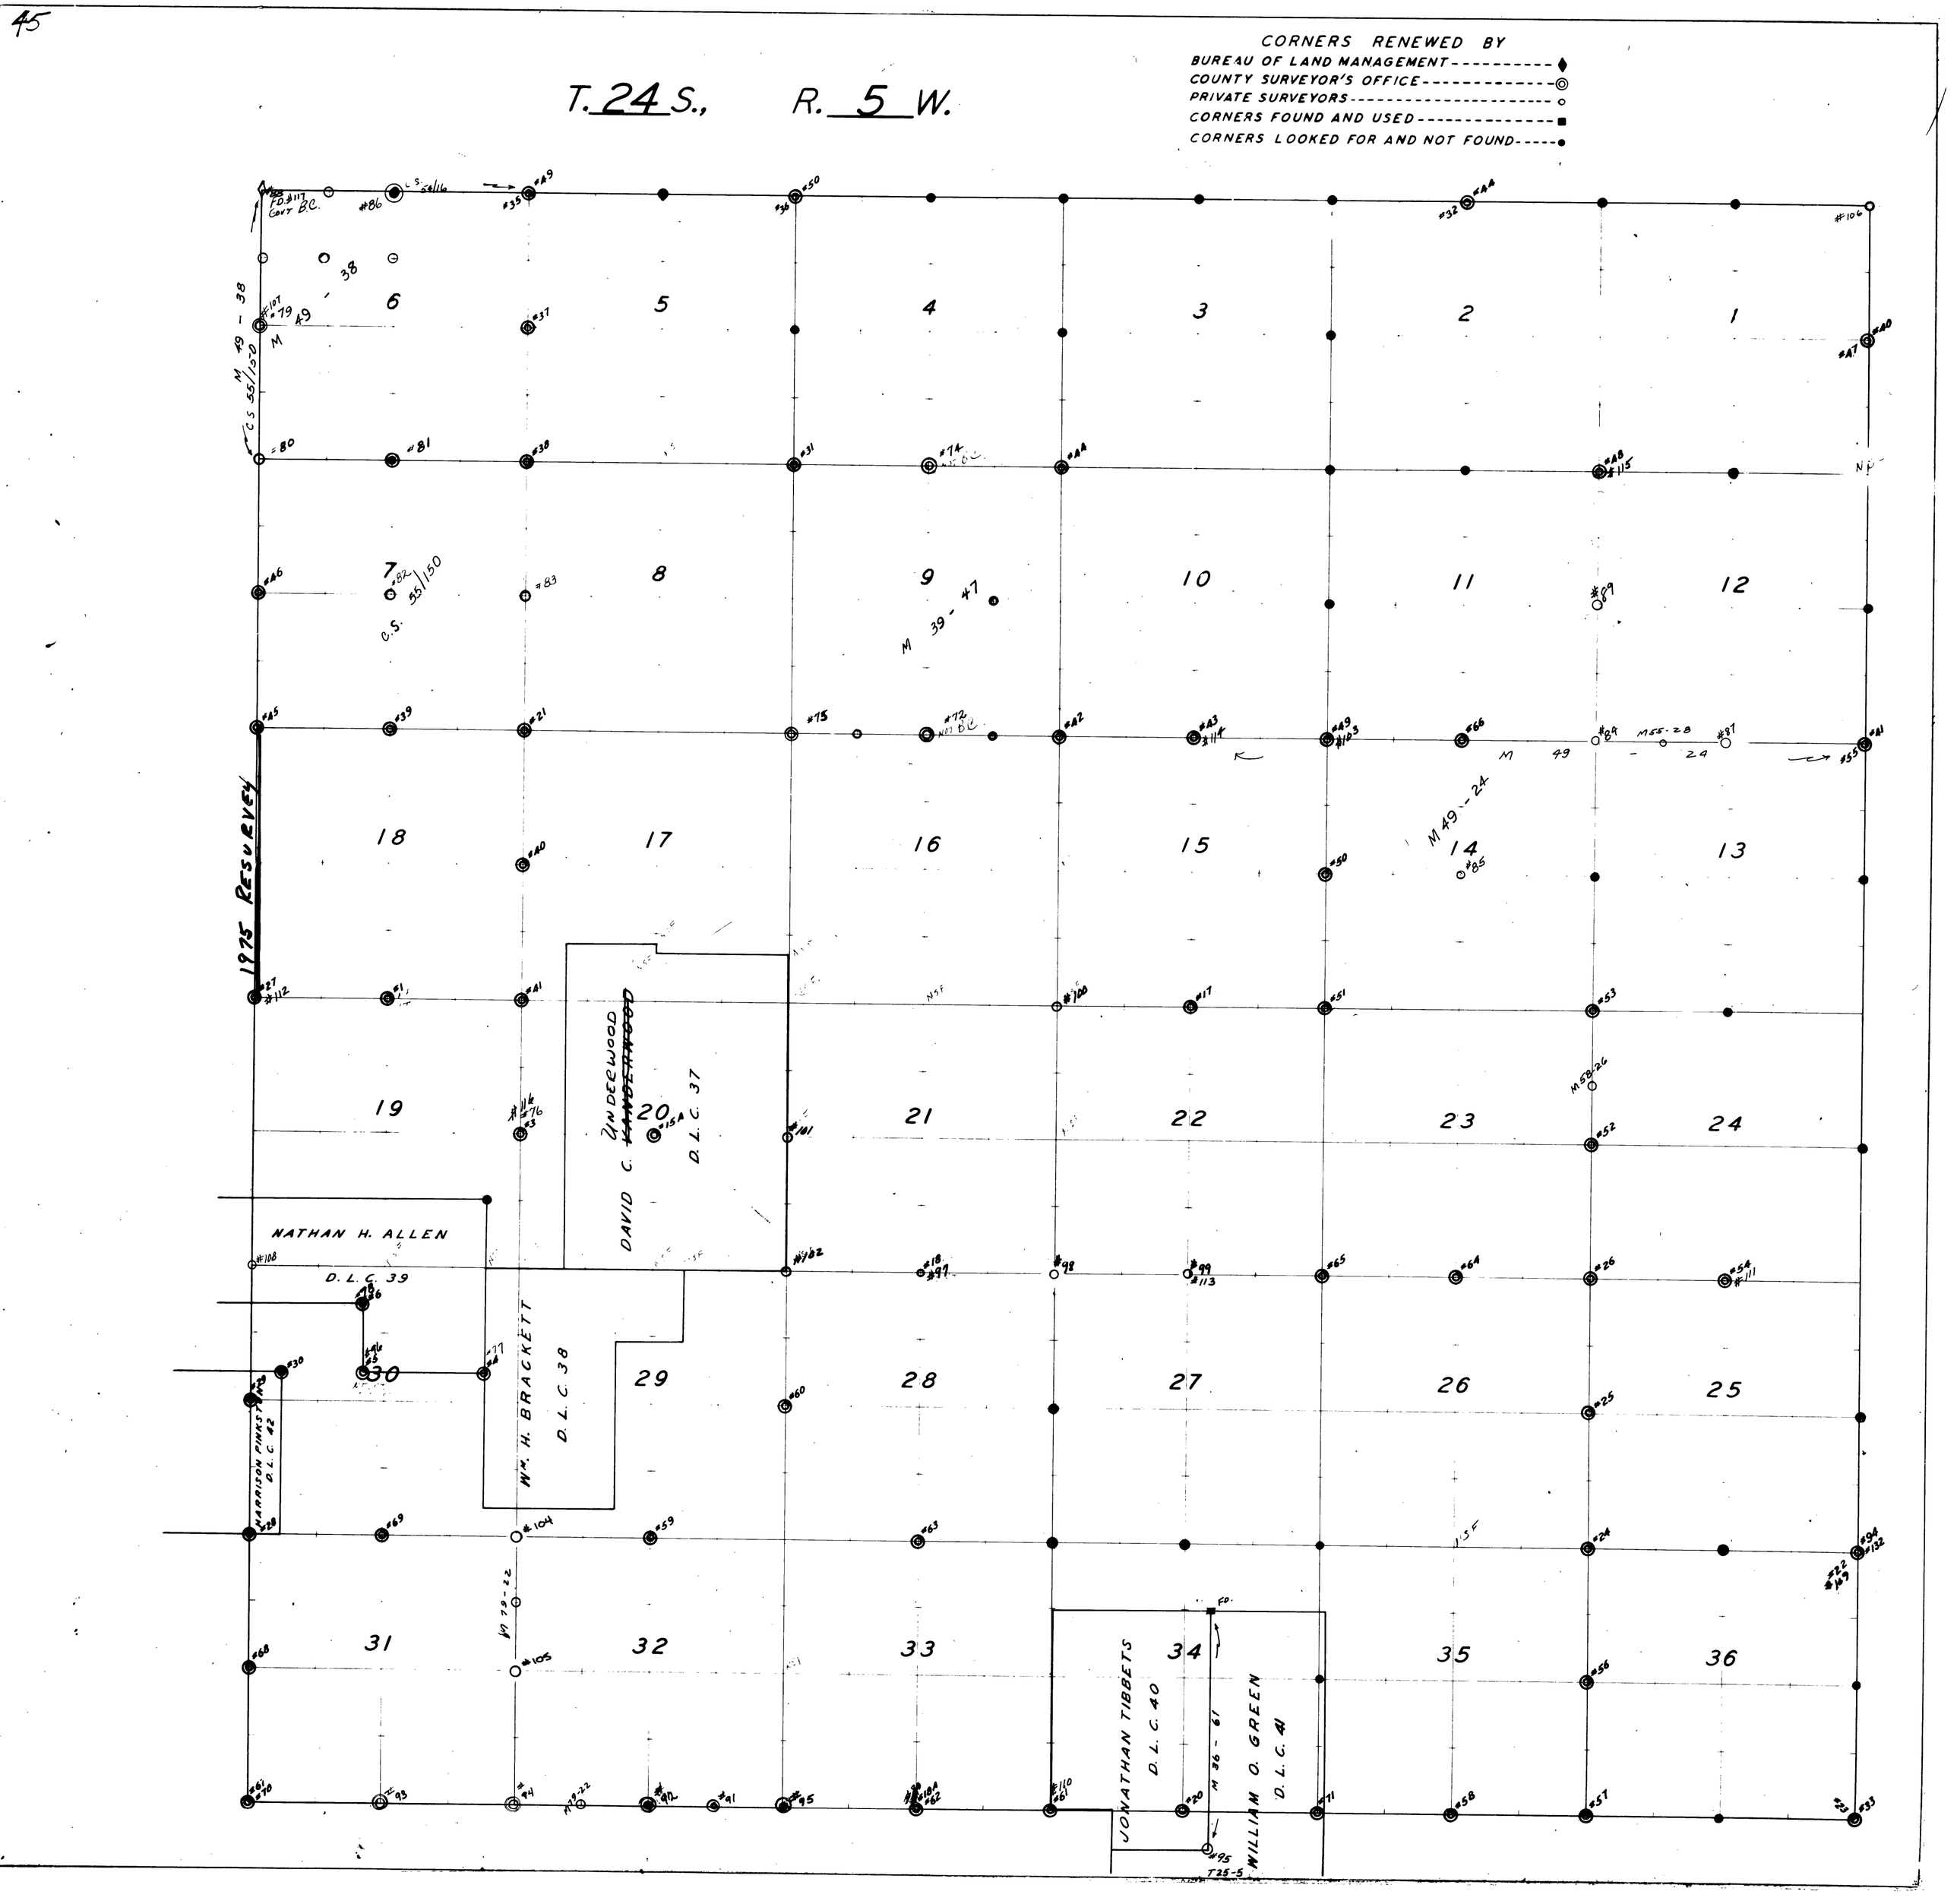
T. 24 S., R. 5 W.
CORNERS RENEWED BY
BUREAU OF LAND MANAGEMENT
COUNTY SURVEYOR'S OFFICE
PRIVATE SURVEYORS
CORNERS FOUND AND USED
CORNERS LOOKED FOR AND NOT FOUND
1975 RESURVEY
NATHAN H. ALLEN
D. L. C. 39
DAVID C. UNDERWOOD
D. L. C. 37
WM. H. BRACKETT
D. L. C. 38
HARRISON PINKSTON
D. L. C. 42
JONATHAN TIBBETS
D. L. C. 40
WILLIAM O. GREEN
D. L. C. 41
M 49 - 38
M 39 - 47
M 49 - 24
M 36 - 61
M 79 - 22
T25-5