T. 24 S., R. 8 W.
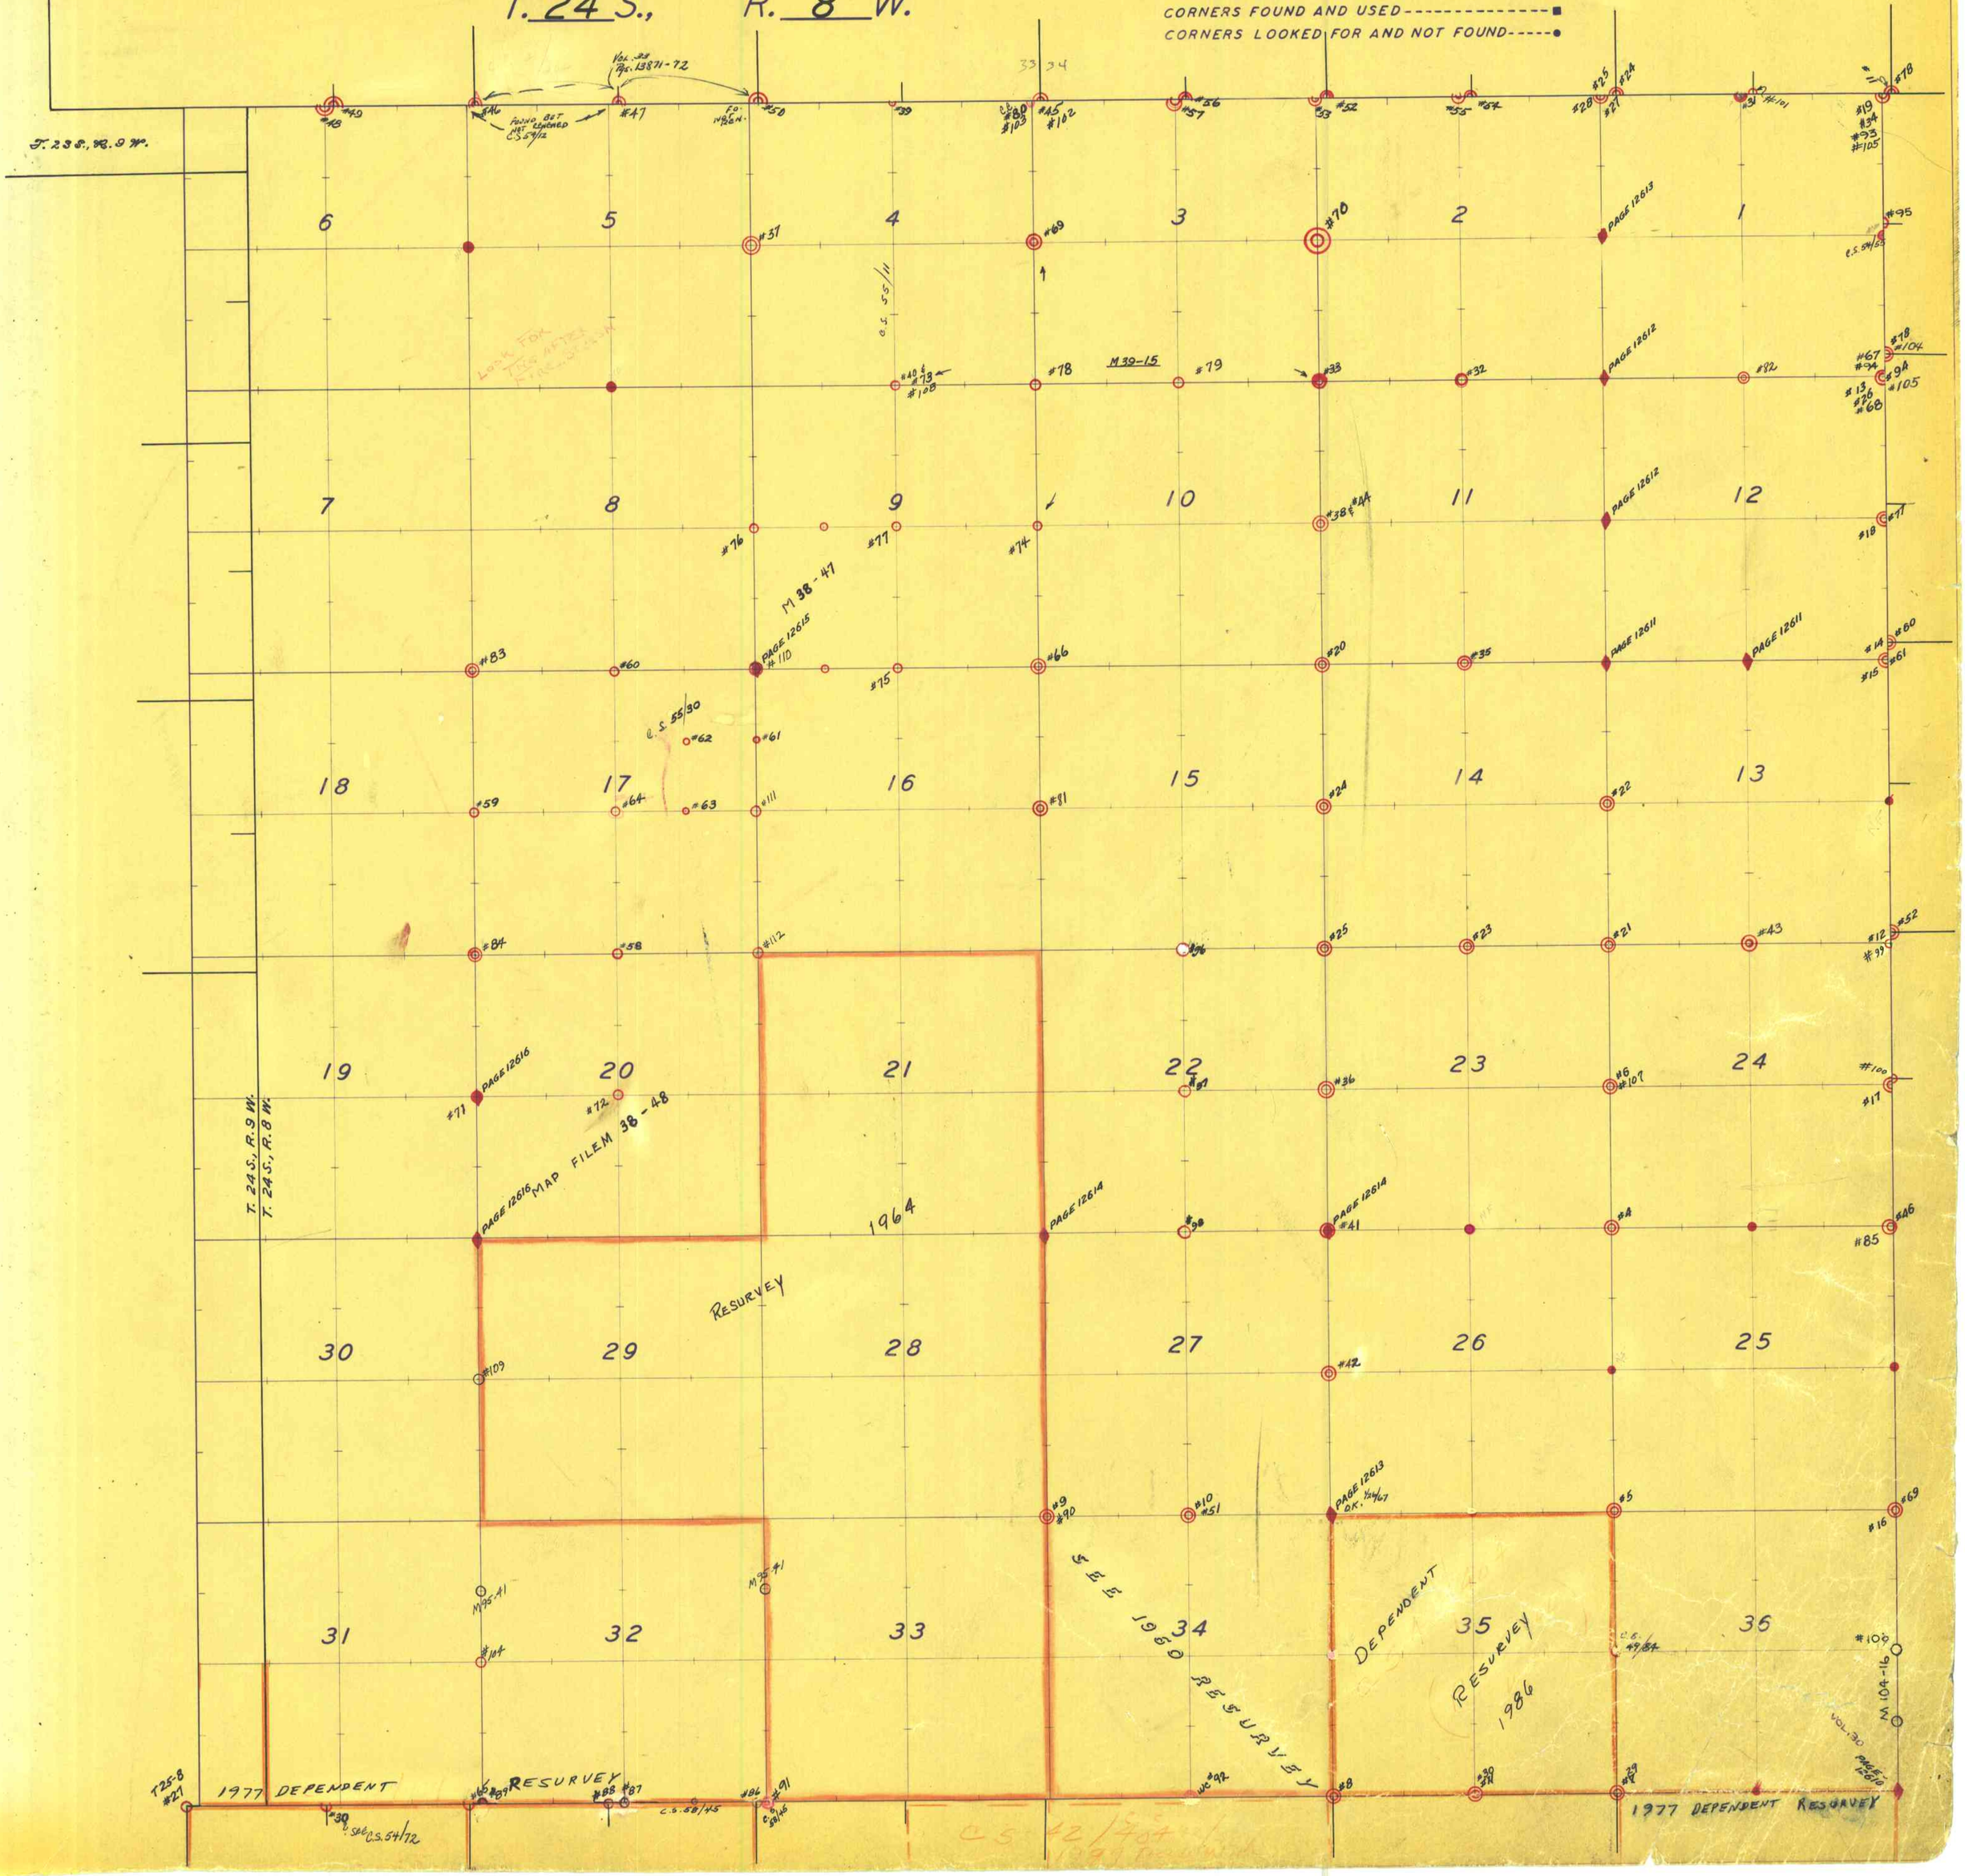
CORNERS RENEWED BY
BUREAU OF LAND MANAGEMENT ----------
COUNTY SURVEYOR'S OFFICE ----------
PRIVATE SURVEYORS ----------
CORNERS FOUND AND USED ----------
CORNERS LOOKED FOR AND NOT FOUND -----