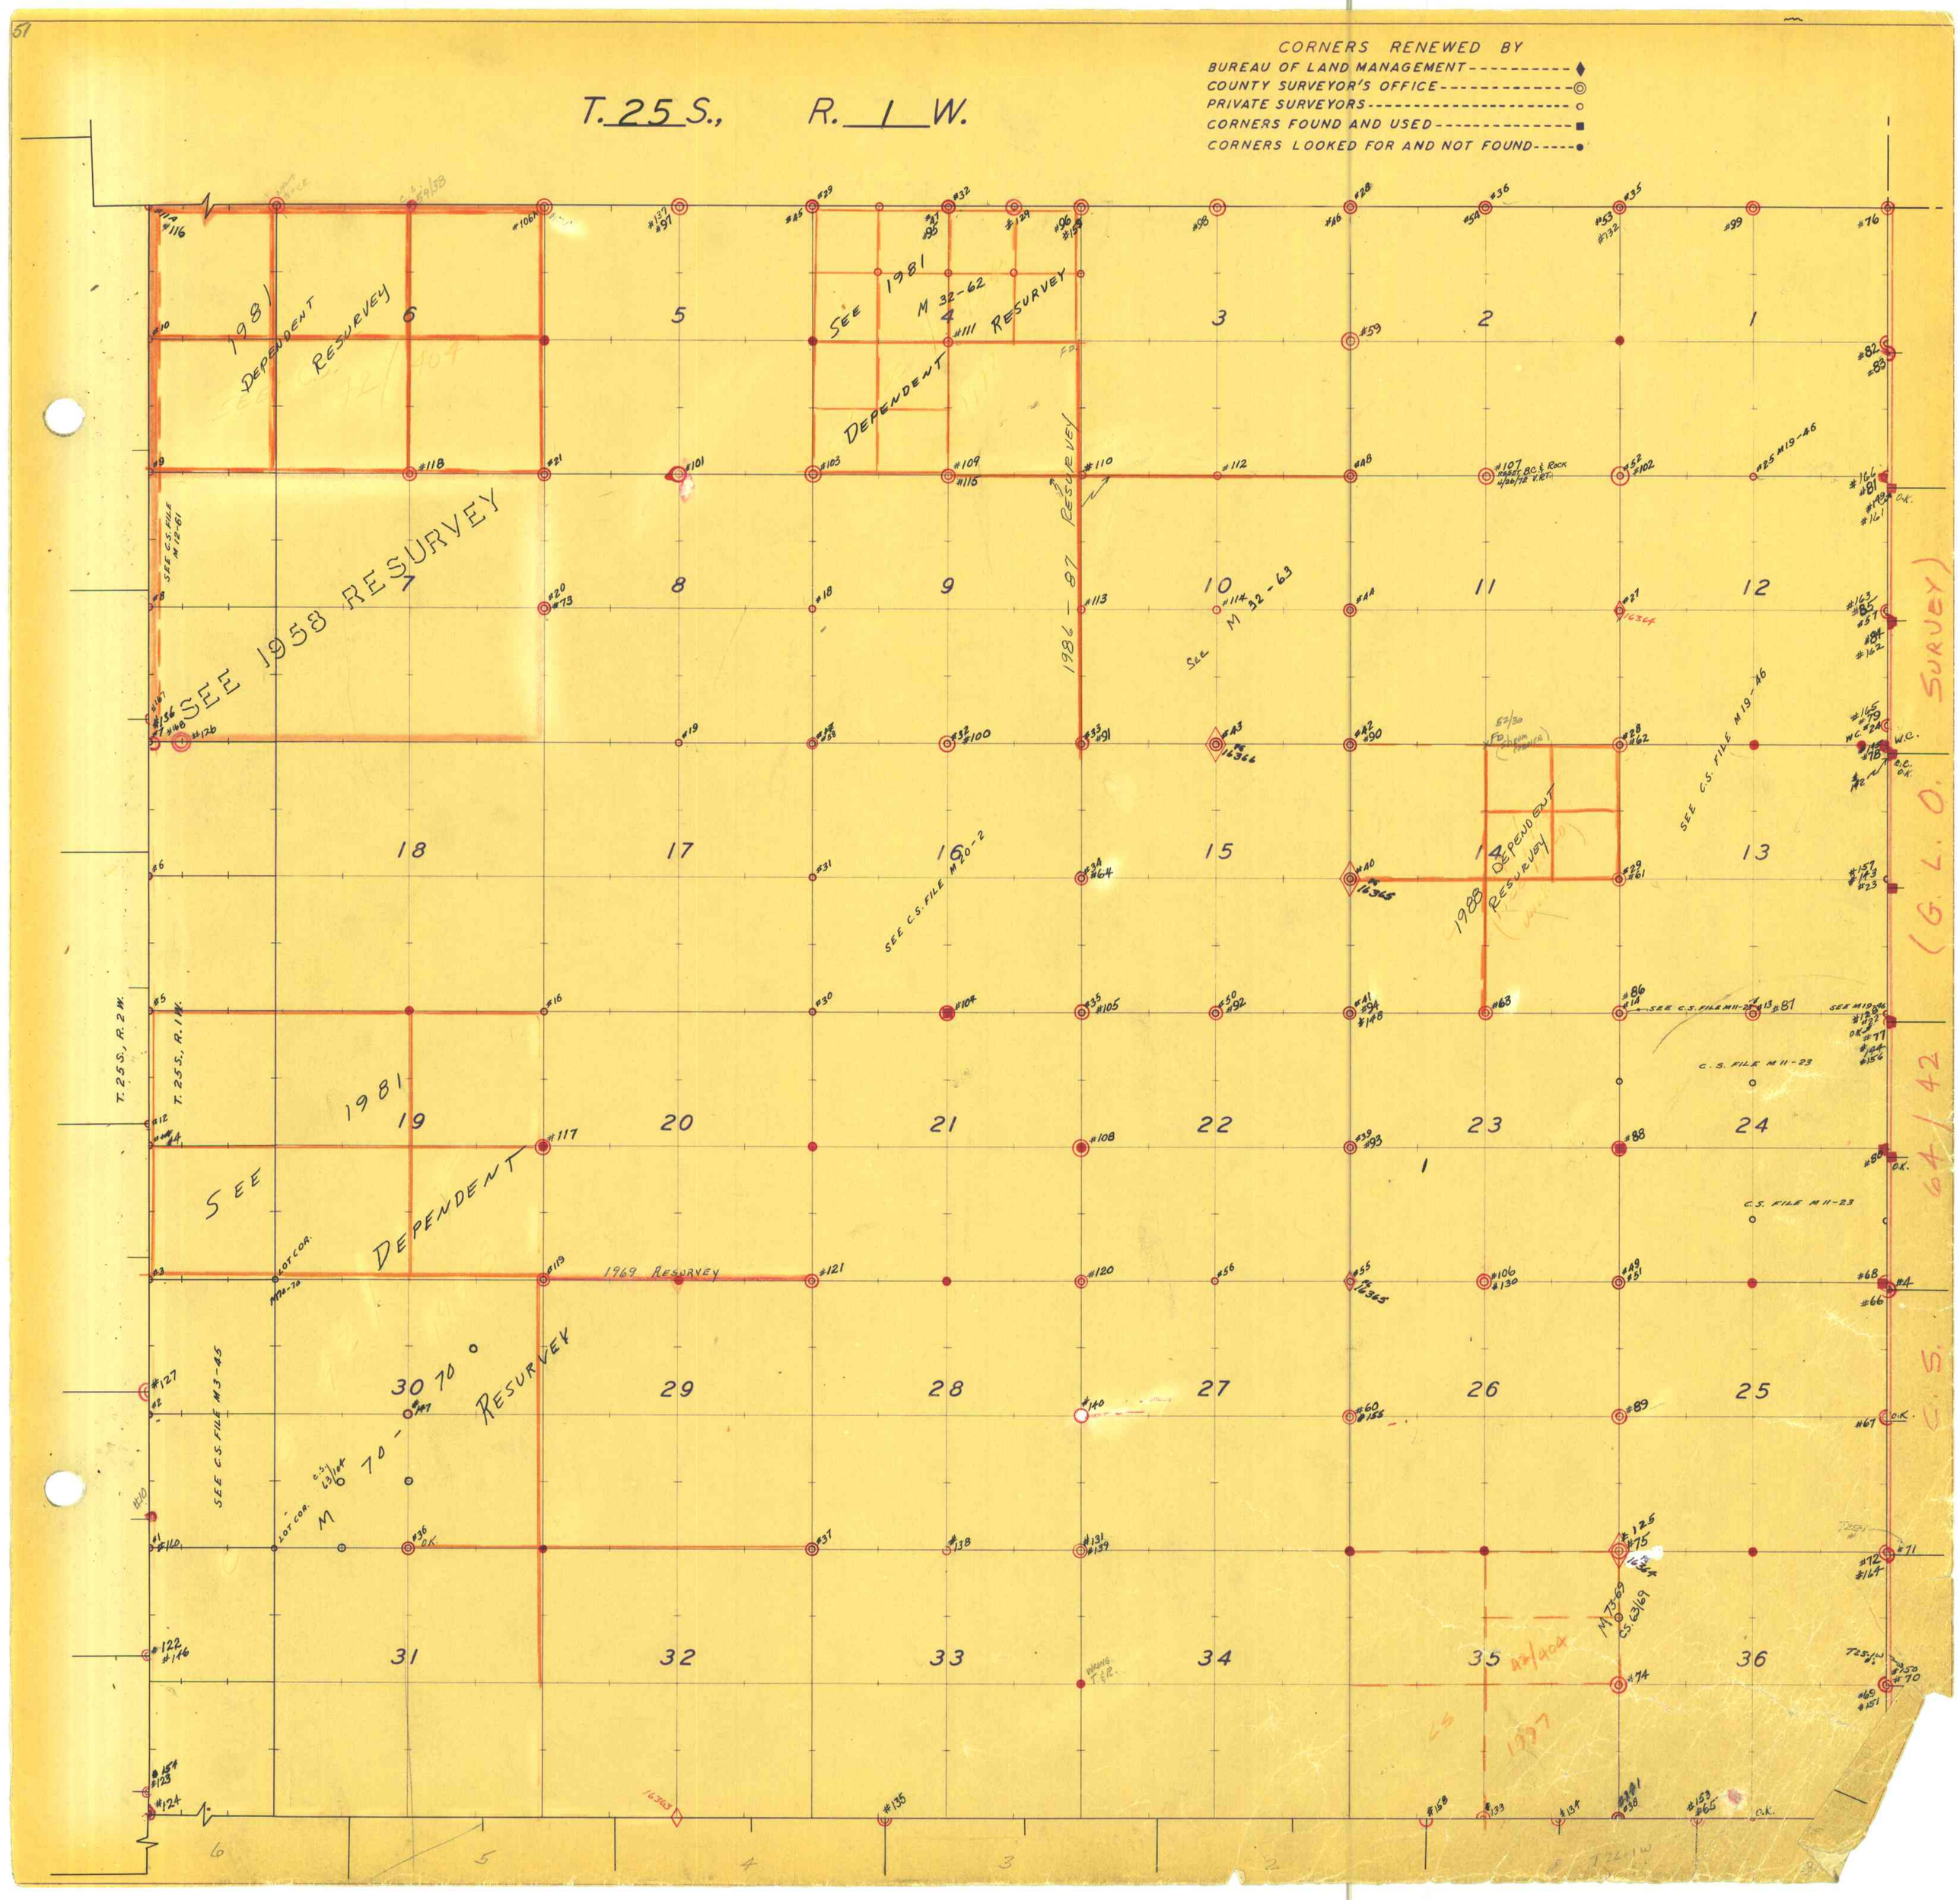
T. 25 S., R. 1 W.
CORNERS RENEWED BY
BUREAU OF LAND MANAGEMENT
COUNTY SURVEYOR'S OFFICE
PRIVATE SURVEYORS
CORNERS FOUND AND USED
CORNERS LOOKED FOR AND NOT FOUND
1981 DEPENDENT RESURVEY
SEE 1981 M 32-62 DEPENDENT RESURVEY
SEE 1958 RESURVEY
1986-87 RESURVEY
M 32-63
SEE C.S. FILE M 12-61
SEE C.S. FILE M 19-46
SEE C.S. FILE M 20-2
1988 DEPENDENT RESURVEY
T. 25 S., R. 2 W.
T. 25 S., R. 1 W.
SEE 1981 DEPENDENT
1969 RESURVEY
M 70-70 RESURVEY
SEE C.S. FILE M 3-45
M 73-69
C.S. 63/69
C.S. FILE M 11-23
(G. L. O. SURVEY)
C.S. 64/42