


T. 25 S., R. 2 W.

CORNERS RENEWED BY  
 BUREAU OF LAND MANAGEMENT -----  
 COUNTY SURVEYOR'S OFFICE -----  
 PRIVATE SURVEYORS -----  
 CORNERS FOUND AND USED -----  
 CORNERS LOOKED FOR AND NOT FOUND -----

SEE NEXT PAGE FOR 1964 RESURVEY

1964 RESURVEY

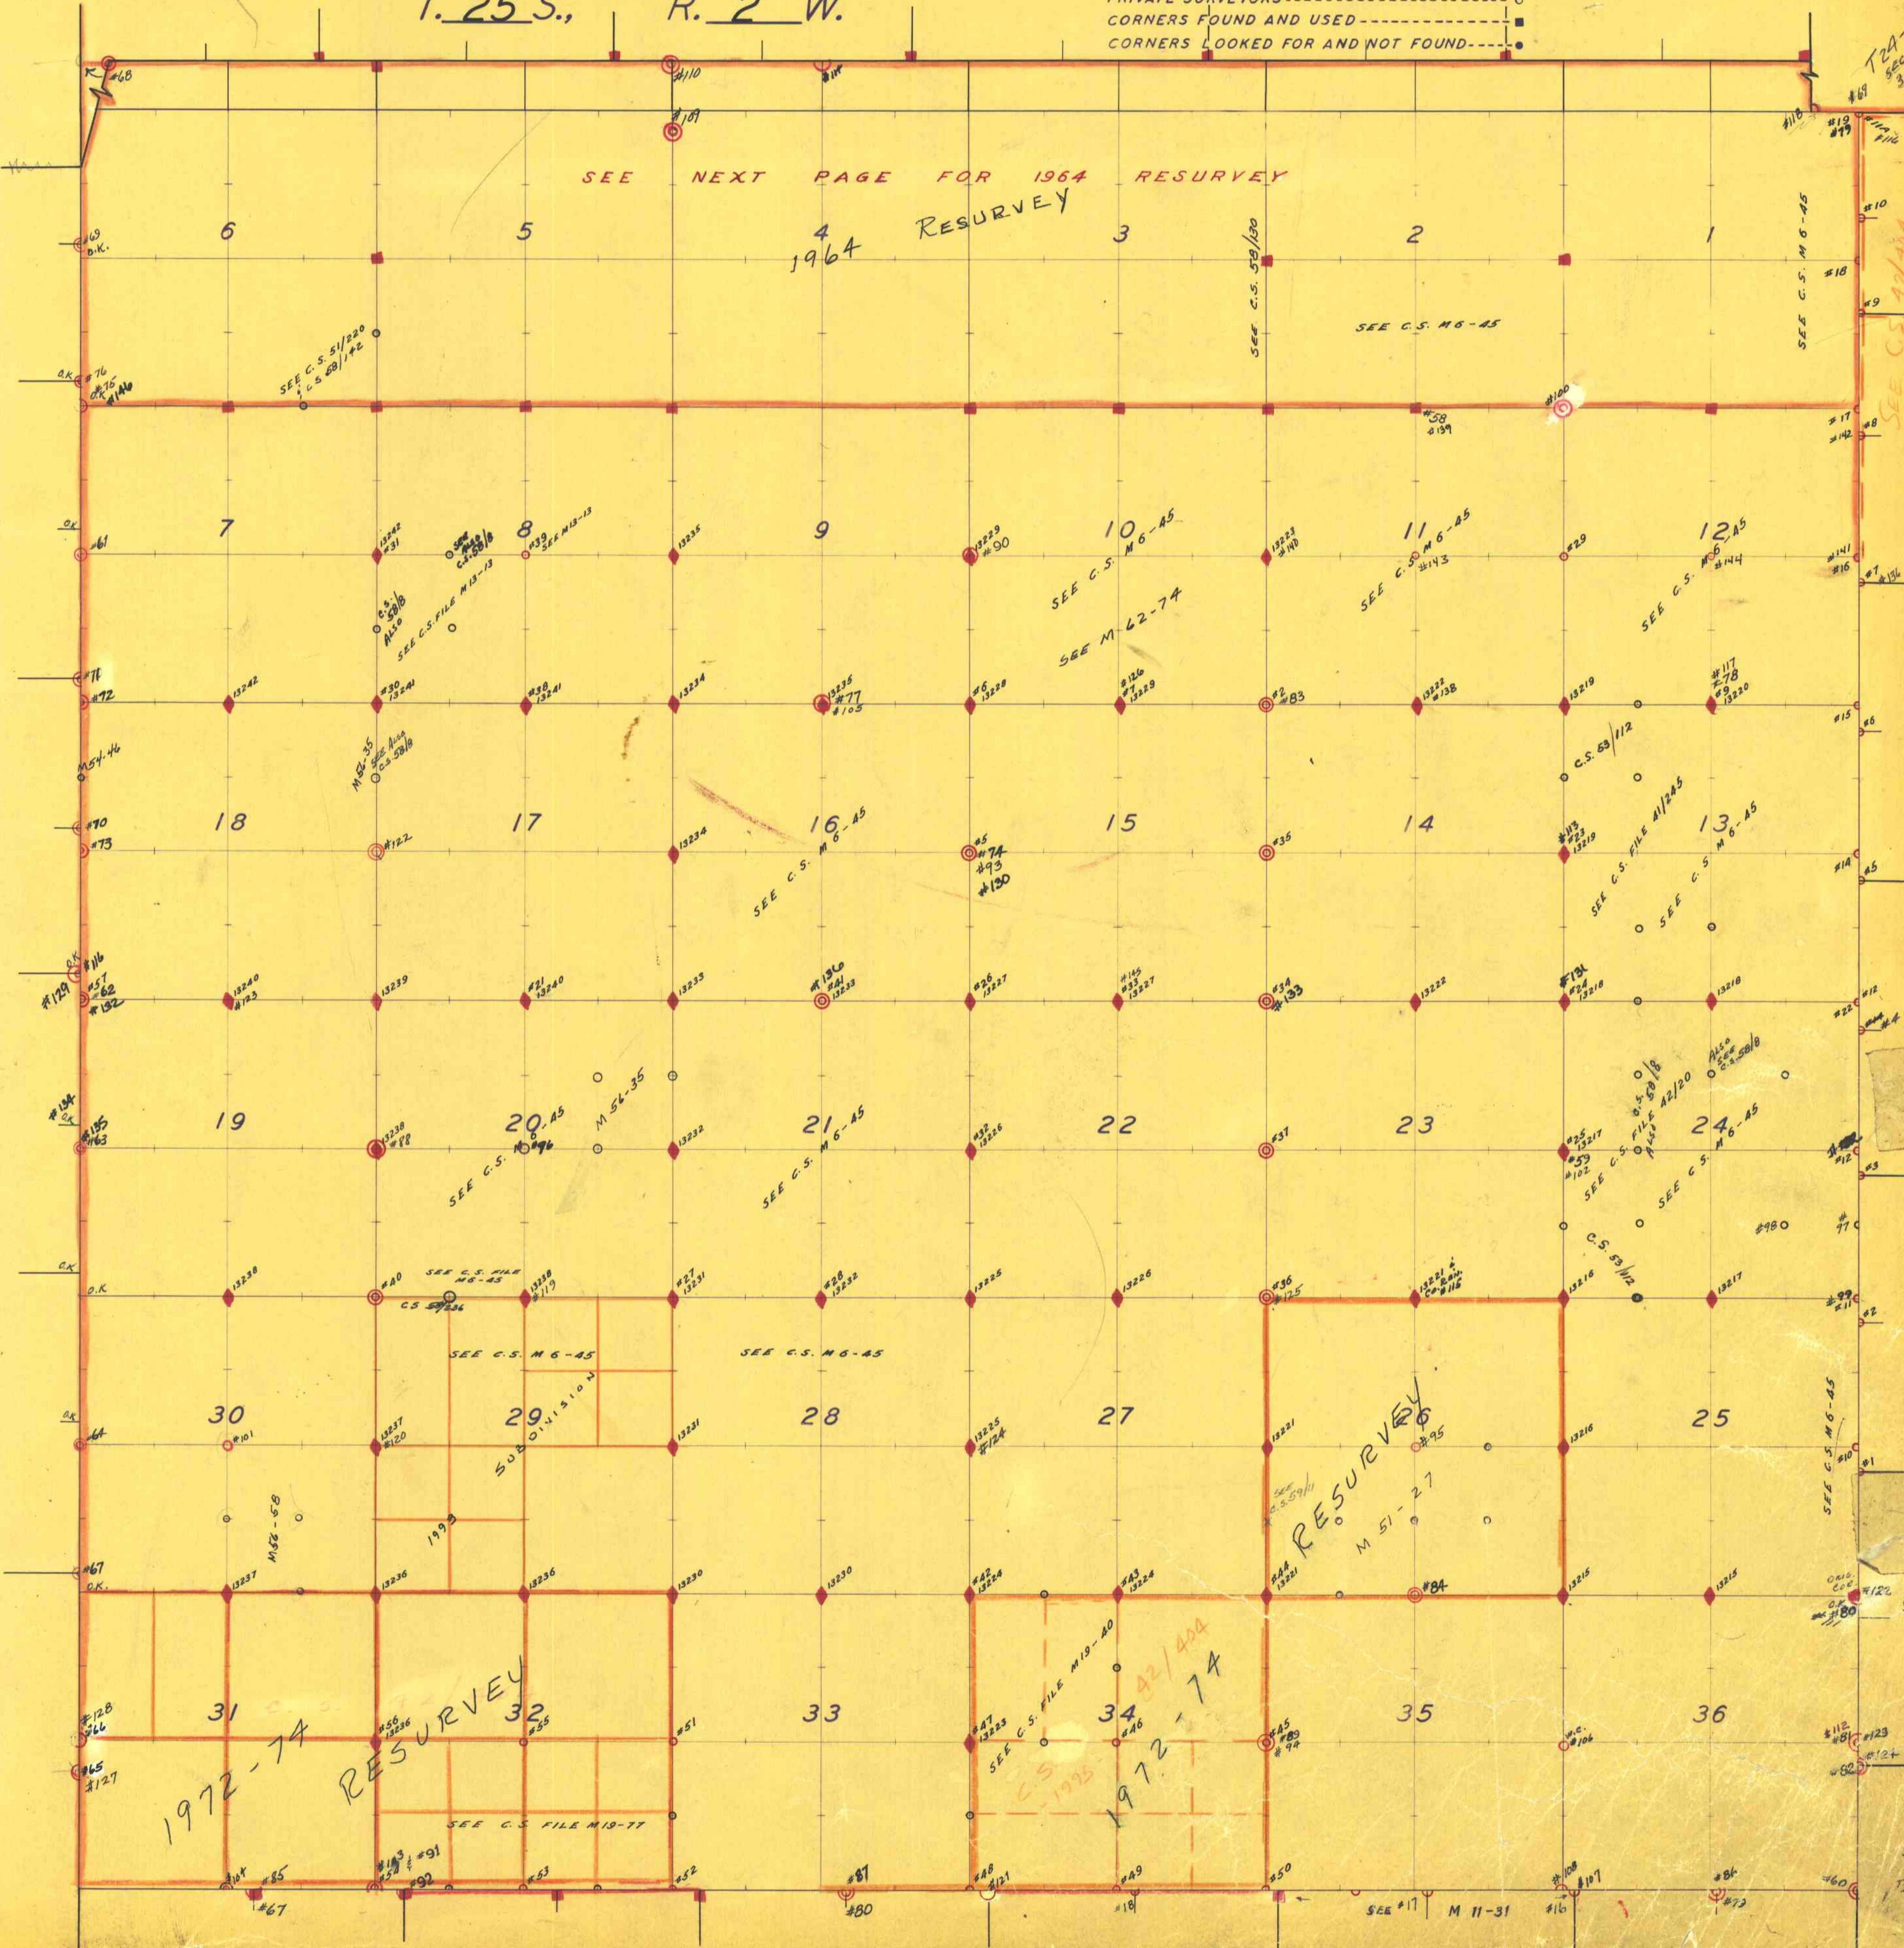

1972-74 RESURVEY

RESURVEY

1972-74 RESURVEY

T2A-1

SEE C.S. M 6-45

SEE C.S. M 6-45

SEE C.S. M 6-45

SEE C.S. M 6-45

SEE C.S. M 6-45

SEE C.S. M 6-45

#68

#69

