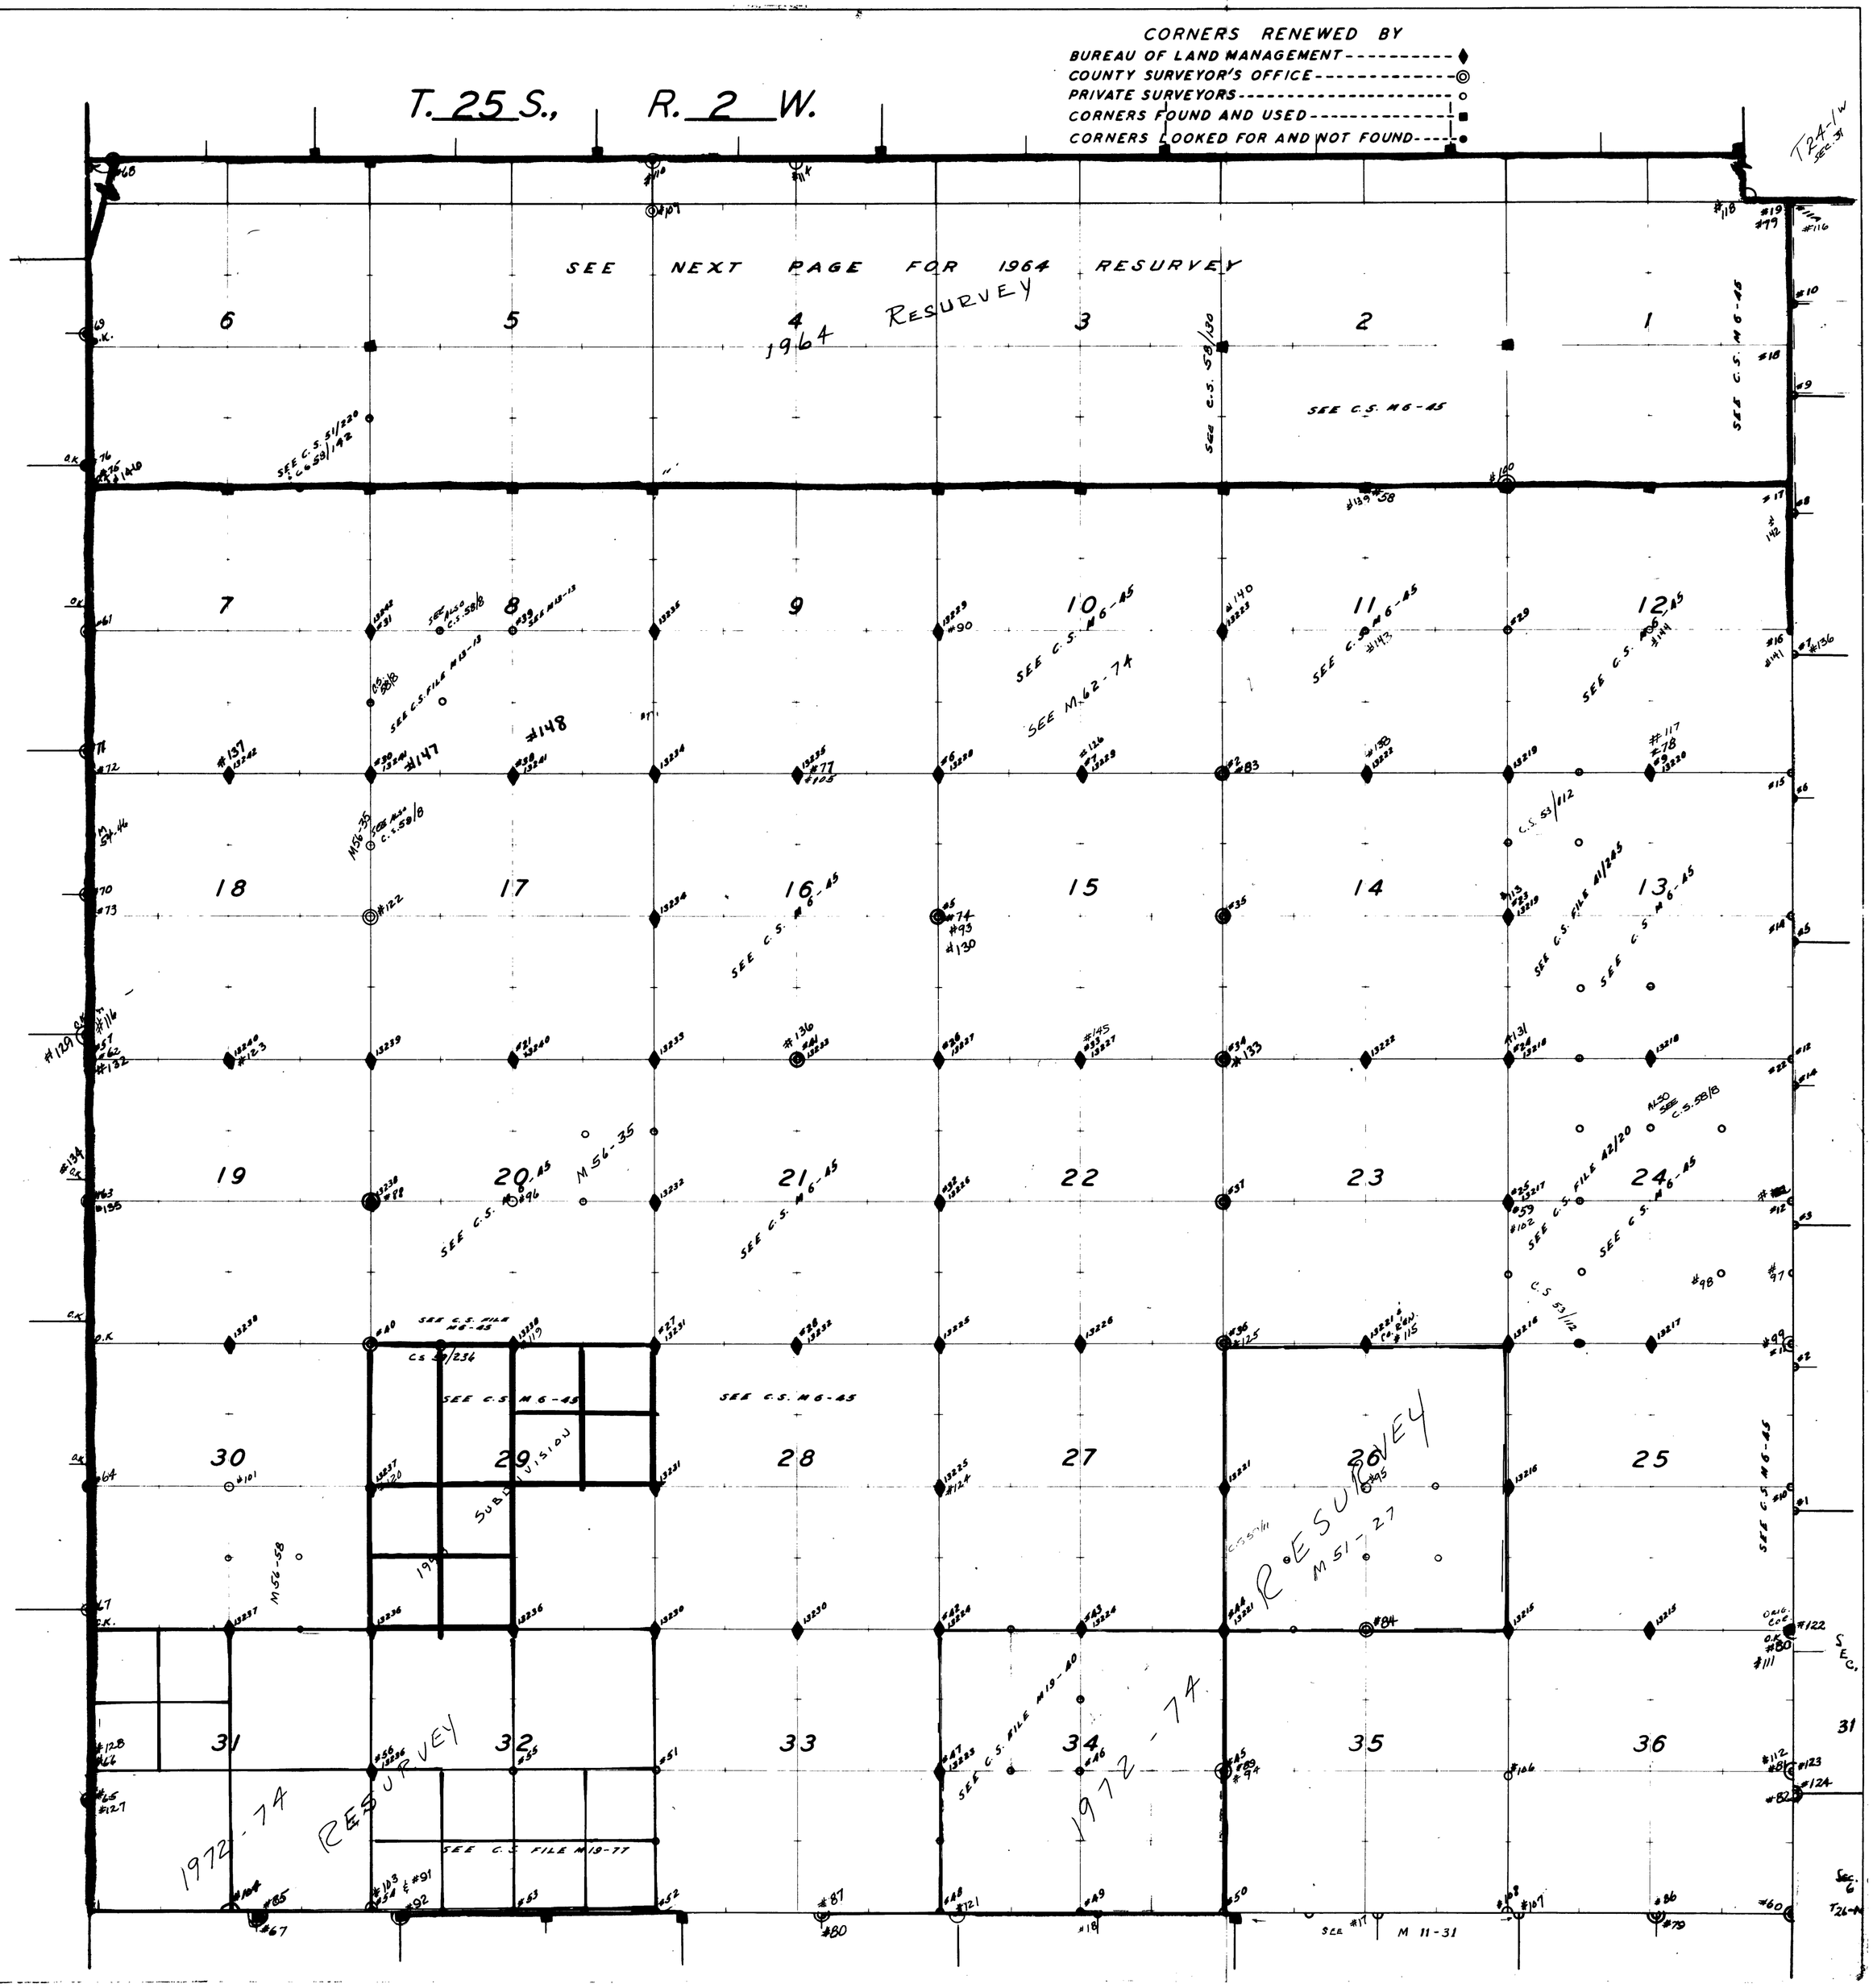
T. 25 S., R. 2 W.
CORNERS RENEWED BY
BUREAU OF LAND MANAGEMENT
COUNTY SURVEYOR'S OFFICE
PRIVATE SURVEYORS
CORNERS FOUND AND USED
CORNERS LOOKED FOR AND NOT FOUND
SEE NEXT PAGE FOR 1964 RESURVEY
RESURVEY 1964
SEE C.S. M6-45
SEE C.S. 58/130
SEE C.S. 51/220 & C.S. 58/142
SEE C.S. FILE M13-13
SEE M62-74
SEE C.S. 53/112
SEE C.S. FILE 41/245
SEE C.S. FILE 42/20
SEE C.S. 58/18
M56-35
M56-58
M51-27
SUBDIVISION
RESURVEY 1972-74
SEE C.S. FILE M19-77
SEE C.S. FILE M19-80
SEE M 11-31
T24-1W SEC. 31
Sec. 31
Sec. 6 T26-1W