

Douglas County Surveyor's Record of  
Government Corners Renewed

T. 26 S. T. S. R. 1 W. R.W.W.M.


KOKE-CHAPMAN CO., EUGENE, ORE. 21881

John M. Powell  
F. Jones  
W. Penley  
Oct. 1969  
C.S. File 54/94

Township Corner as shown:

Set - Brass Cap Mkd: County Surveyor's Office 1969  
R T 26 S R  
1 S 36 S 6 1  
W S 1 E  
T 27 S

Found - 24" D. Fir, now stump, N.61°W., 31.7 ft. Tree open, scribe visible.  
20" D. Fir, now stump, S.55½°W., 36.3 ft. Burnt face.  
No trace of 1927 GLO Brass Cap.  
New Bearing Objects: 3/4" I. Rod N.47°W., 28.1 ft.  
3/4" I. Rod S.80°W., 23.1 ft.

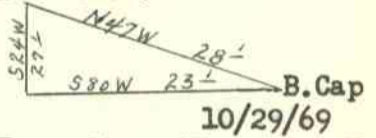

10/29/69

Vernon R. Tracy  
D. Schulze  
C.S. File No. 54/94

1/4 Corner to Section 6 and Section 7.

Found - Decayed Remains of old Corner Tree, no scribing.  
Orig. BT. to S.E. gone, only stump hole remains.  
Orig. 14", now 18" Cedar N. 3° E. 5.3 ft., alive, good scribe visible "T" at top of nearly healed blaze.

We remove remains of old Corner Tree &  
Set - Brass Cap Mkd: County Surveyor's Office 1972  
T26S R1W  
1/4 S 6  
S 7

New BT: 12" Hemlock S.44° E. 7.2 ft. scribed "1/4 S7 CS BT".  
This corner lies 6 ft. East of creek, course South.

6/27/72

1/4 Corner, Sec. 18 only.

Set - Brass cap marked T26S, R1W, 1/4 S18, 1972, RPLS 544  
BT's - 14" Fir, bears N.32°E., 58.4' Scribed 1/4 S18 BT  
13" Fir, bears S.21½°E., 60.2' Scribed 1/4 S18 BT

FO OK  
2/1/92  
DC 50  
CS 64/23

1/4 Corner, Sec. 13 only, T26-2.

Set - Brass cap marked T26S, R2W, 1/4 S13, 1972, RPLS 544  
BT's - 8" Fir, bears S.2°W., 128.5' Scribed 1/4 S13 BT  
6 ft. Steel fencepost with U.S. Forest Service Signs Nos. 54-2 & 54-4, bears N.3°W., 5.0'.

#109

Section Corner, Secs. 7 & 18 only.

Set - Brass cap marked T26S, S7, S18, R1W, T26S R2W, S13, 1972, RPLS 544.  
BT's - 8" Fir, bears N.52°E., 29.1' Scribed T26S R1W, S7, BT.  
7" Fir, bears S18½°E., 26.9' Scribed T26S, R1W, S18, BT.

1/4 Corner, Sections 7 and 18.

Set - Brass cap marked T26S, R1W, 1/4 S7, S18, 1972, RPLS 544  
BT's - 16" Fir, bears N.54.3/4°W., 11.9' scribed 1/4 S7 BT.  
15" Fir, bears S.46½°E., 6.2' Scribed 1/4 S18 BT.

#120

Section Corner, Sections 7, 8, 17, & 18.

Set - Brass cap, 6" below road surface, marked T26S, R1W, S7, S8, S17, S18, 1972, RPLS 544.  
BT's - 15" Fir, bears S.66°W., 52.5' Scribed T26S R1W S18 BT.  
9" Fir bears N.32°W., 36.7' Scribed T26S R1W S7 BT.  
18" Fir, bears N.27°E., 21.0' Scribed T26S R1W, S8 BT.  
8" Fir, bears S.55½°E., 78.4' Scribed T26S R1W S17 BT.

#95 W.C.

Center 1/4, Section 7

Set - Brass cap, 60' above road, marked T26S, R1W, C1/4, S7, 1972, RPLS 544.  
BT's - 13" Fir, bears S.28°W., 12.5' Scribed C1/4 S7 BT.  
25" Fir, bears N.36°E., 23.2' Scribed C1/4 S7 BT.

Section Corner, Sections 6 and 7 only.

Set - Brass cap marked, T26S, S6, S7, R1W, T26S, R2W, S12, 1972, RPLS 544.  
BT's - 13" Fir, bears N.6°E., 10.1' Scribed T26S R1W S6 BT.  
11" Fir, bears S.48½°E., 32.8' Scribed T26S R1W S7 BT.

#114

United States of America  
Don E. Garrett  
M 47 - 7  
October, 1972

RE-RENEWED, SEE CORNER NO. #109  
RE-RENEWED, SEE CORNER NO. #120  
RE-RENEWED, SEE CORNER NO. #95 W.C.  
RE-RENEWED, SEE CORNER NO. #114

Jan 1973