63

T. 26 S., R. 1 W.
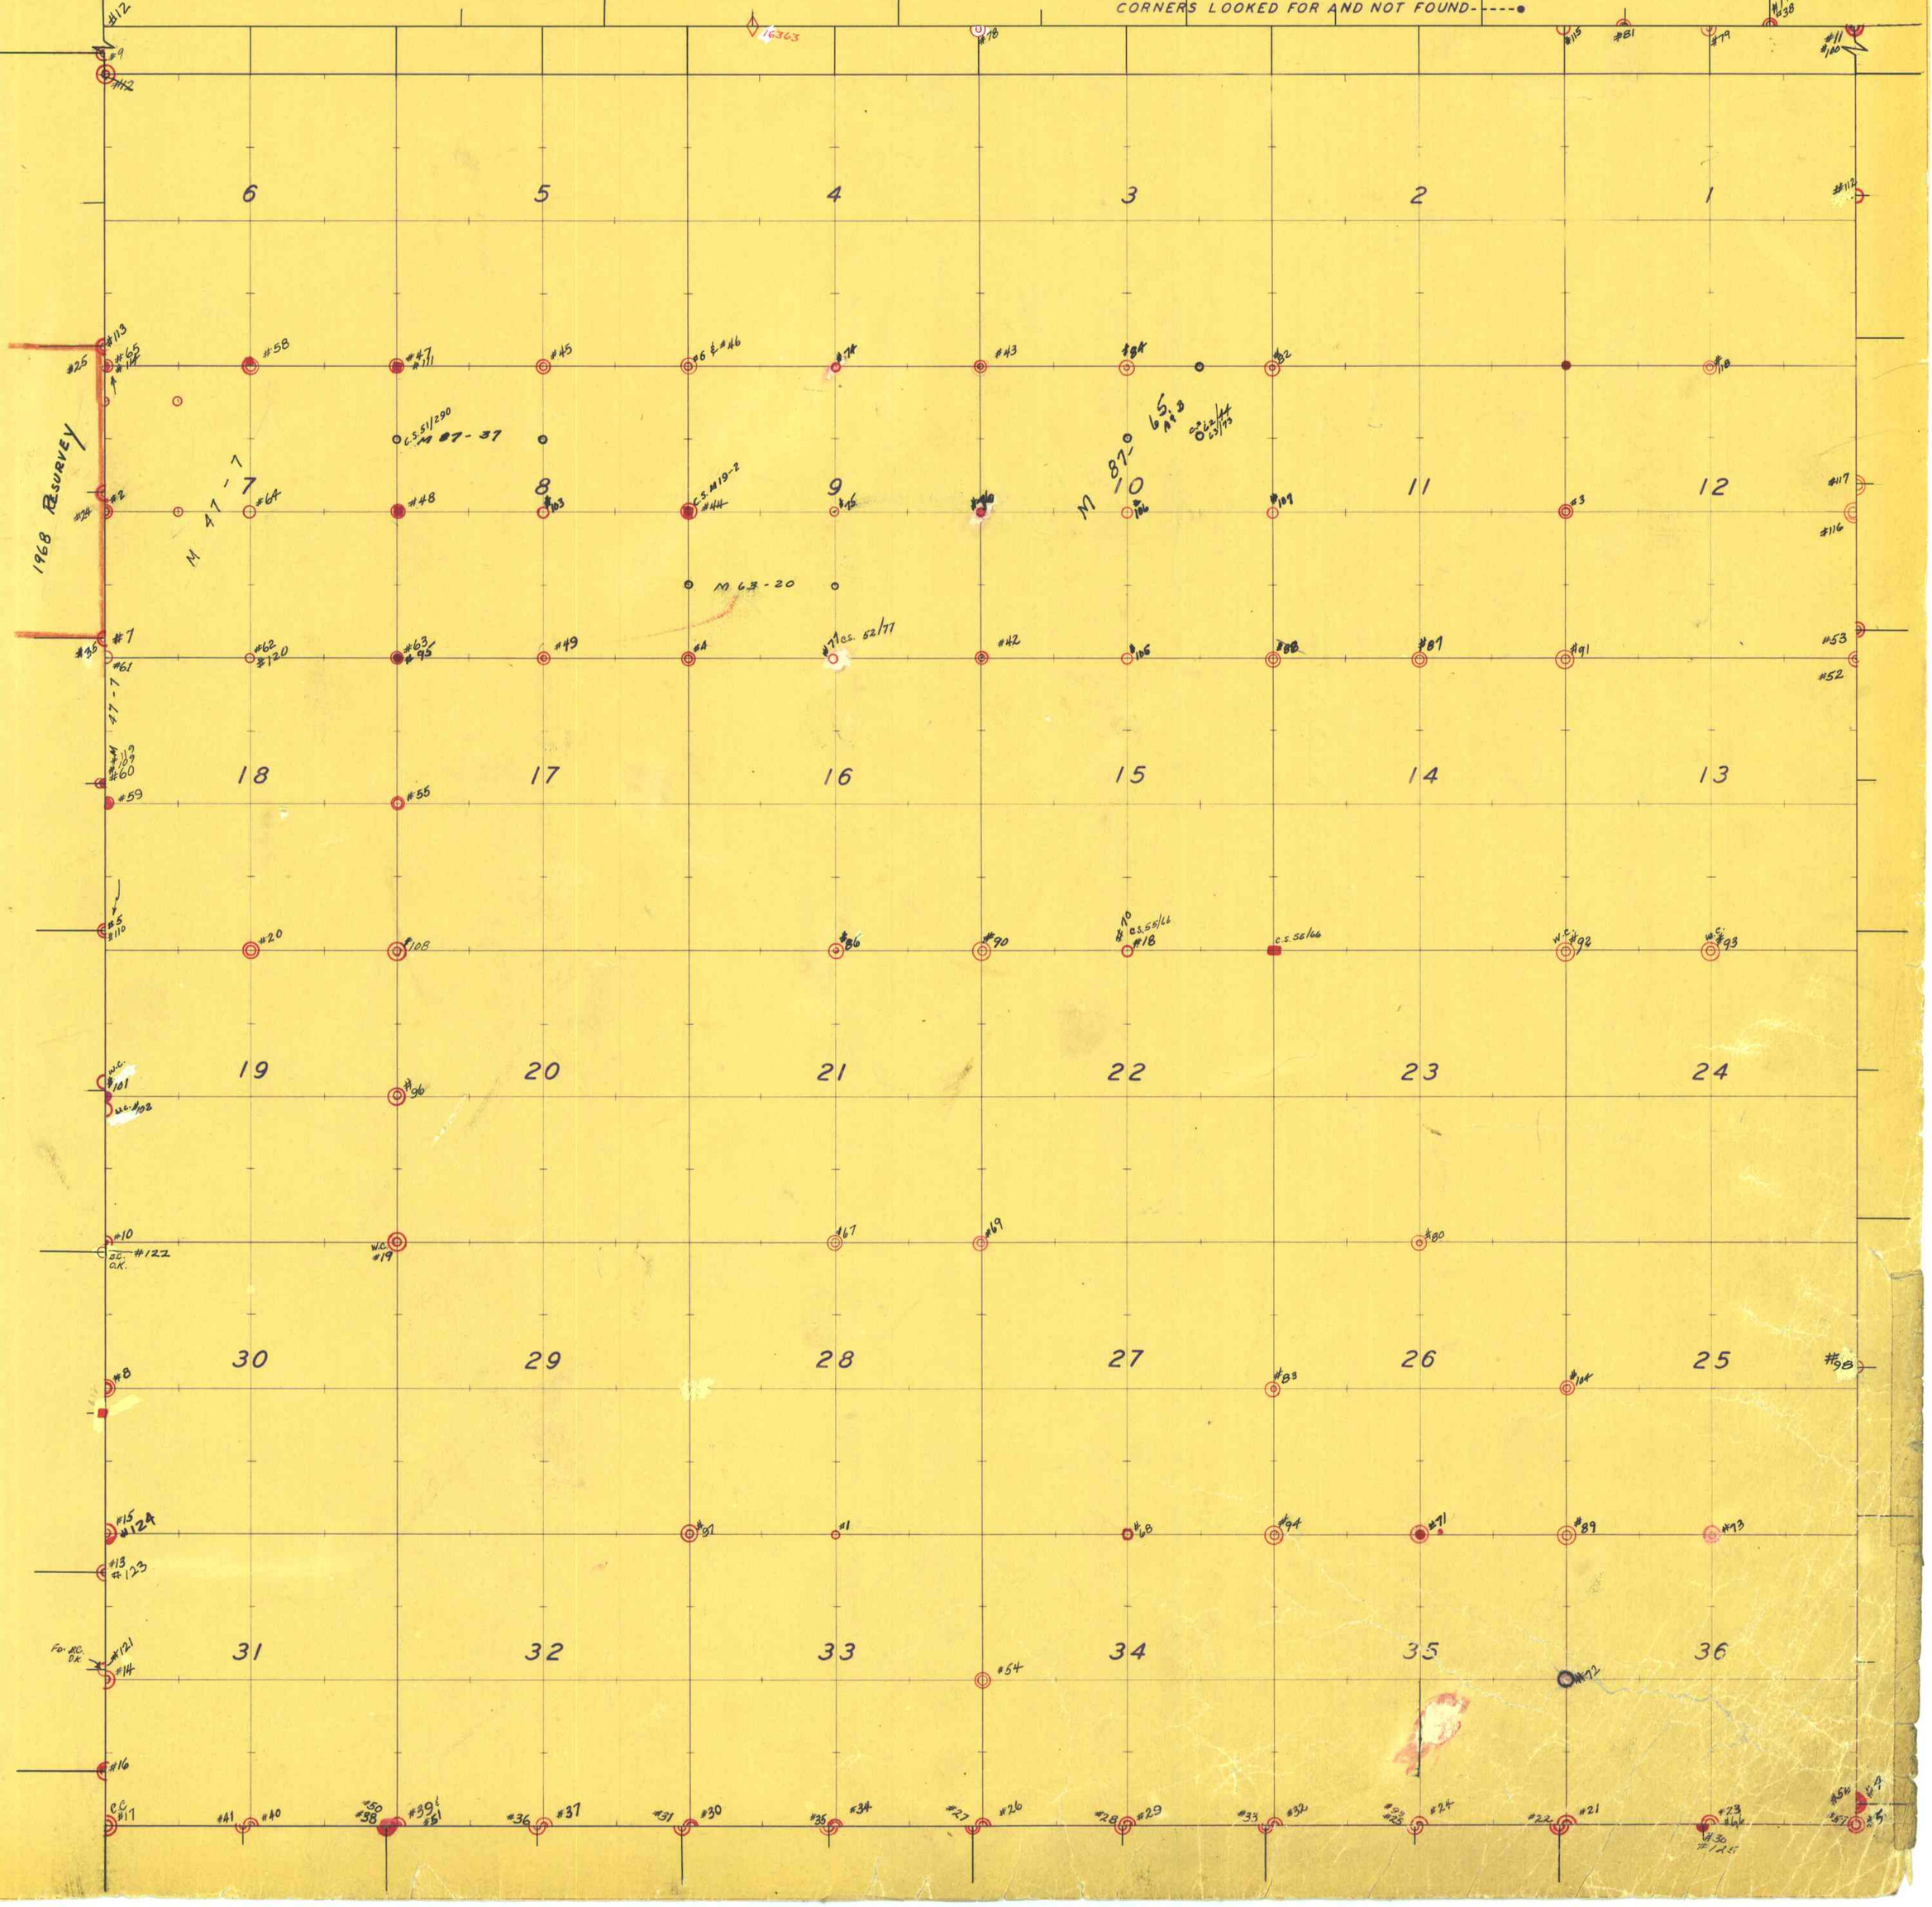
CORNERS RENEWED BY
BUREAU OF LAND MANAGEMENT ----------◆
COUNTY SURVEYOR'S OFFICE ----------◎
PRIVATE SURVEYORS ----------○
CORNERS FOUND AND USED ----------■
CORNERS LOOKED FOR AND NOT FOUND ----●