61

CORNERS RENEWED BY
BUREAU OF LAND MANAGEMENT
COUNTY SURVEYOR'S OFFICE
PRIVATE SURVEYORS
CORNERS FOUND AND USED
CORNERS LOOKED FOR AND NOT FOUND
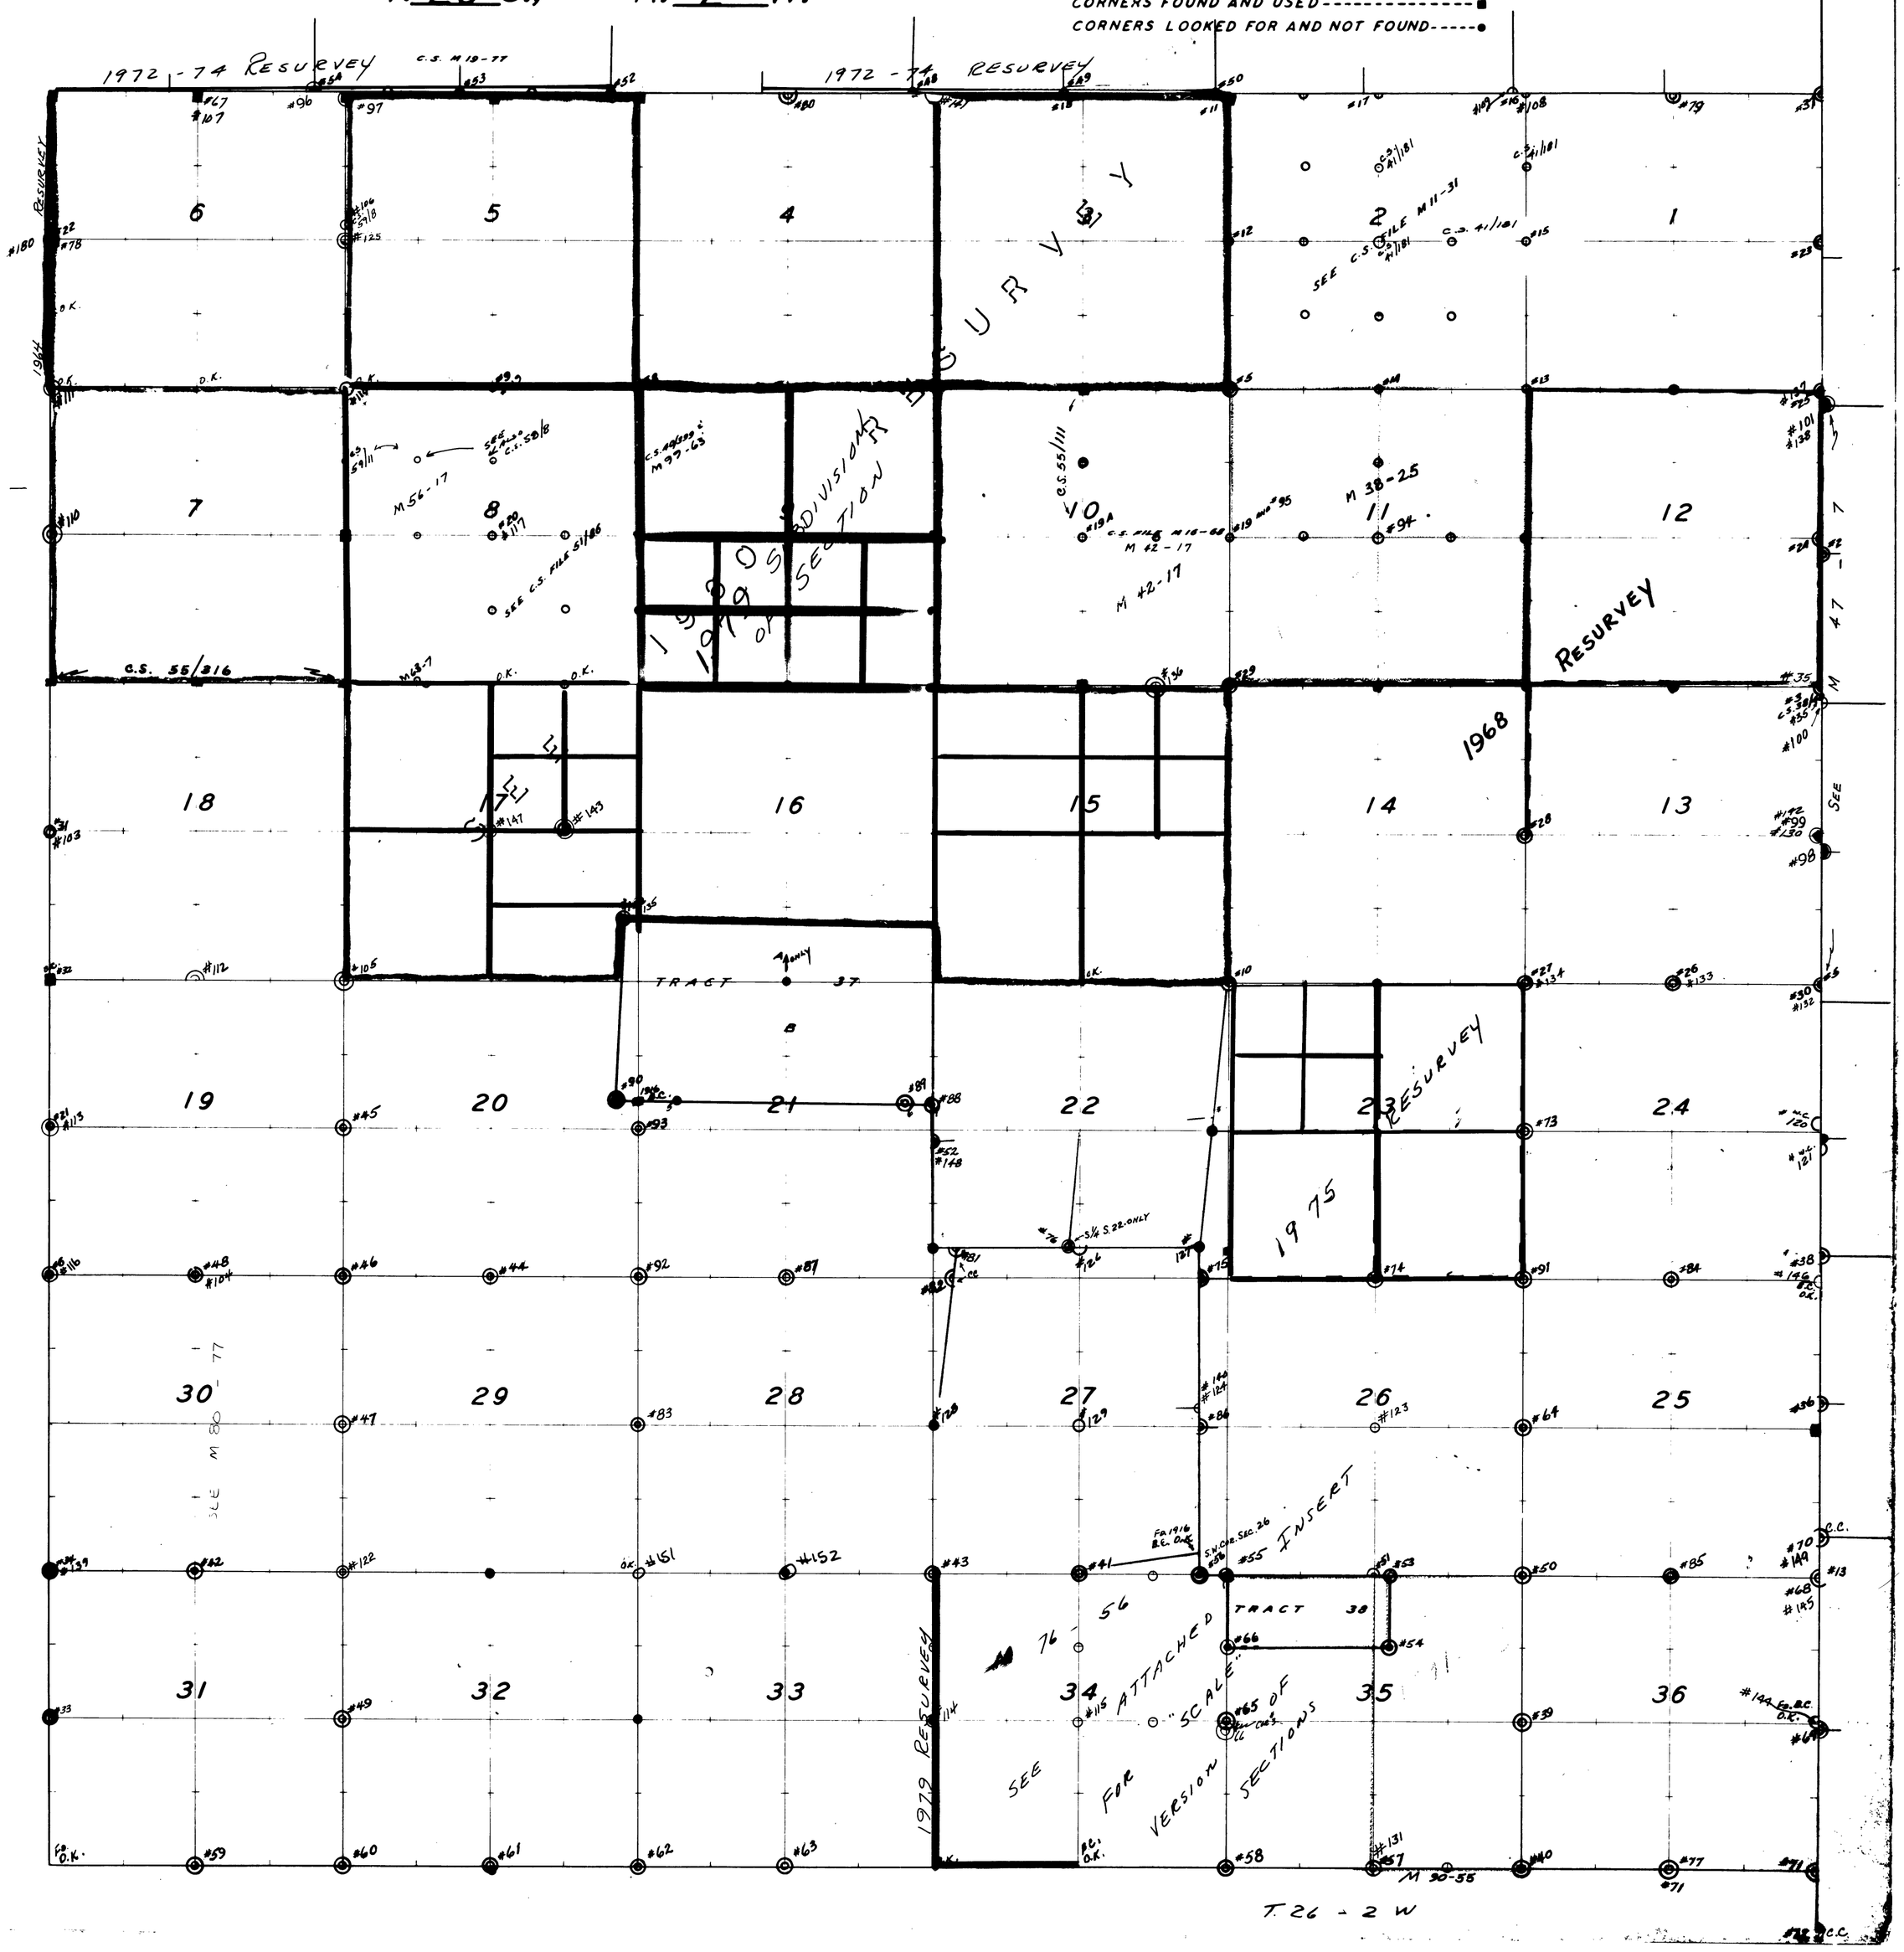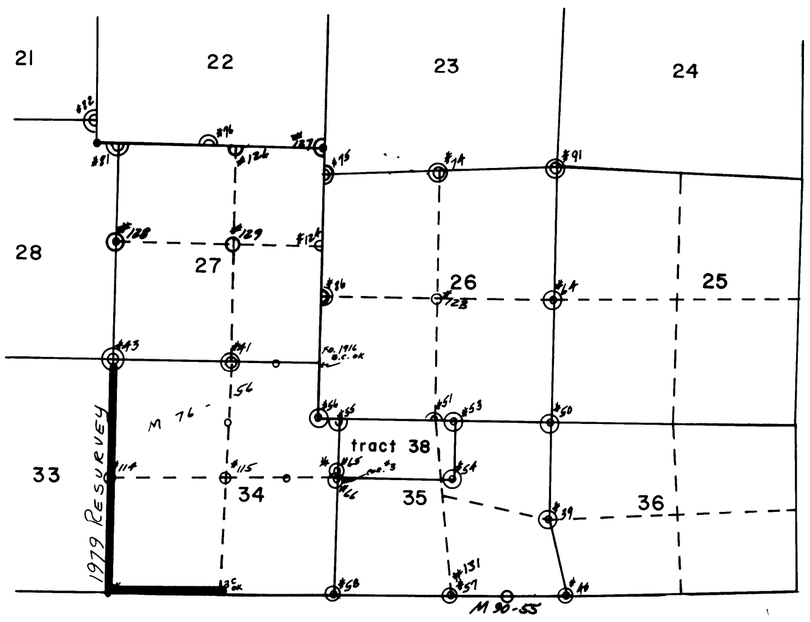
T. 26 S., R. 2 W.