Douglas County Surveyor's Record of Government Corners Renewed

26 T. S. 3 R. W. W. M.

KOKE-CHAPMAN CO., EUGENE, ORE. 21881

78

¼ Section Corner to Section 19, T26S R3W, & Sec. 24, T26S R4W.
Found - 1¼" Iron Bar at Corner & 16", now 18" Fir Stump. I open & find good scribing "BT", record S.43½°W. 13.2 ft., I find should be S. 53° W. 13.2 ft. SEE C.S. FILE 7/54 - REN. #25 IN T.26-4
Also find now 32" Oak Snag checks record distance & bearing as recorded by Cole, 1916. REN. #10
Set Brass Cap alongside Iron Bar & Marked Cap: County Surveyor's Office, 1959 ¼ S24/S19 T26S R4W R3W
New BT's: 9" R.Fir bears S.63°E. 74.0 ft. scribed ¼ S14 CS BT.
4" R.Fir bears S.50°W. 83.0 ft. scribed ¼ S24 CS BT.

RE-ESTABLISHED SEE CORNER NO. 181

James W. Byron
Milo Godfrey
S. A. Bilow
March 19, 1959
C.S. File No. 49/48

79

¼ Section Corner for Sections 9 & 16.
Reset this ¼ Corner with Durable White Oak Post 4" x 4" x 3', properly marked and note that old BT's. are still standing as per government Field Notes. SEE GOV'T SURVEY - 1924

SEE CORNER NO. 129

For Herbert Connine
By M.B. Germond
Sept. 1908
Vol. 2, Pg. 154.

80

¼ Corner to Sections 20 & 21. SEE ALSO #95 (DUPLICATE)
Reestablish as follows:
Set Sand Stone properly marked 4" x 8" x 18" from which:
Red Fir 15" diam bears N.62°34'W. 83 lks. dist.
Red Fir 13" diam. bears N. 70°56'E. 109 lks. dist.

81

Center of Section 21.
I drove Rifle Barrel 1¼" diam. 2½ ft. in the ground and Set East of it 2 inches, A Red Fir Post 4"x 4"x 3' from which:
W. Oak 8" diam bears N.61°07'W. 3.03 lks. dist.
R. Fir 18" " bears S.37°48'E. 45.9 lks. dist.
B. Oak 14" " bears S.31°15'W. 5.90 lks. dist.

82

Reestablish Corner for Sections 16, 17, 20, & 21.
Set White Oak Post 5" x 5" x 3' from which:
Red Fir 14" diam. bears N.62°25'E. 38 lks. dist.
B. Oak 6" diam. bears S.33°42'E. 35 lks. dist.
B. Oak 14" diam. bears S.38°00'W. 17 lks. dist.
B. Oak 16" diam. bears N.30°00'W. 35 lks. dist., This is old Govt. Tree and is plainly marked and in good condition.

SEE CORNER NO. 27 & 104

83

¼ Section Corner to Sections 16 & 21.
I took for position of this corner a point from which the old Witness Trees as made by Brict bears as follows:
R. Cedar 16" diam. bears S.70°20'W. 22 lks. dist.
R. Cedar 24" diam. bears N.65°40'E. 44 lks. dist.

SEE CORNER NO. 35

Corners Set by M. B. Germond, Deputy
For O. E. Smith
Sept. 14 - 17, 1908
Recorded in Volume 2, Page 153-154.

84

Section Corner to Sections 21, 22, 27 and 28.
Found - Orig. 17", Now 26" W. Oak N.20°W. 316.8 ft., down & partly rotted, previously opened, shows good scribing "S".
Orig. 12", now 24" B. Oak, now Snag, N. 5°E. 666.0 ft. I opened, shows good scribing "S22".
Badly Burned Laurel Snag that checks fair for Orig. S.W. BT.
Note - I find bearings & distances for Orig. BT's. do not check record. This condition is found relative to position of Sec. Cor.
Corner is 90 ft. East of Wire Fence.

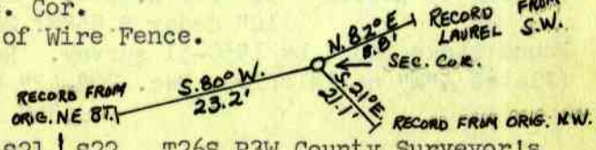

Set Brass Cap at Corner Mkd: S21 | S22 / S28 | S27 T26S R3W County Surveyor's Office, 1959.
New BT's: 29" Cedar bears N. 11°E. 16.7 ft. scribed S22 T26S R3W CS BT.
15" R.Fir bears N.66°W. 25.3 ft. scribed S21 T26S R3W CS BT.
7" CEdar bears S.73°W. 10.6 ft. scribed S28 T26S R8W CS BT.
28" Cedar bears S.82°E. 19.2 ft. scribed S27 T26S R3W CS BT

James W. Byron, Deputy
Milo Godfrey
Clete Putnam
Sept. 15, 1959
C. S. File No. 49/48