


T. 26 S., R. 6 W.

CORNERS RENEWED BY
 BUREAU OF LAND MANAGEMENT -----◆
 COUNTY SURVEYOR'S OFFICE -----○
 PRIVATE SURVEYORS -----○
 CORNERS FOUND AND USED -----■
 CORNERS LOOKED FOR AND NOT FOUND -----●

T 5 e - e

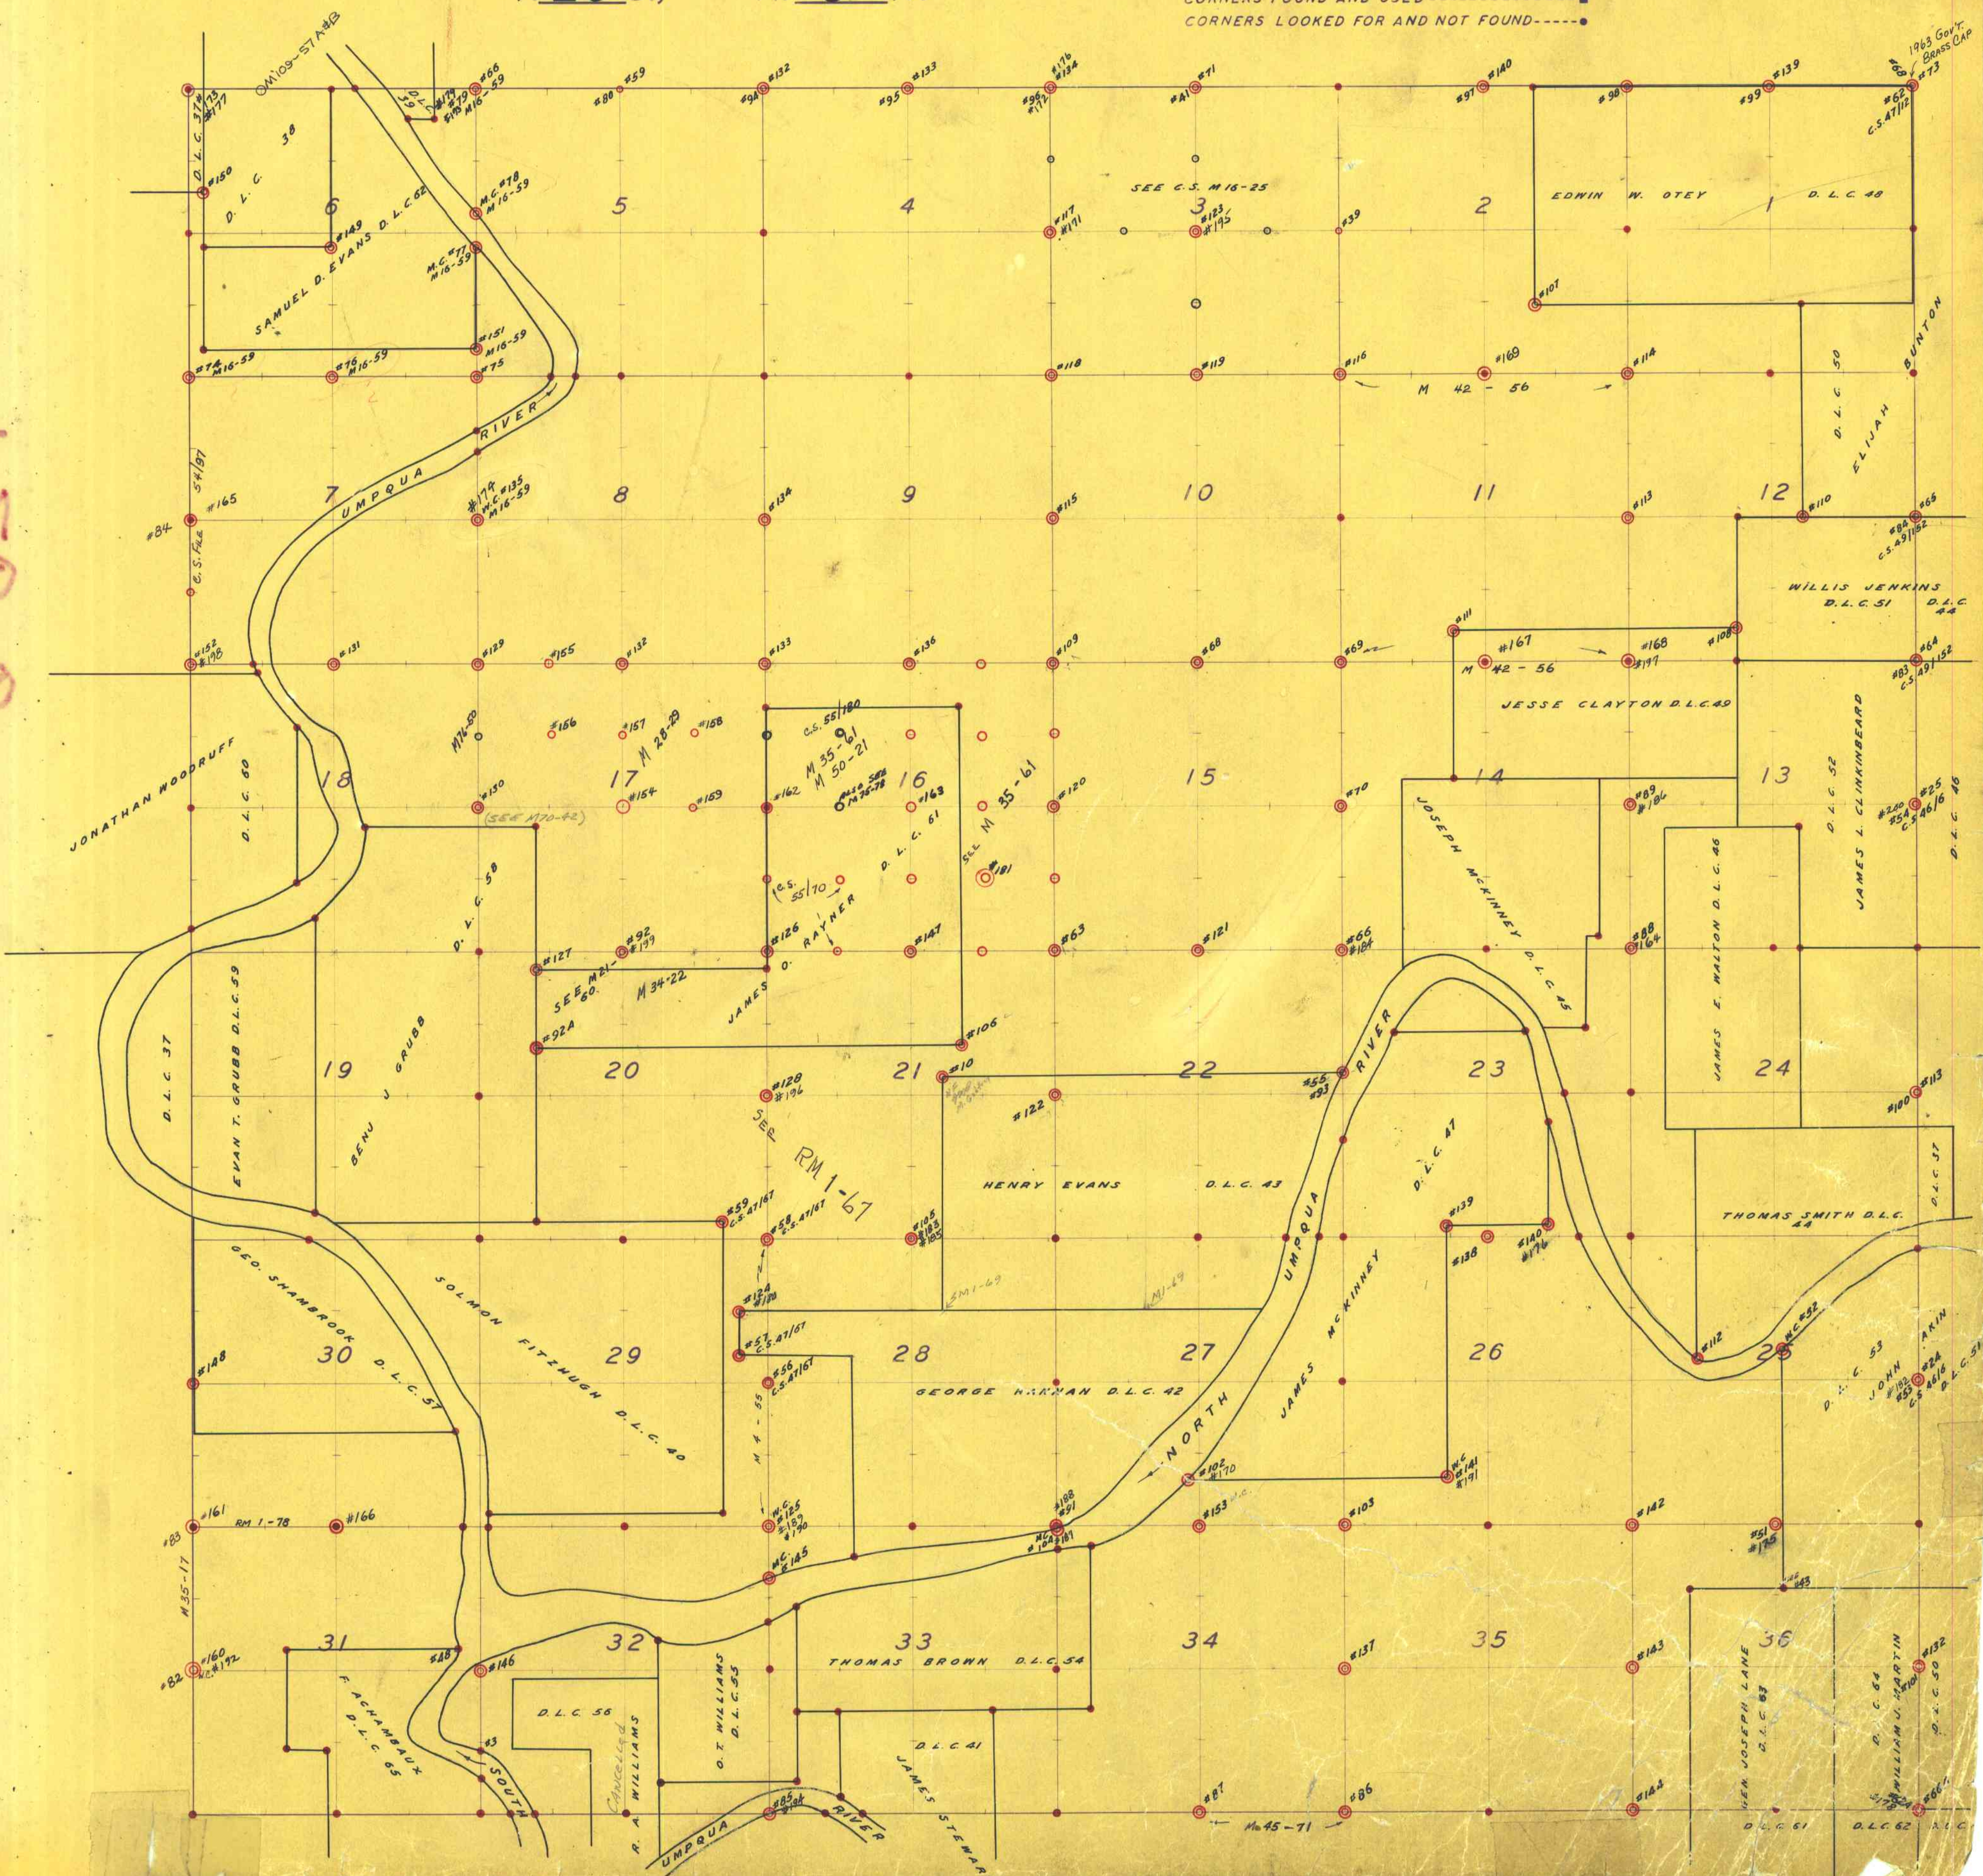

1963 Gov't Brass Cap #73

ELIJAH BUNTON D.L.C. 50

WILLIS JENKINS D.L.C. 51


JOSEPH MCKINNEY D.L.C. 45

JAMES E. WALTON D.L.C. 46

JAMES L. CLINKINBEARD D.L.C. 52

THOMAS SMITH D.L.C. 44

JOHN AKIN D.L.C. 53

SEN JOSEPH LANE D.L.C. 63

WILLIAM U. MARTIN D.L.C. 64

D.L.C. 50

THOMAS BROWN D.L.C. 54

O.T. WILLIAMS D.L.C. 55

D.L.C. 41

JAMES STEWART

M 35-17

#160

#161

