65

T. 26 S., R. 6 W.
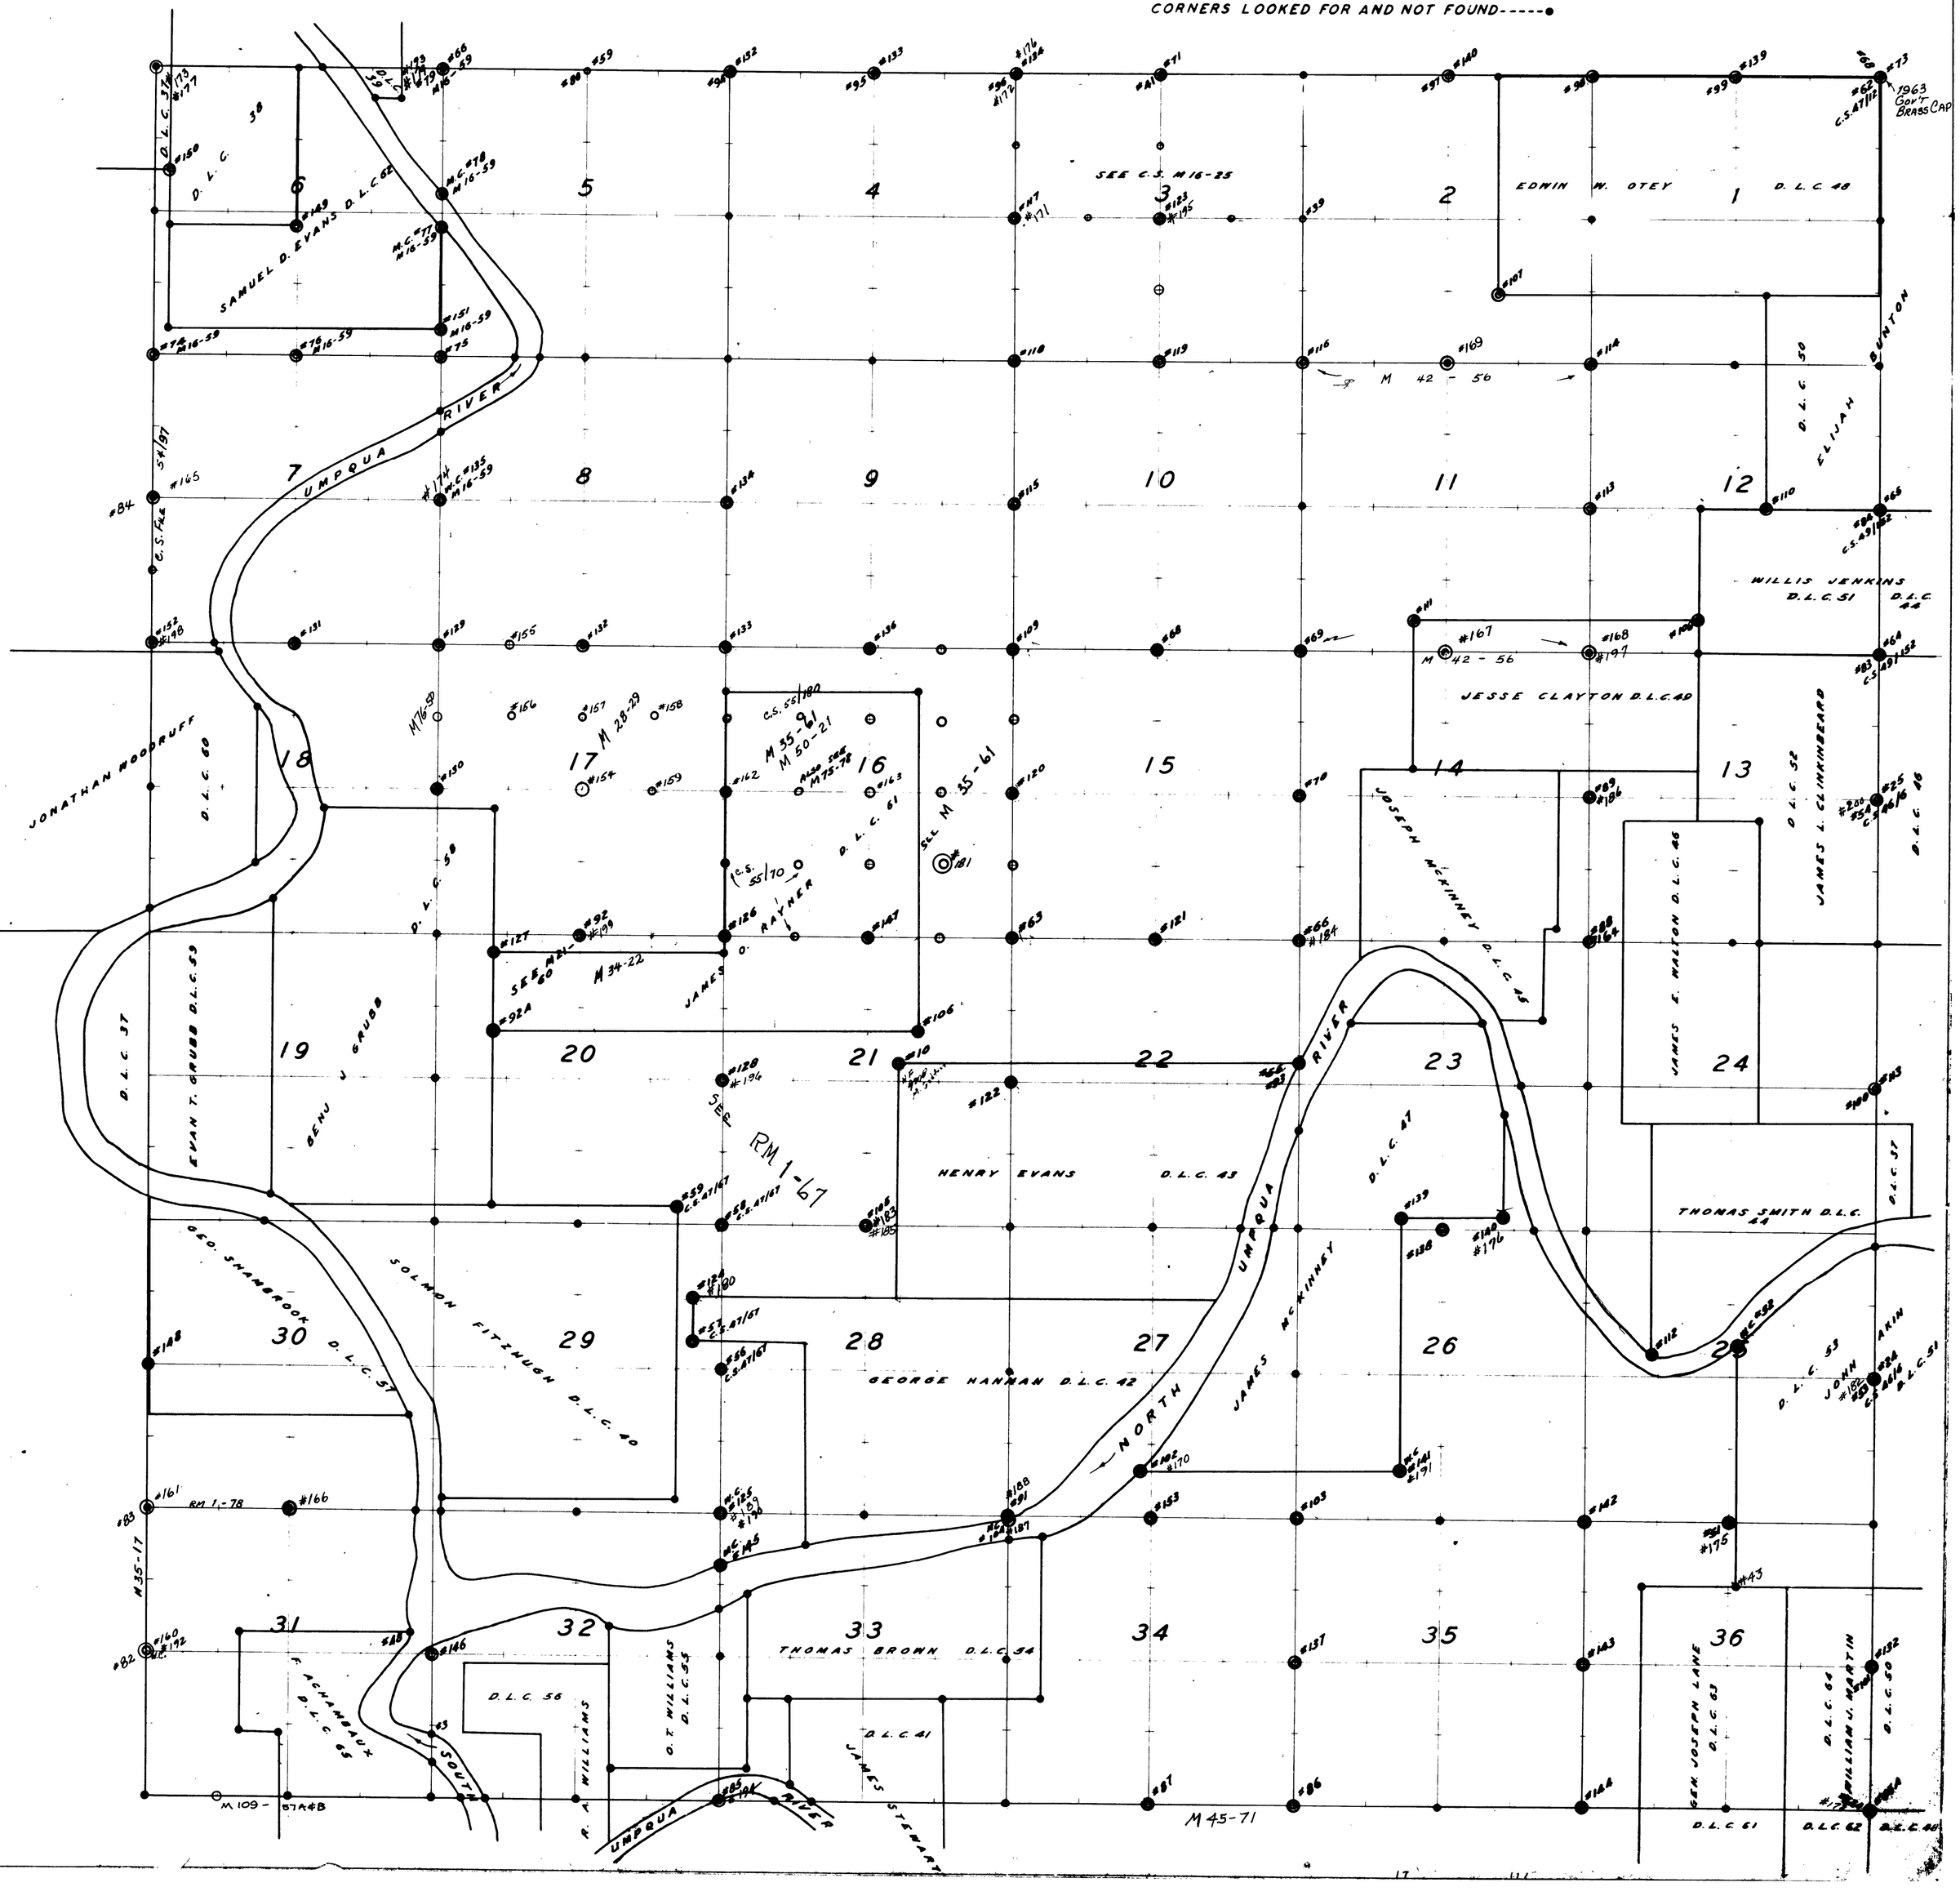
CORNERS RENEWED BY
BUREAU OF LAND MANAGEMENT ---------- ♦
COUNTY SURVEYOR'S OFFICE ---------- ◎
PRIVATE SURVEYORS ---------- ○
CORNERS FOUND AND USED ---------- ■
CORNERS LOOKED FOR AND NOT FOUND ----- ●