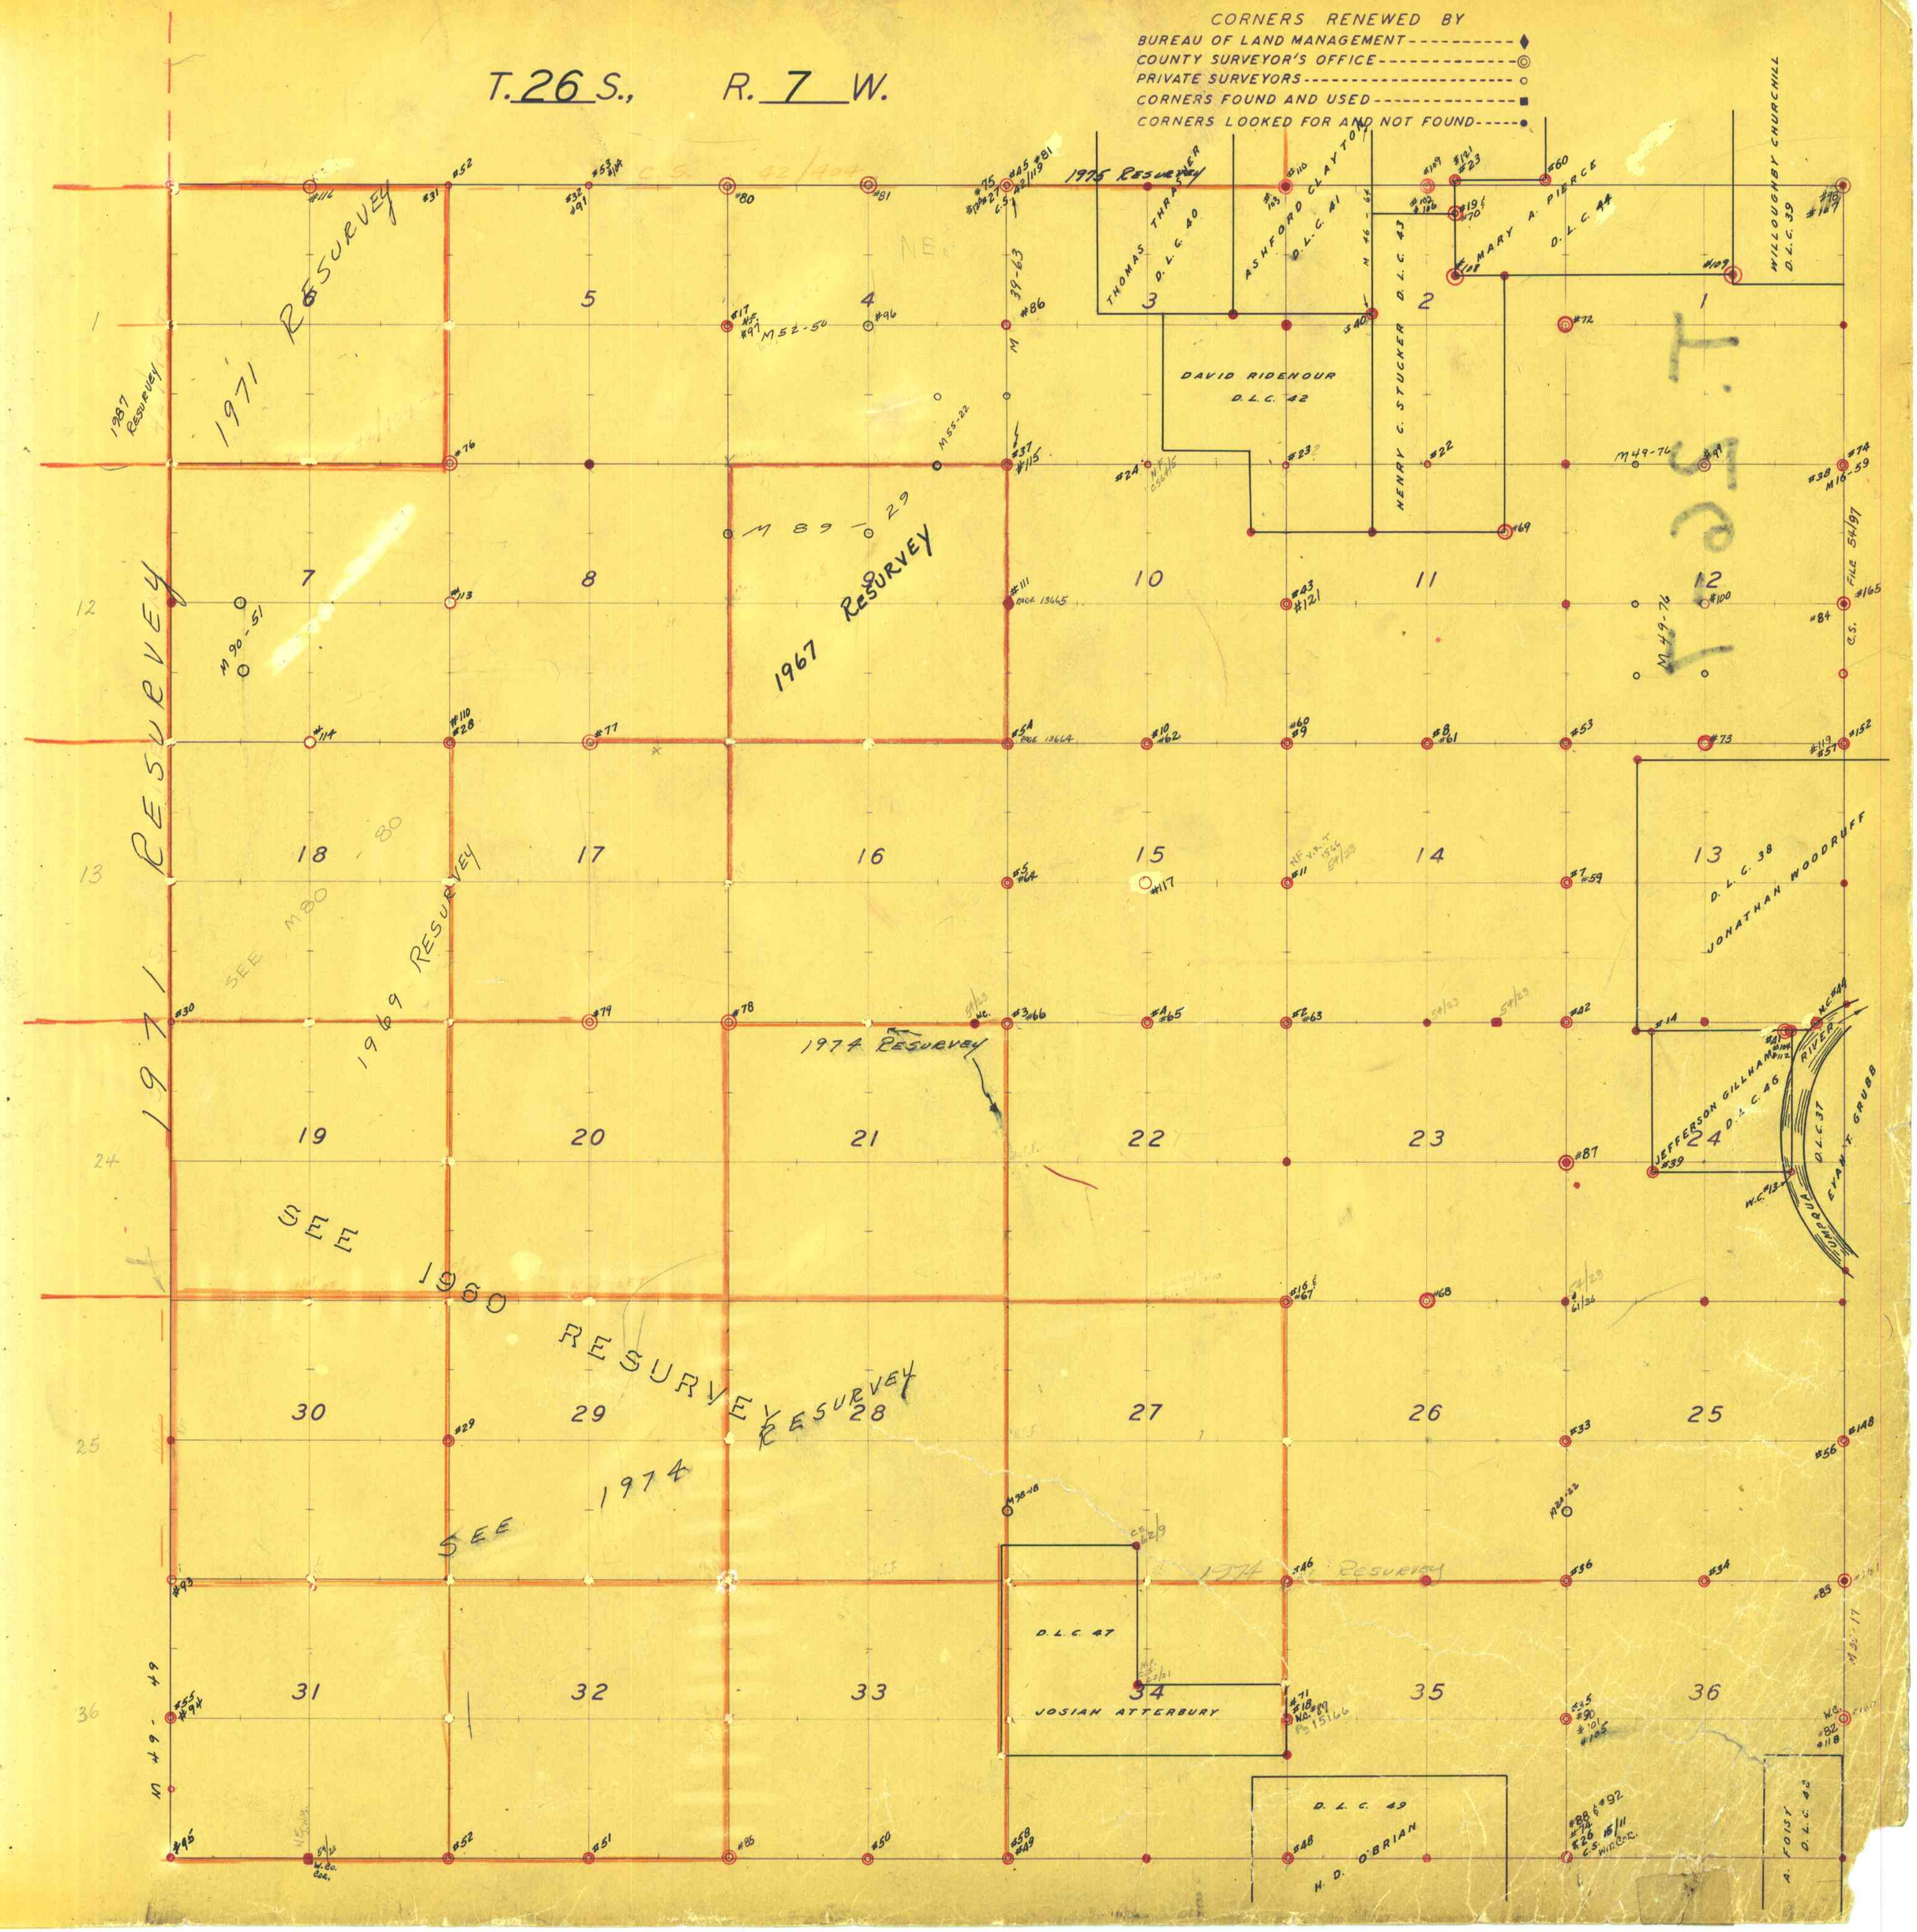
T. 26 S., R. 7 W.
CORNERS RENEWED BY
BUREAU OF LAND MANAGEMENT
COUNTY SURVEYOR'S OFFICE
PRIVATE SURVEYORS
CORNERS FOUND AND USED
CORNERS LOOKED FOR AND NOT FOUND
1971 RESURVEY
1975 RESURVEY
1967 RESURVEY
1969 RESURVEY
1974 RESURVEY
1980 RESURVEY
THOMAS THRASHER D.L.C. 40
ASHFORD CLAYTON D.L.C. 41
HENRY C. STUCKER D.L.C. 43
MARY A. PIERCE D.L.C. 44
WILLOUGHBY CHURCHILL D.L.C. 39
DAVID RIDENOUR D.L.C. 42
JONATHAN WOODRUFF D.L.C. 38
JEFFERSON GILLHAM D.L.C. 46
EVANY T. GRUBB D.L.C. 37
COMPADRE RIVER
D.L.C. 47
JOSIAH ATTERBURY
D.L.C. 49
H. D. O'BRIAN
A. FOIST D.L.C. 43