


T. 26 S., R. 8 W.

CORNERS RENEWED BY
 BUREAU OF LAND MANAGEMENT -----◆
 COUNTY SURVEYOR'S OFFICE -----○
 PRIVATE SURVEYORS -----○
 CORNERS FOUND AND USED -----■
 CORNERS LOOKED FOR AND NOT FOUND -----●

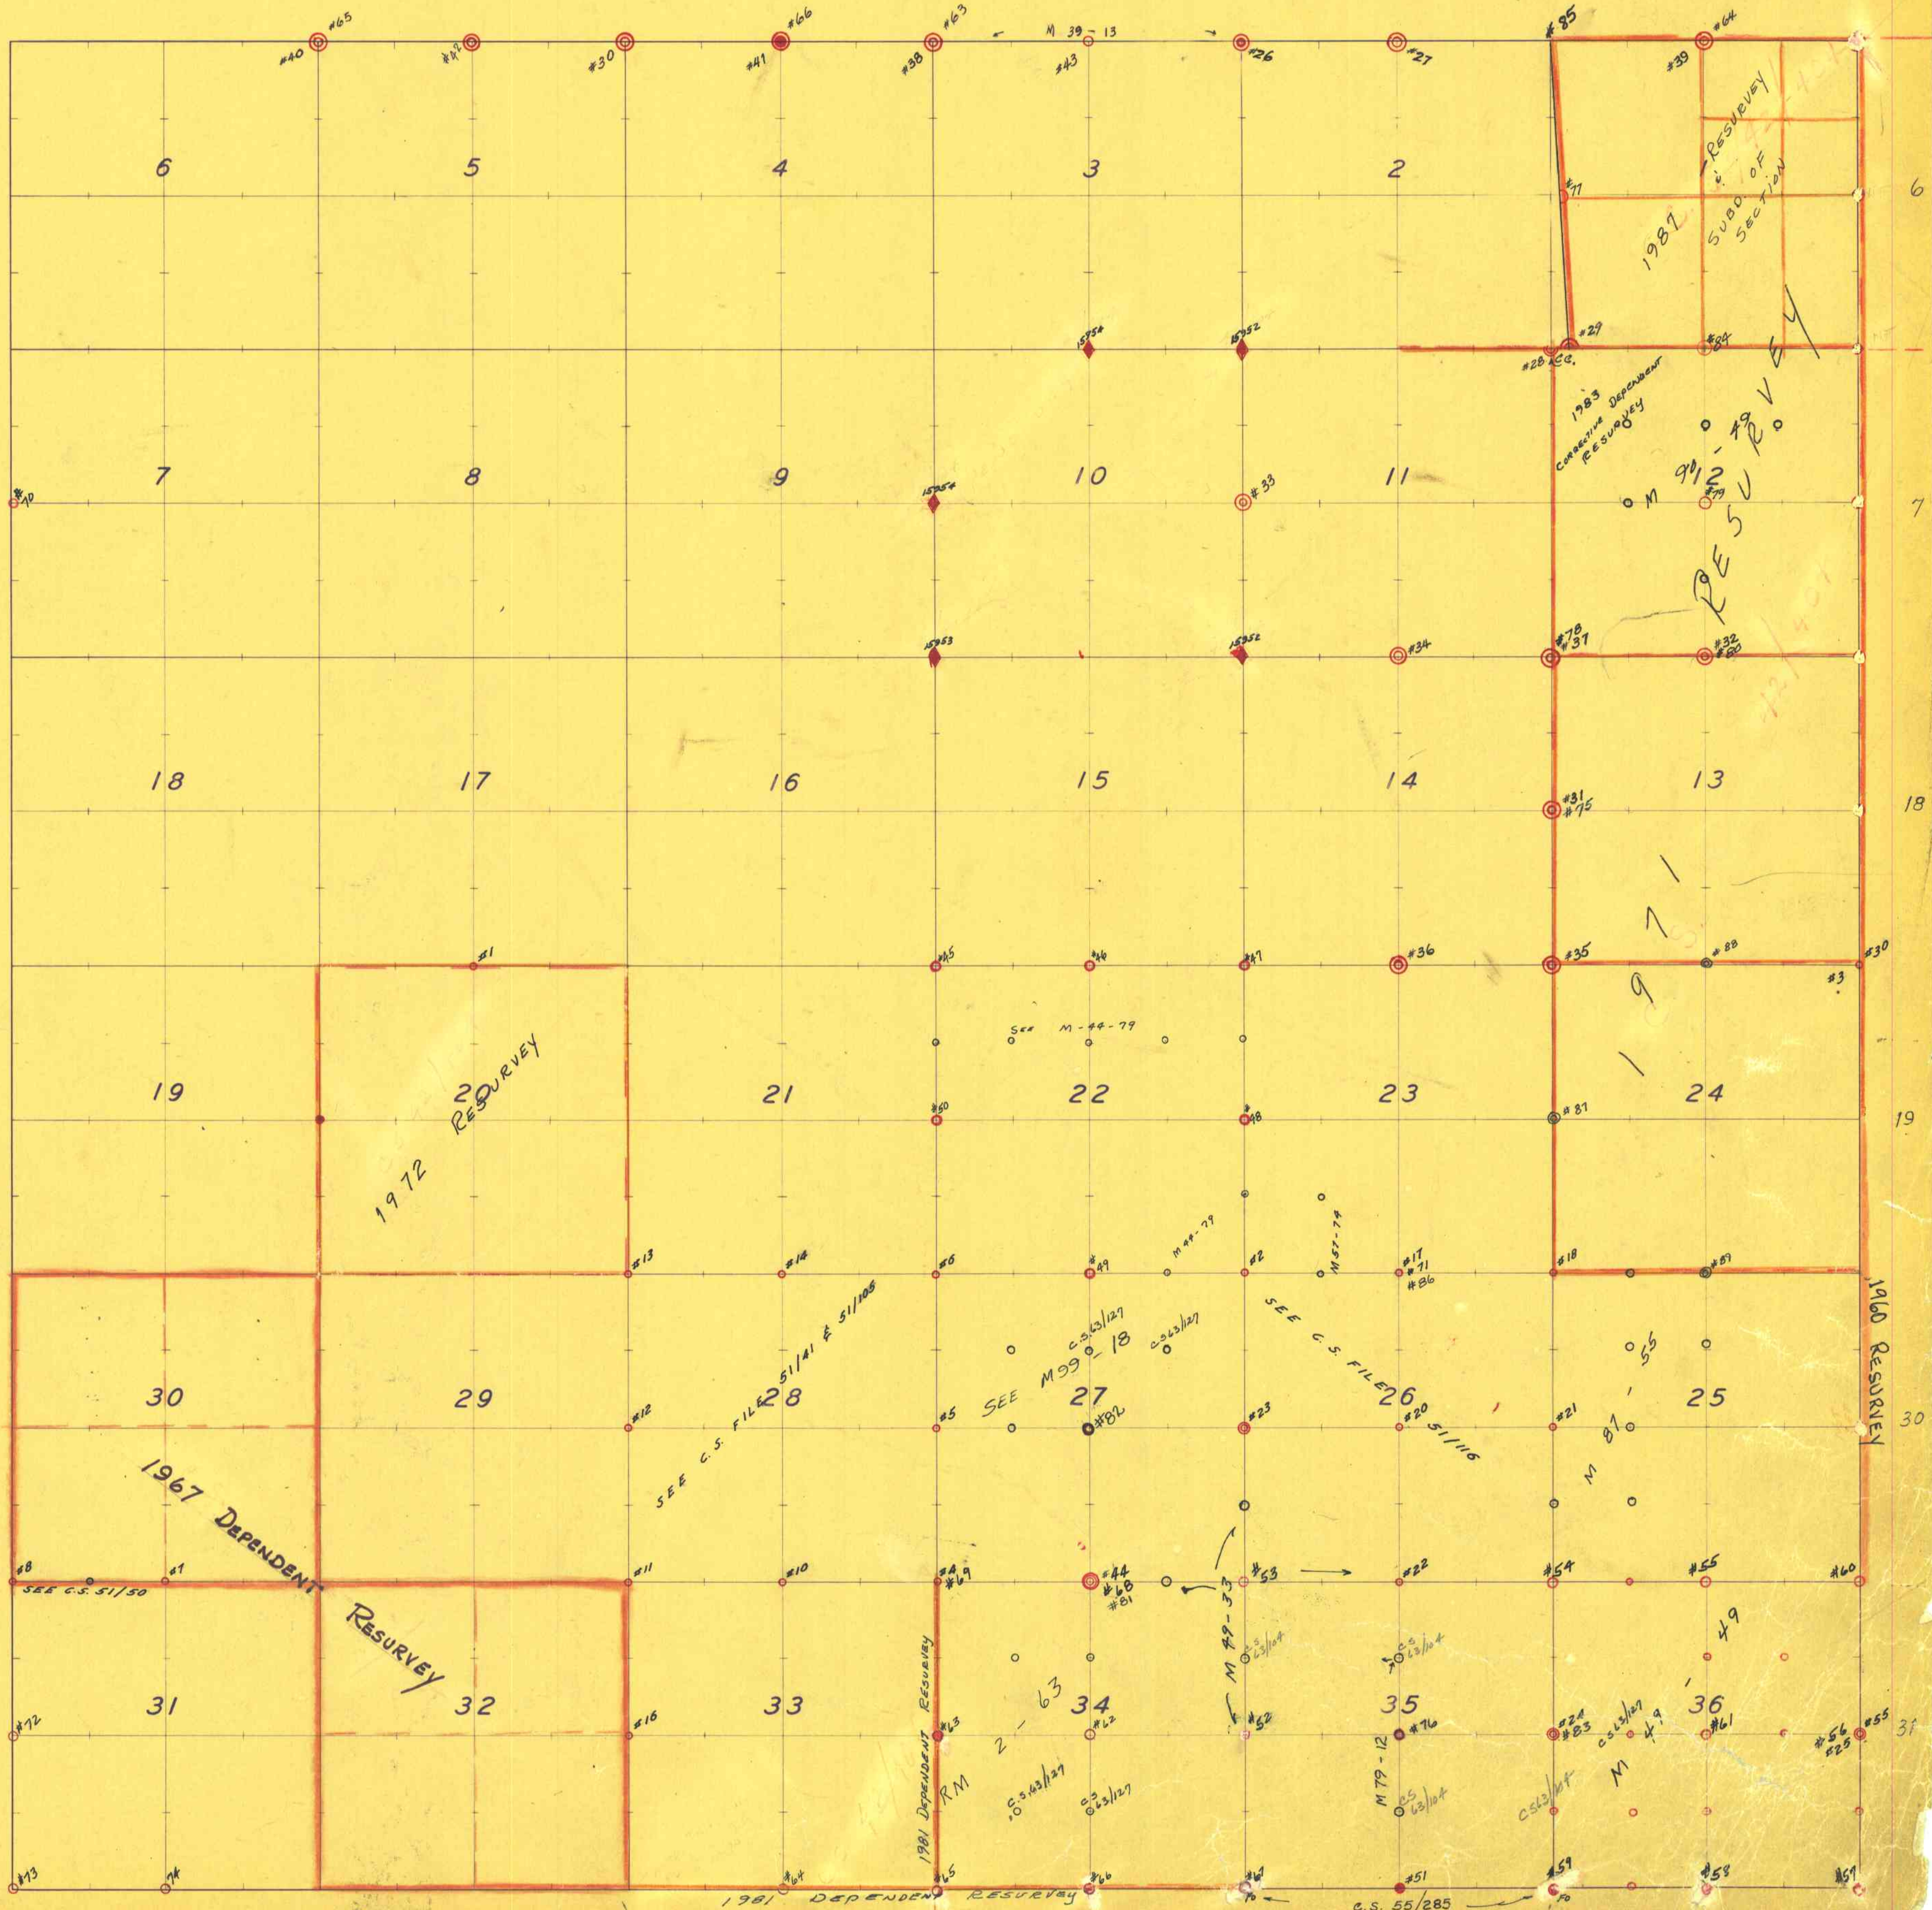

101

6

7

18

19

30

31

32

33

6

5

4

3

2

7

8

9

10

11

18

17

16

15

14

19

21

22

23

24

30

29

28

27

26

25

31

32

33

34

35

36



































































































































































































































































































