T. 27 S., R. 2 W.

CORNERS RENEWED BY
BUREAU OF LAND MANAGEMENT ----------
COUNTY SURVEYOR'S OFFICE ----------
PRIVATE SURVEYORS ----------
CORNERS FOUND AND USED ----------
CORNERS LOOKED FOR AND NOT FOUND -----

THE BOUNDARIES ARE TYPED IN THE "NEW" SYSTEM & THE PAGES ARE IN THE BLACK BINDERS
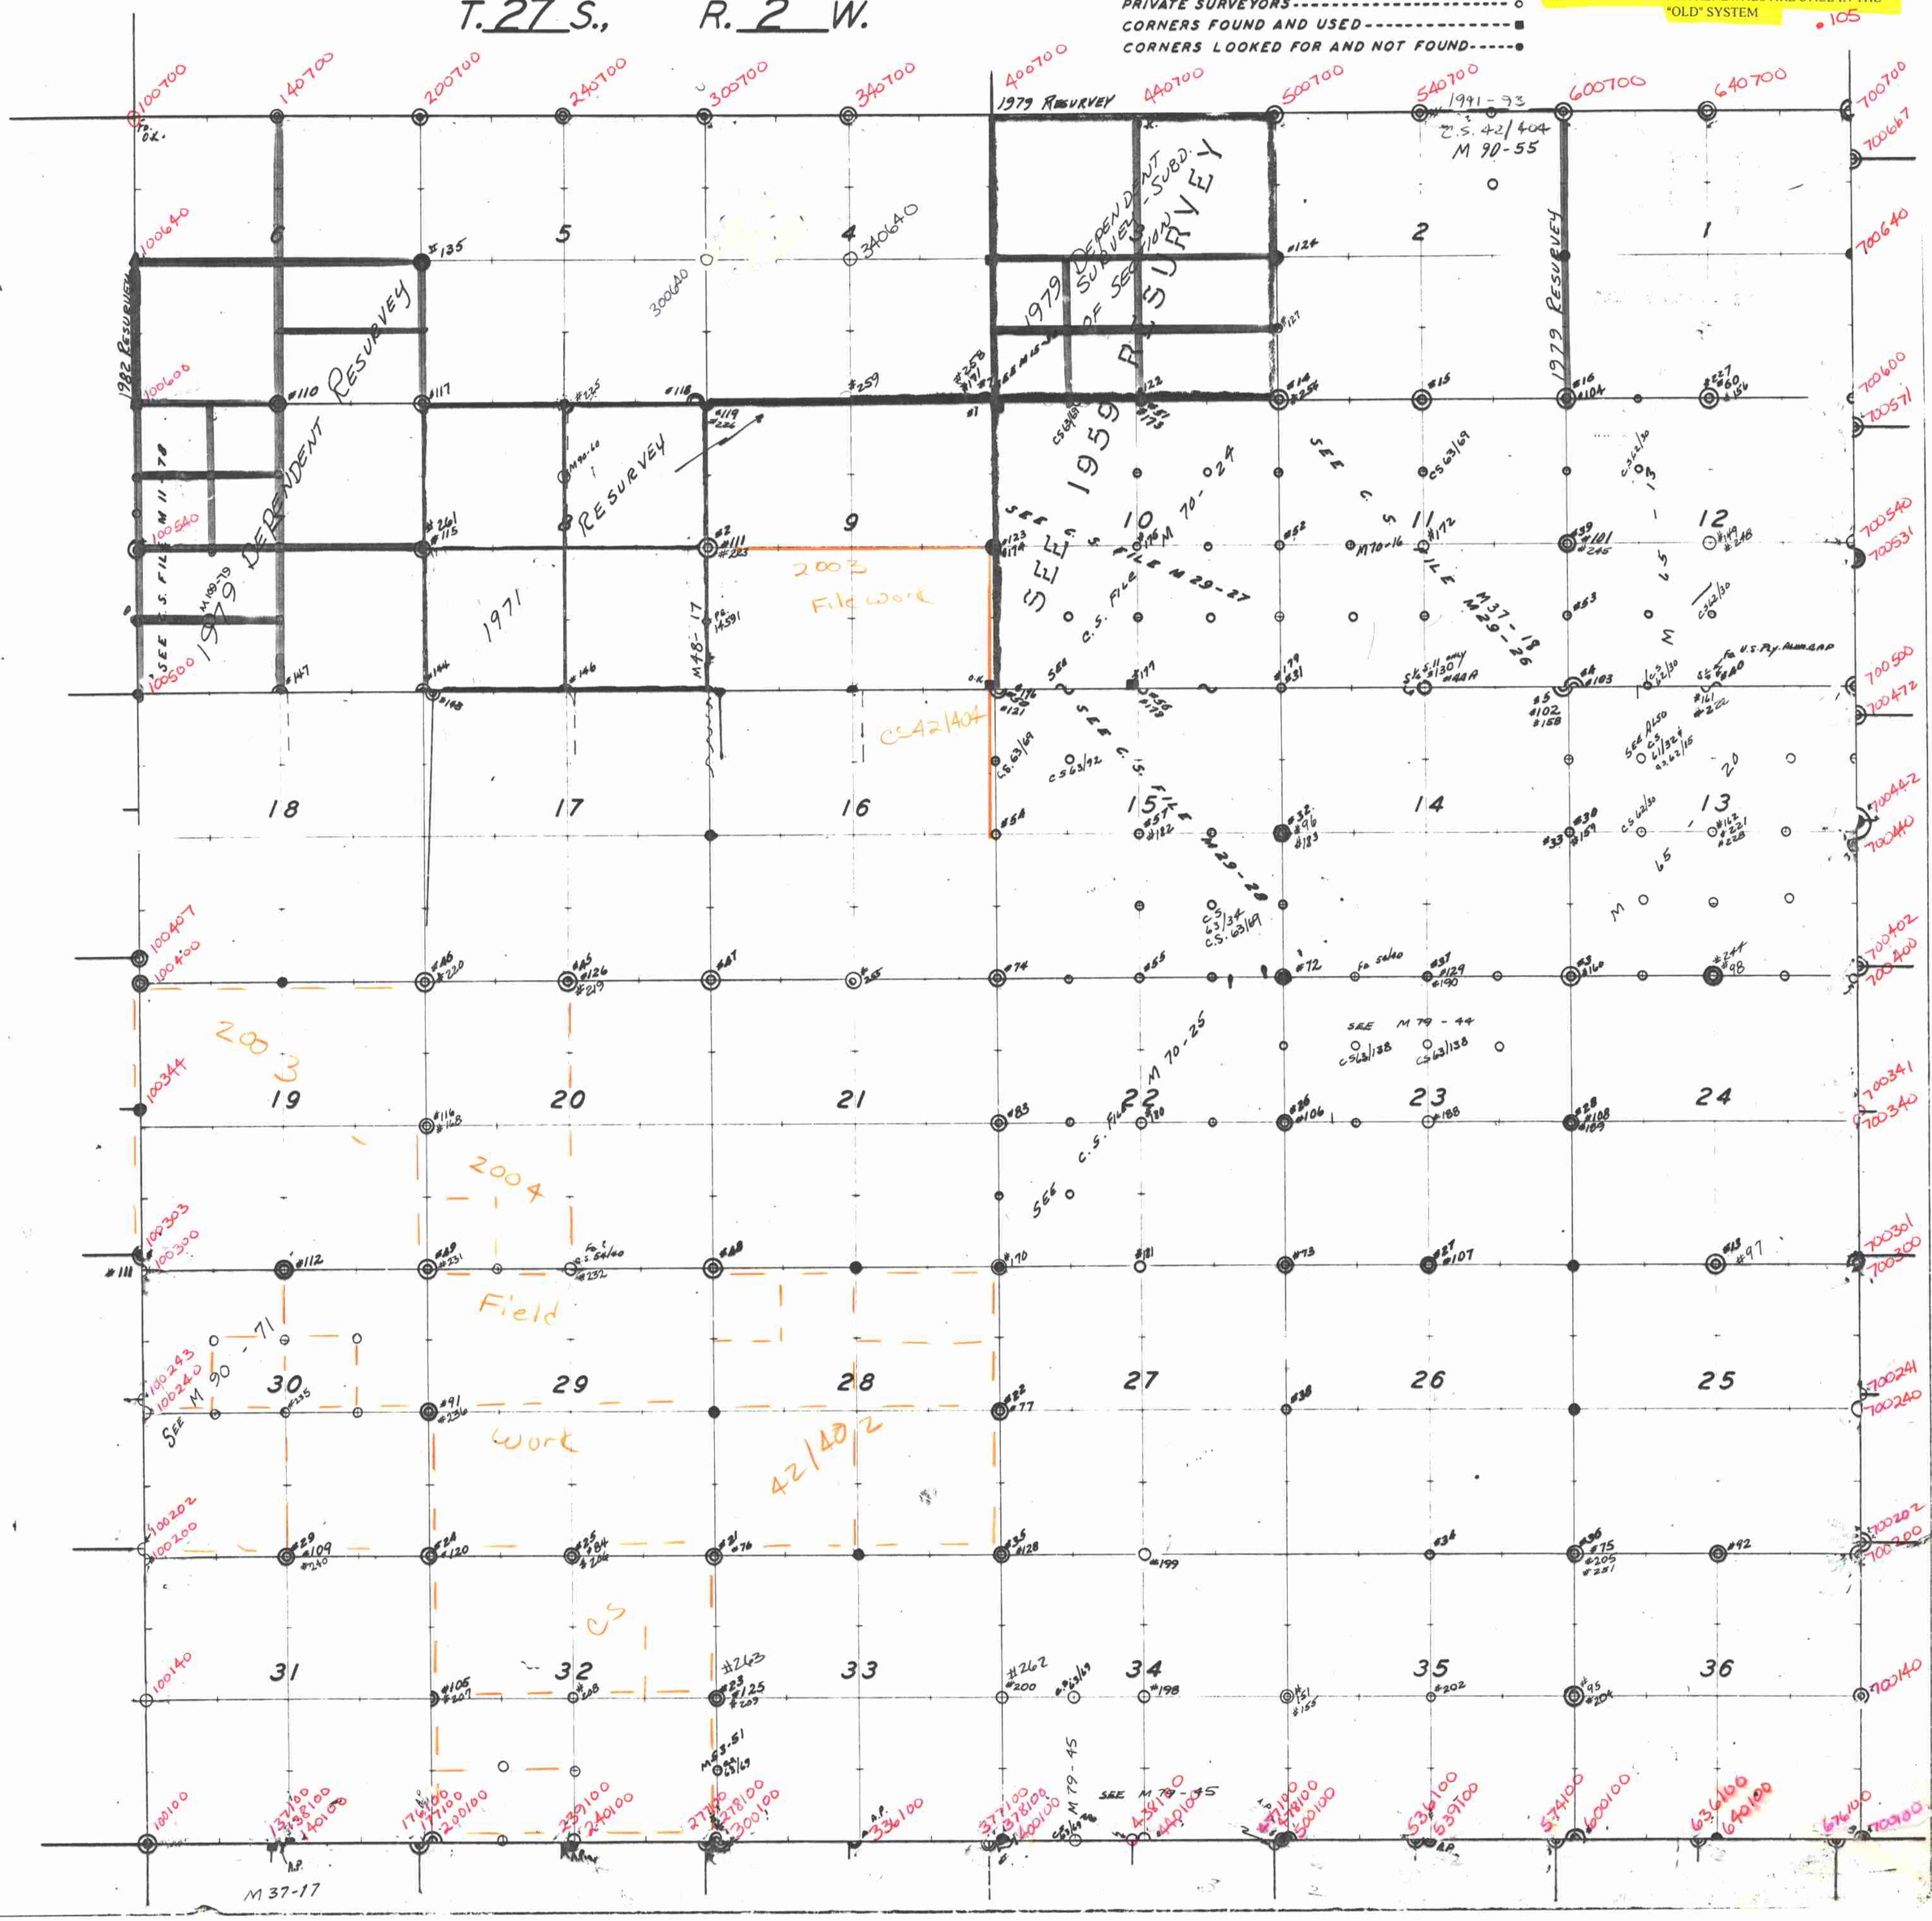
THE INTERIOR CORNER RENEWALS ARE STILL IN THE "OLD" SYSTEM