ZS 71

CORNERS RENEWED BY
BUREAU OF LAND MANAGEMENT
COUNTY SURVEYOR'S OFFICE
PRIVATE SURVEYORS
CORNERS FOUND AND USED
CORNERS LOOKED FOR AND NOT FOUND

THE BOUNDARIES ARE TYPED IN THE "NEW" SYSTEM & THE PAGES ARE IN THE BLACK BINDERS

THE INTERIOR CORNER RENEWALS ARE STILL IN THE "OLD" SYSTEM

.041
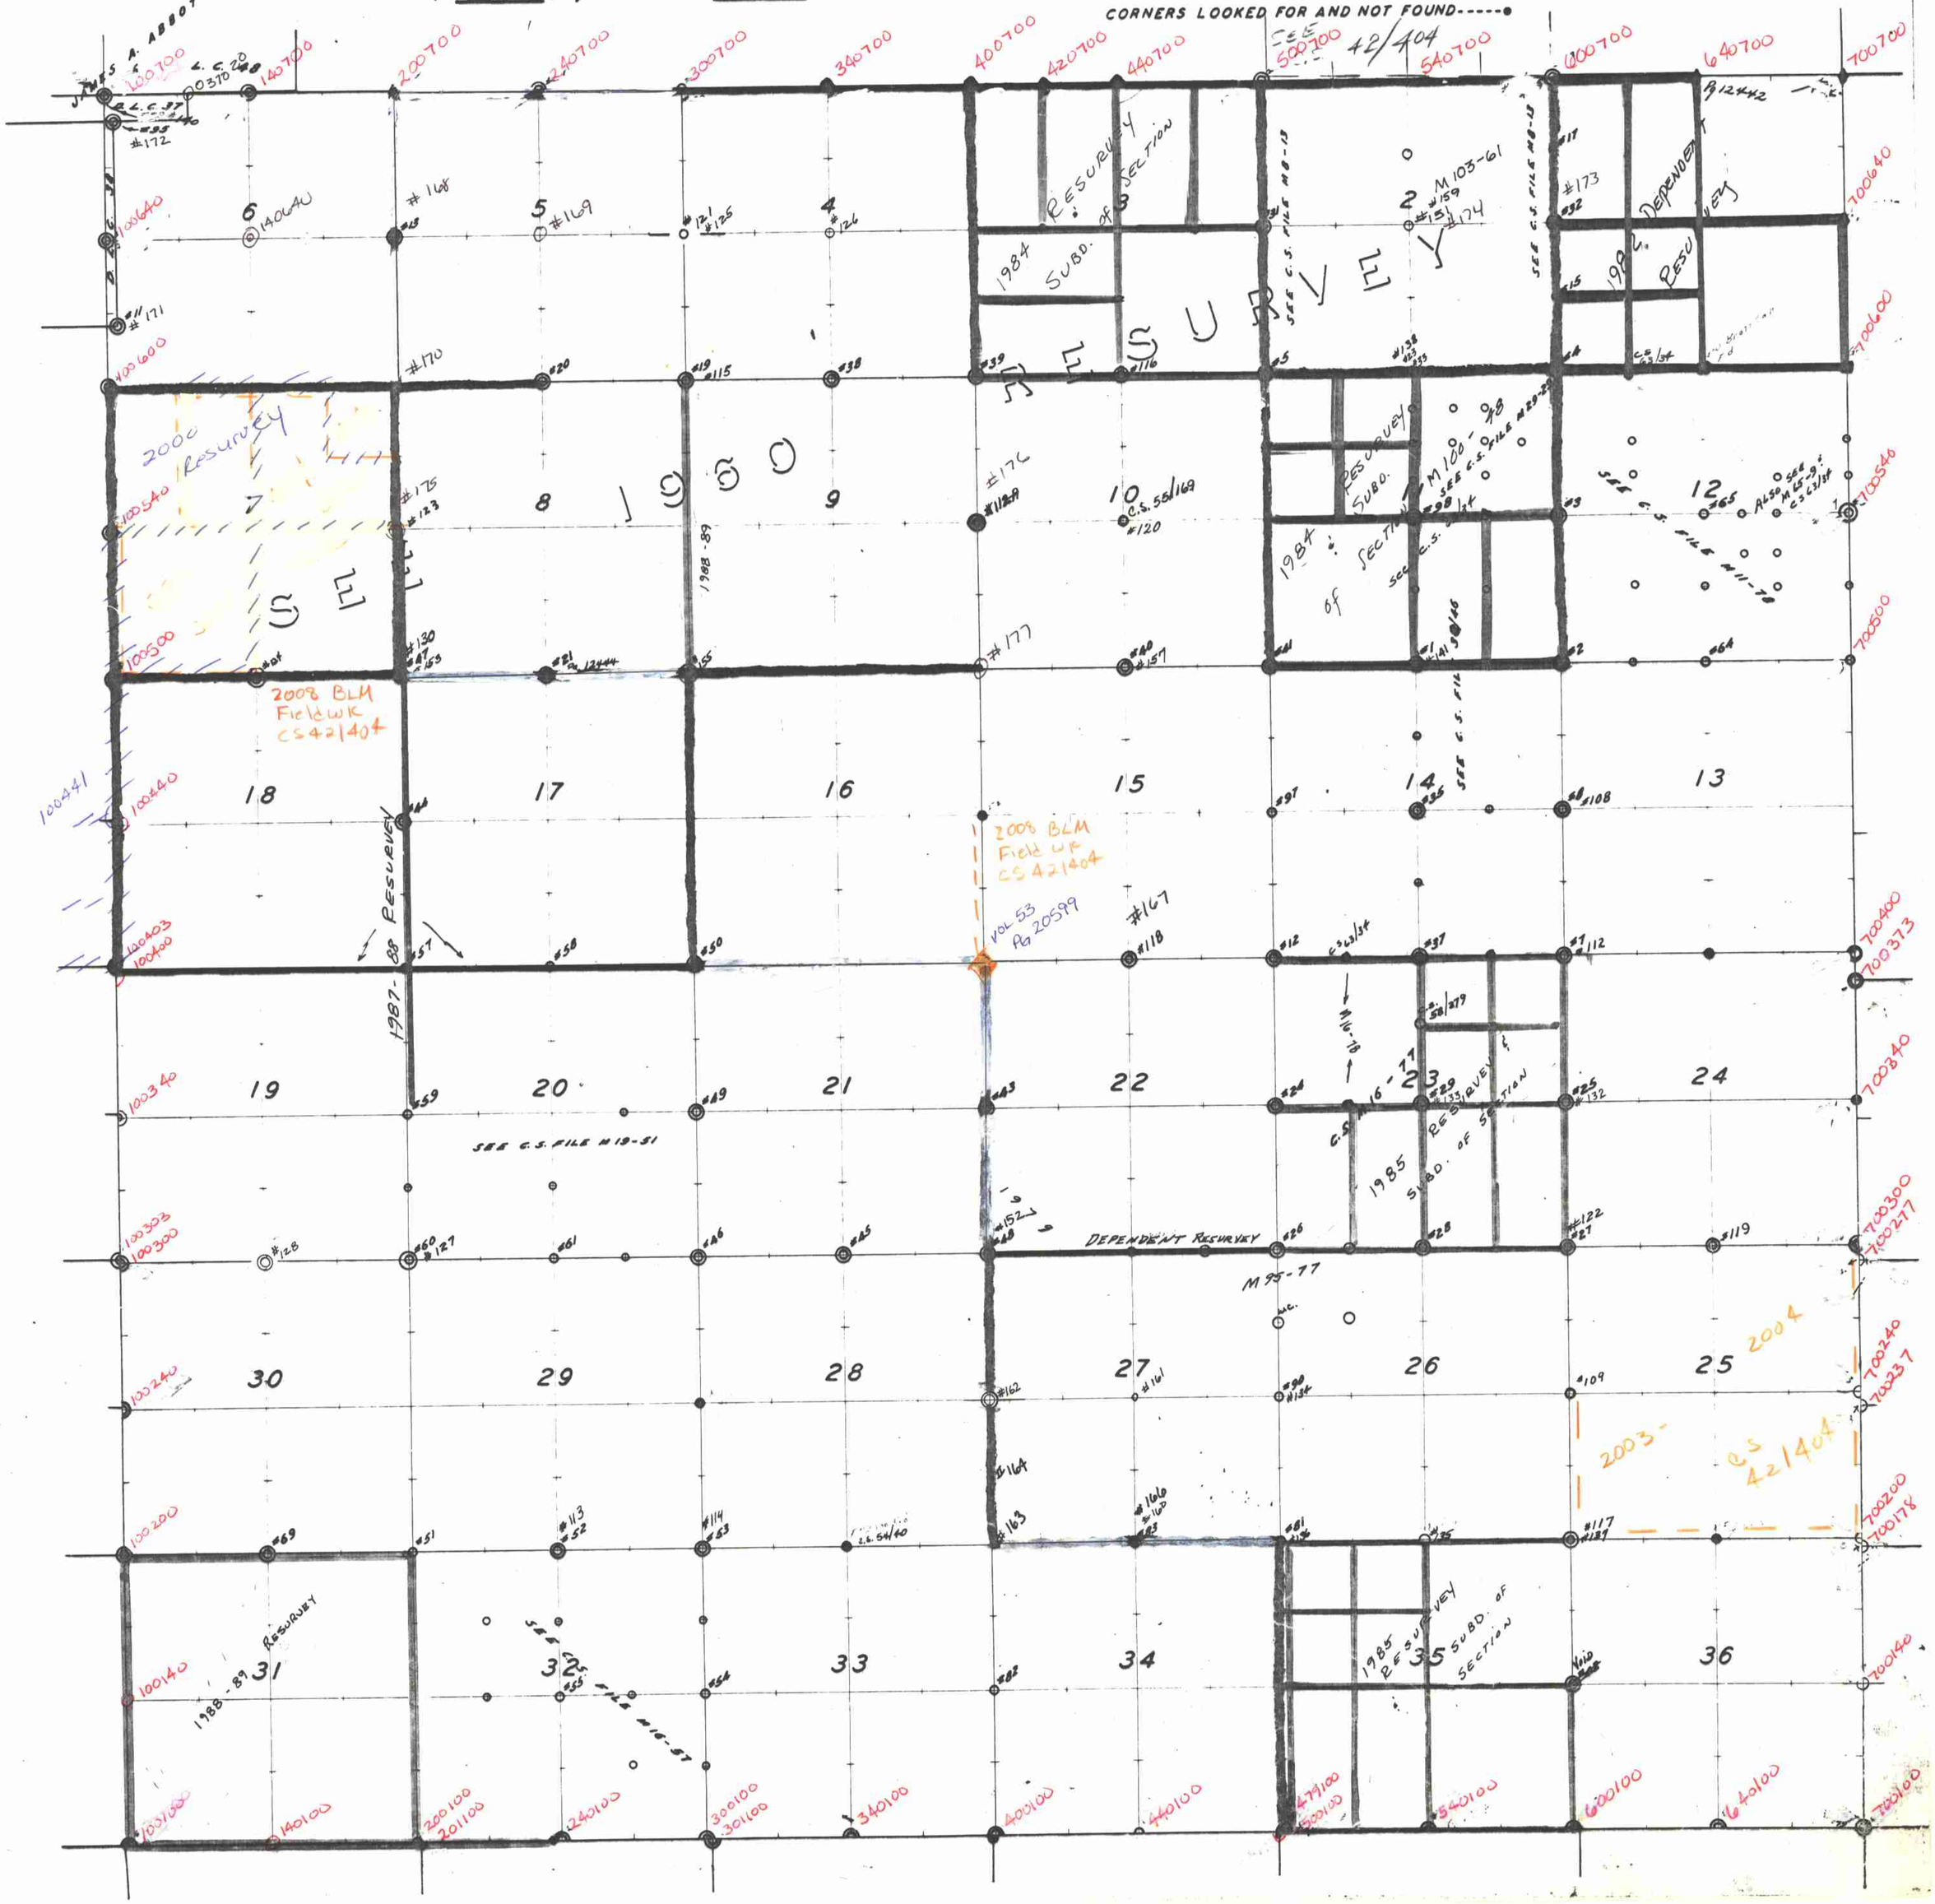
T. 27 S., R. 3 W.