75

T. 27 S., R. 3 W.
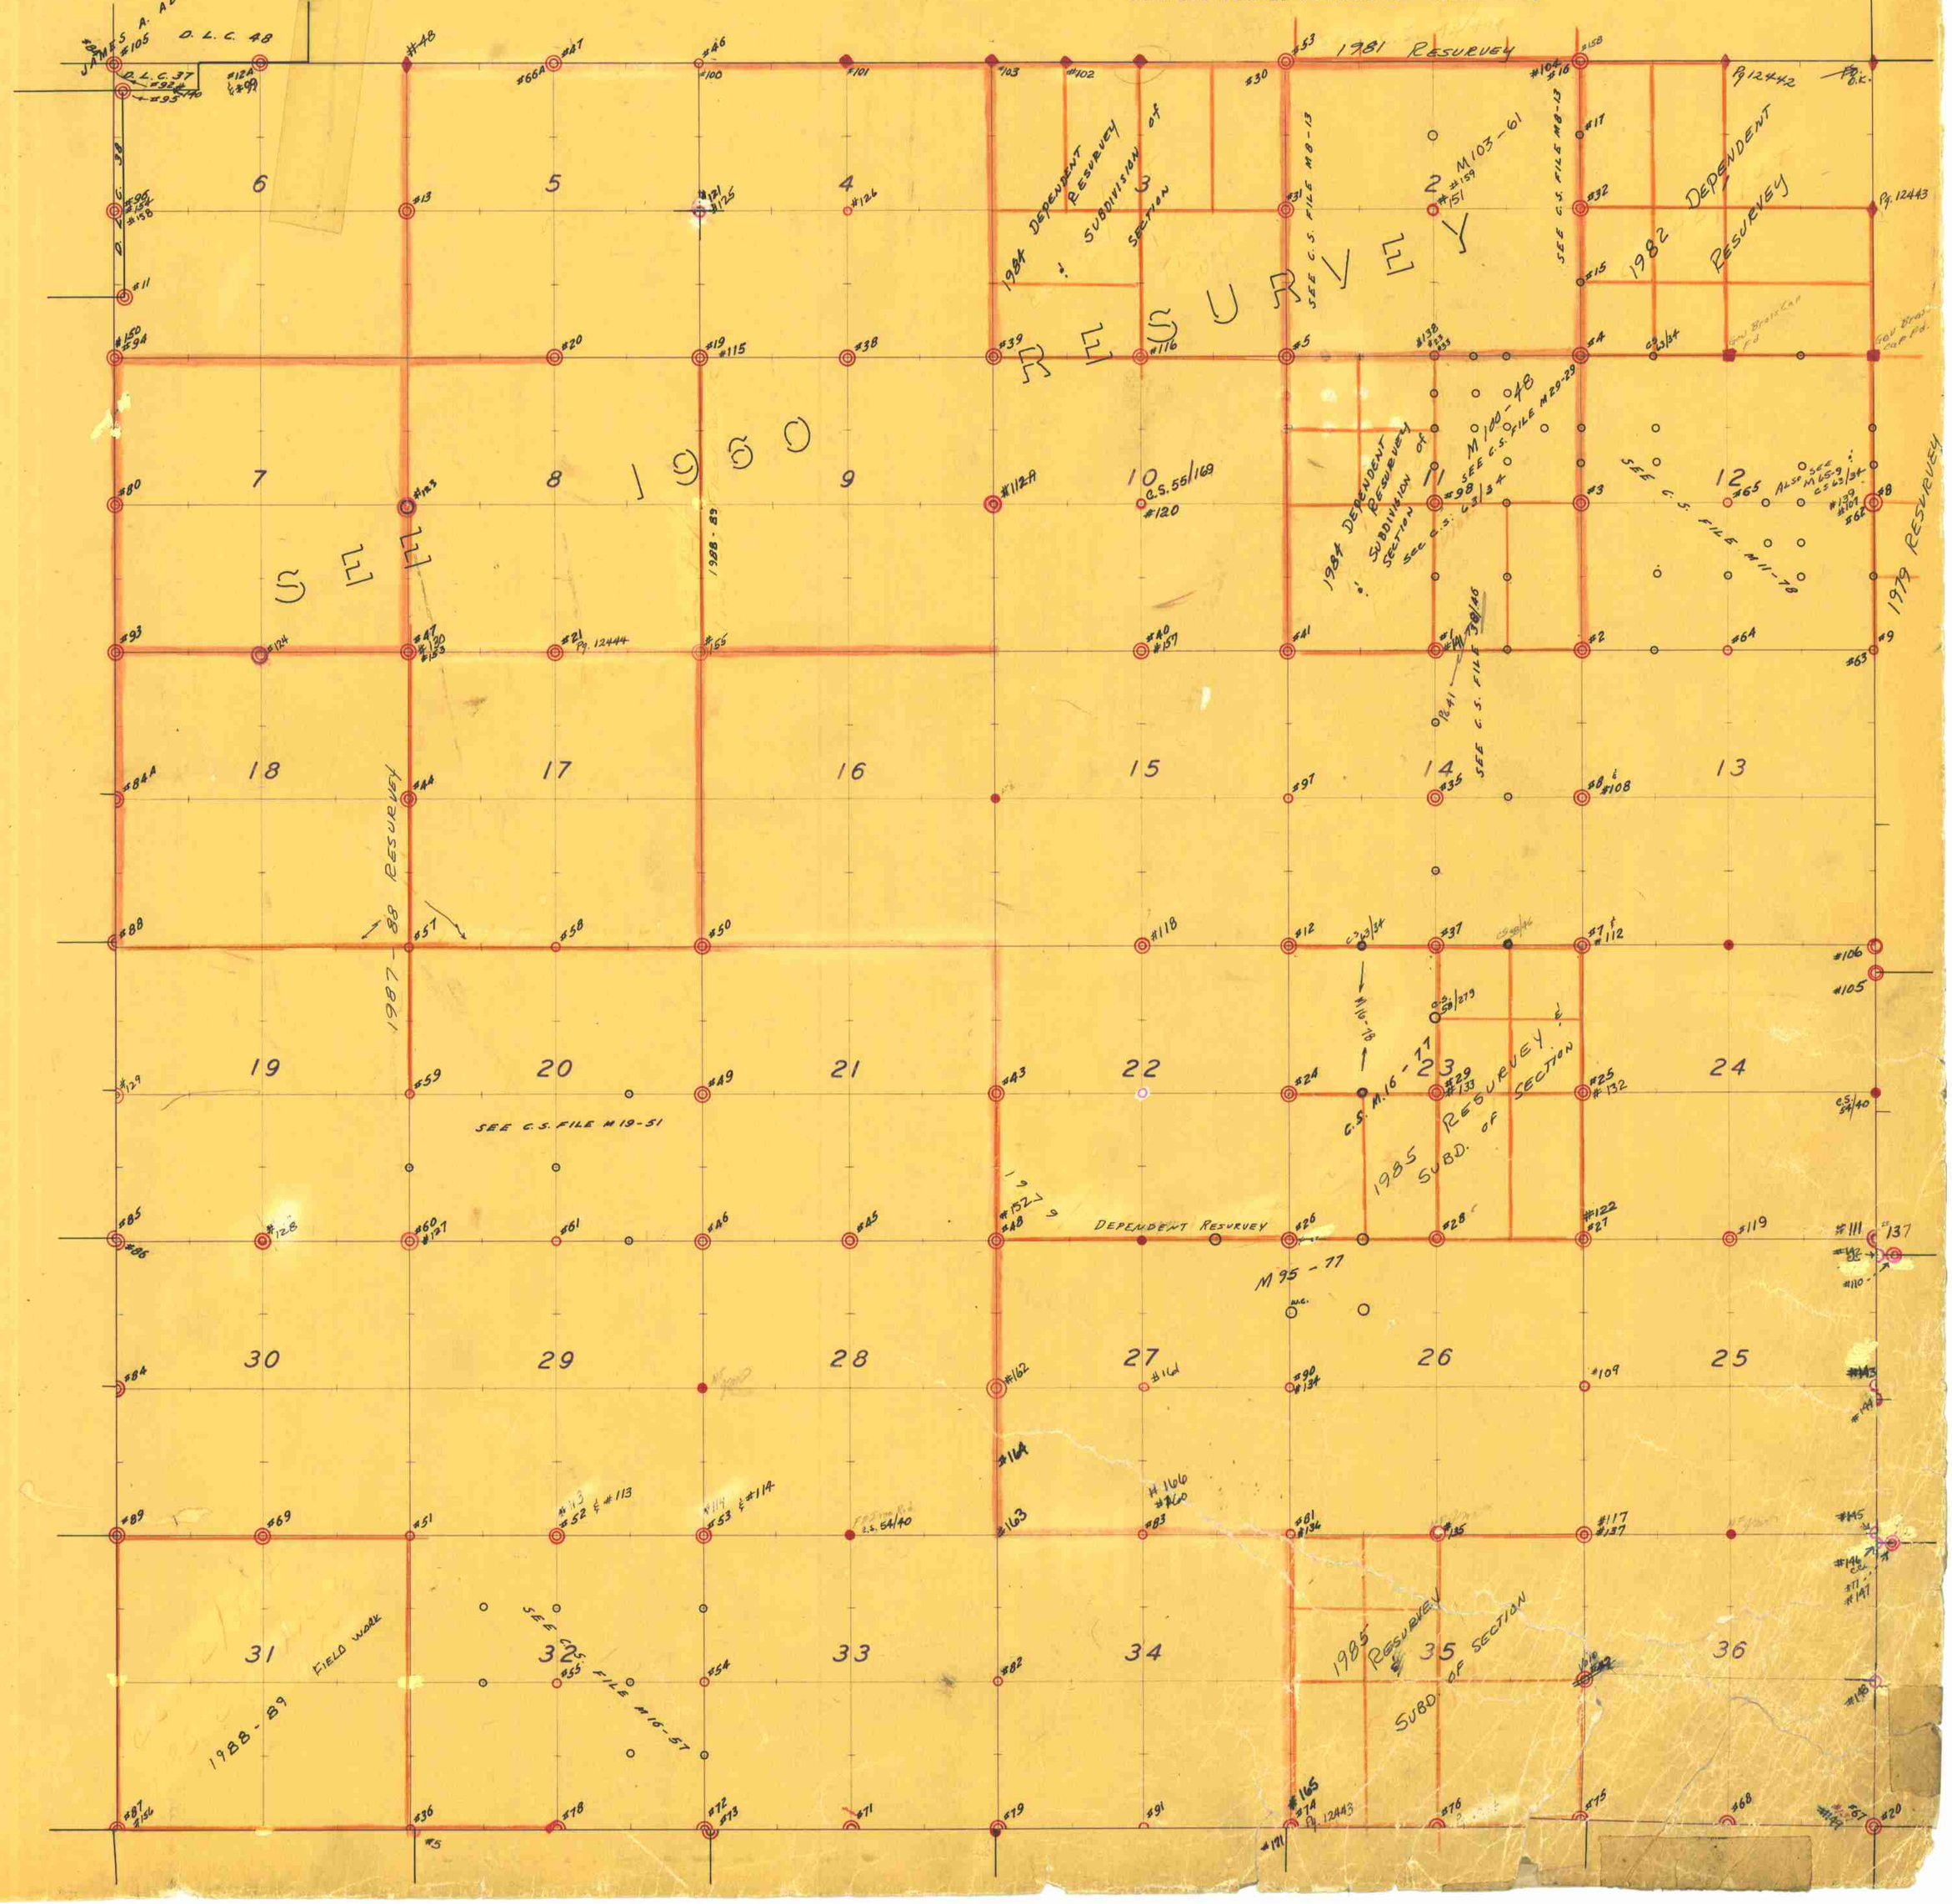
CORNERS RENEWED BY
BUREAU OF LAND MANAGEMENT ----------♦
COUNTY SURVEYOR'S OFFICE ----------◎
PRIVATE SURVEYORS ----------○
CORNERS FOUND AND USED ----------■
CORNERS LOOKED FOR AND NOT FOUND -----●