#841

T. 28 S., R. 8 W.
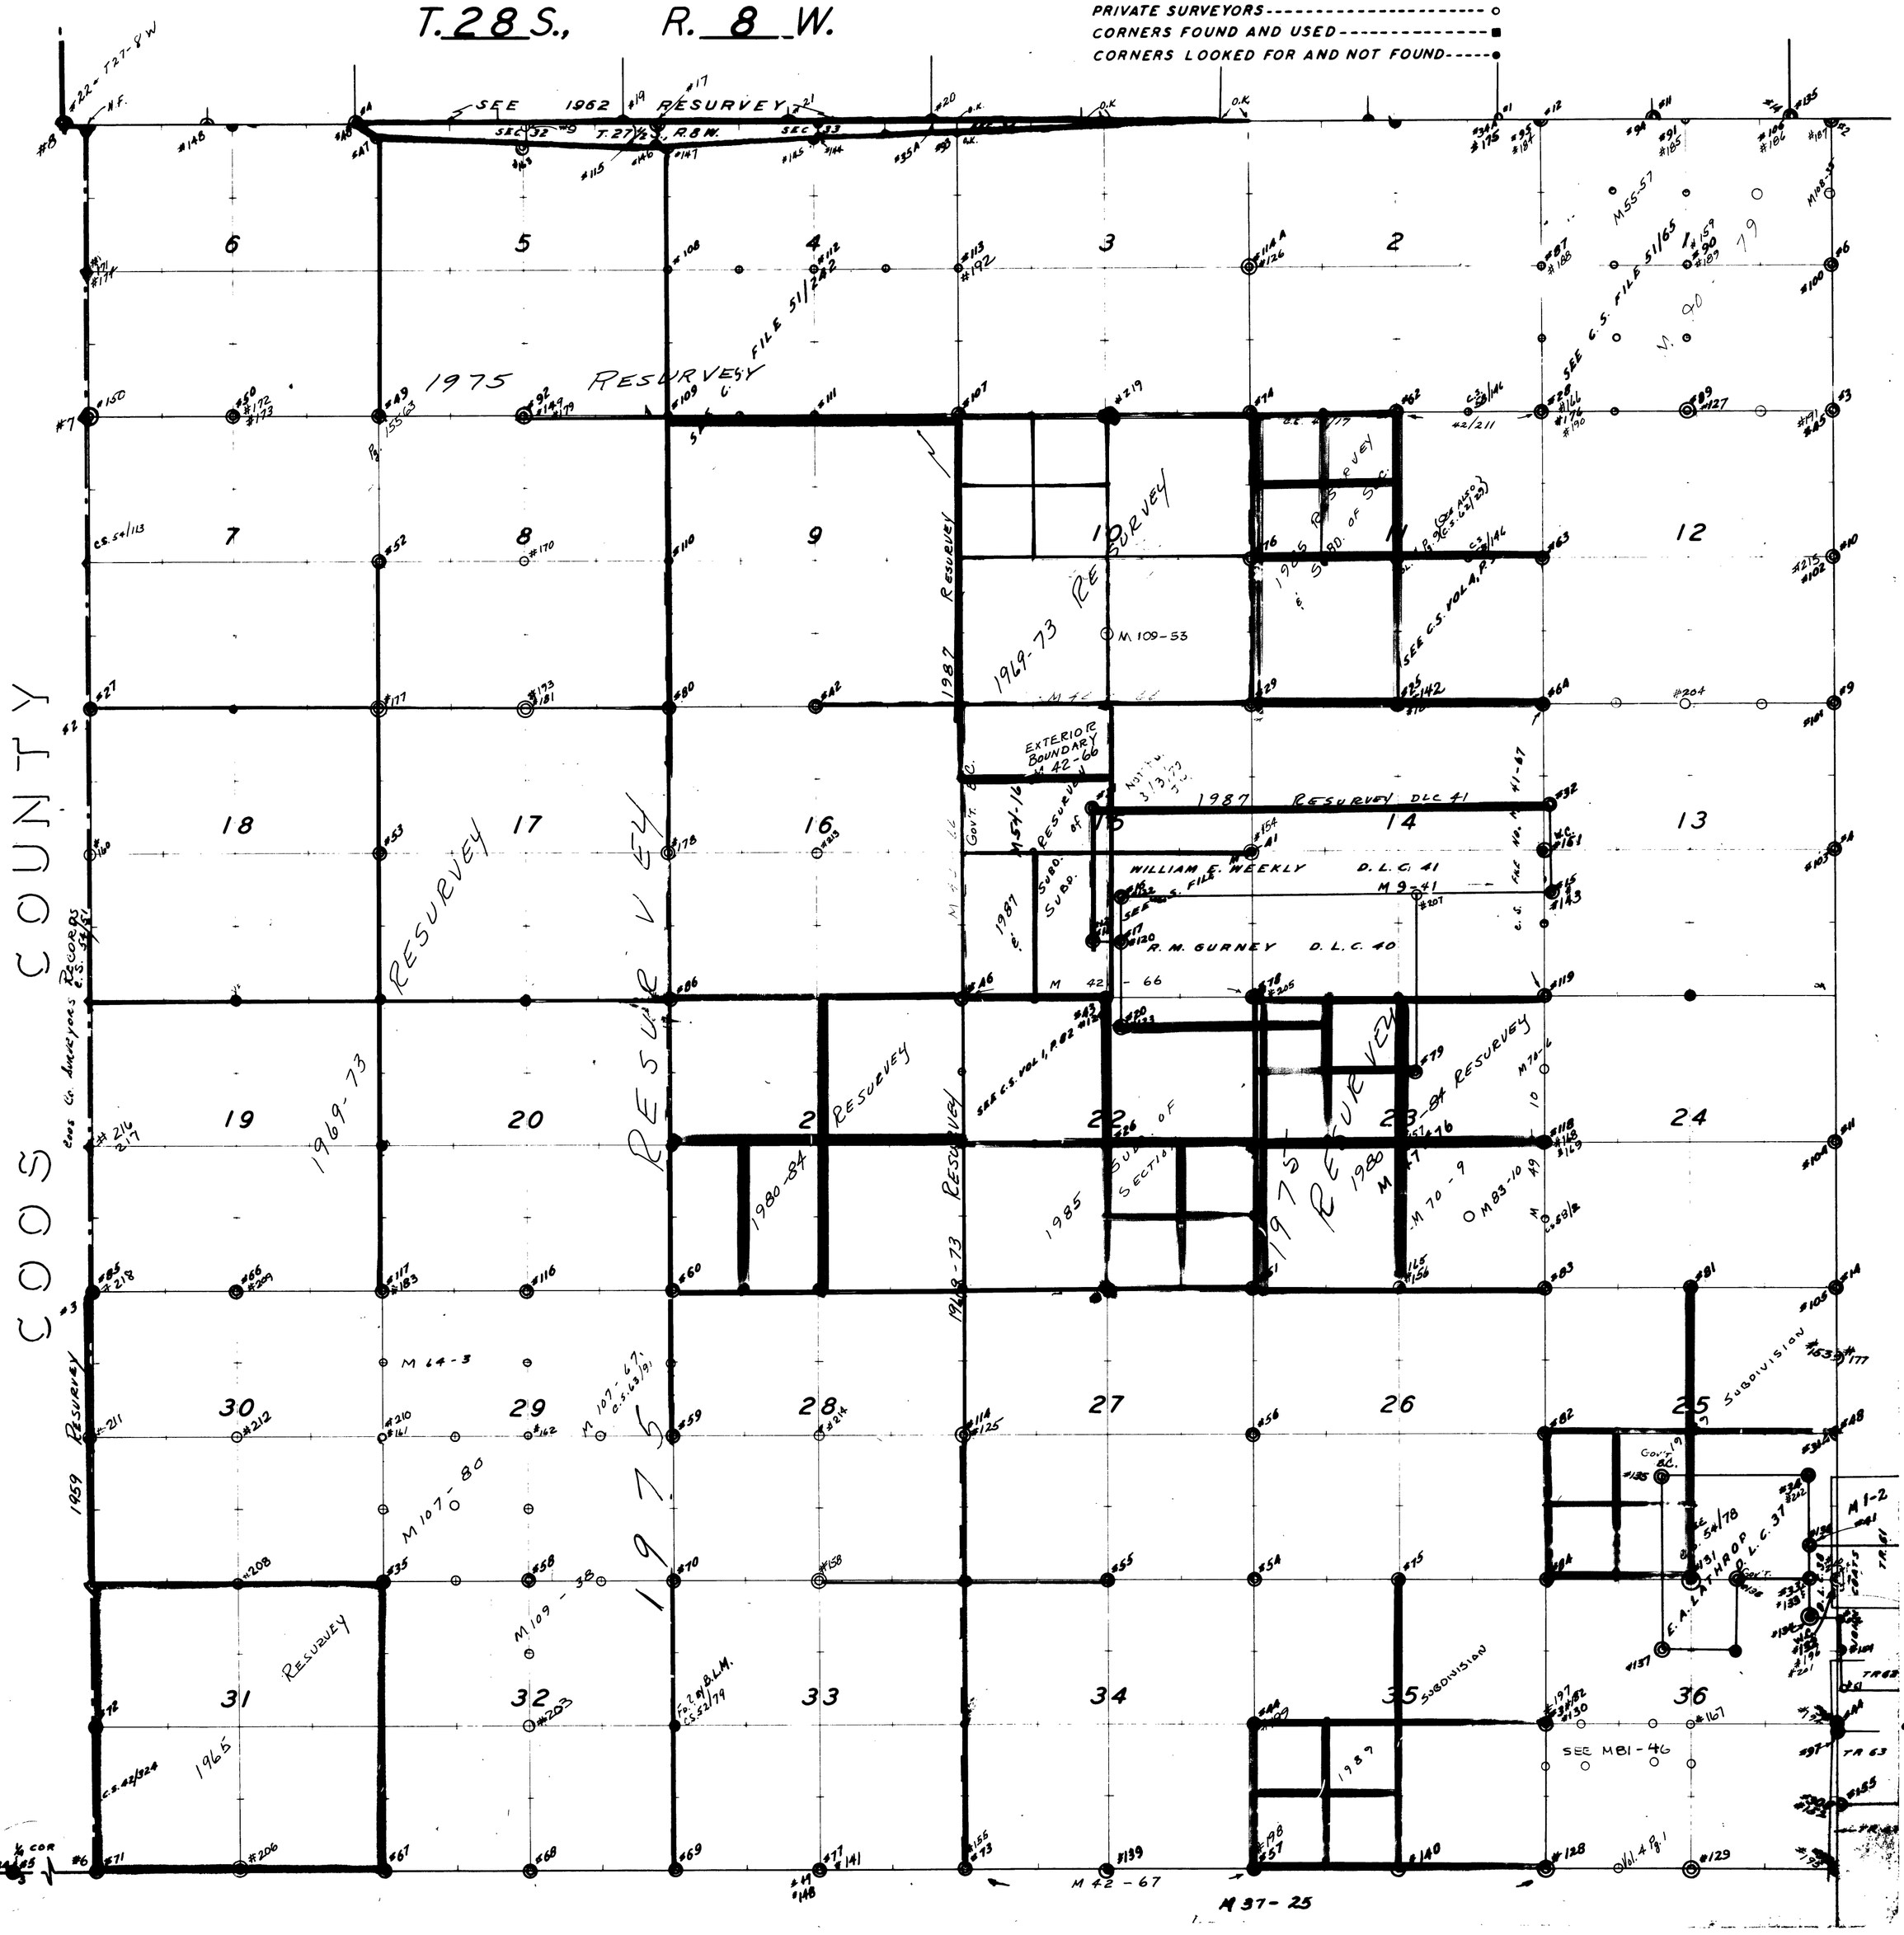
CORNERS RENEWED BY
BUREAU OF LAND MANAGEMENT
COUNTY SURVEYOR'S OFFICE
PRIVATE SURVEYORS
CORNERS FOUND AND USED
CORNERS LOOKED FOR AND NOT FOUND