


T. 28 S., R. 5 W.

CORNERS RENEWED BY
 BUREAU OF LAND MANAGEMENT -----◆
 COUNTY SURVEYOR'S OFFICE -----○
 PRIVATE SURVEYORS -----○
 CORNERS FOUND AND USED -----■
 CORNERS LOOKED FOR AND NOT FOUND -----●

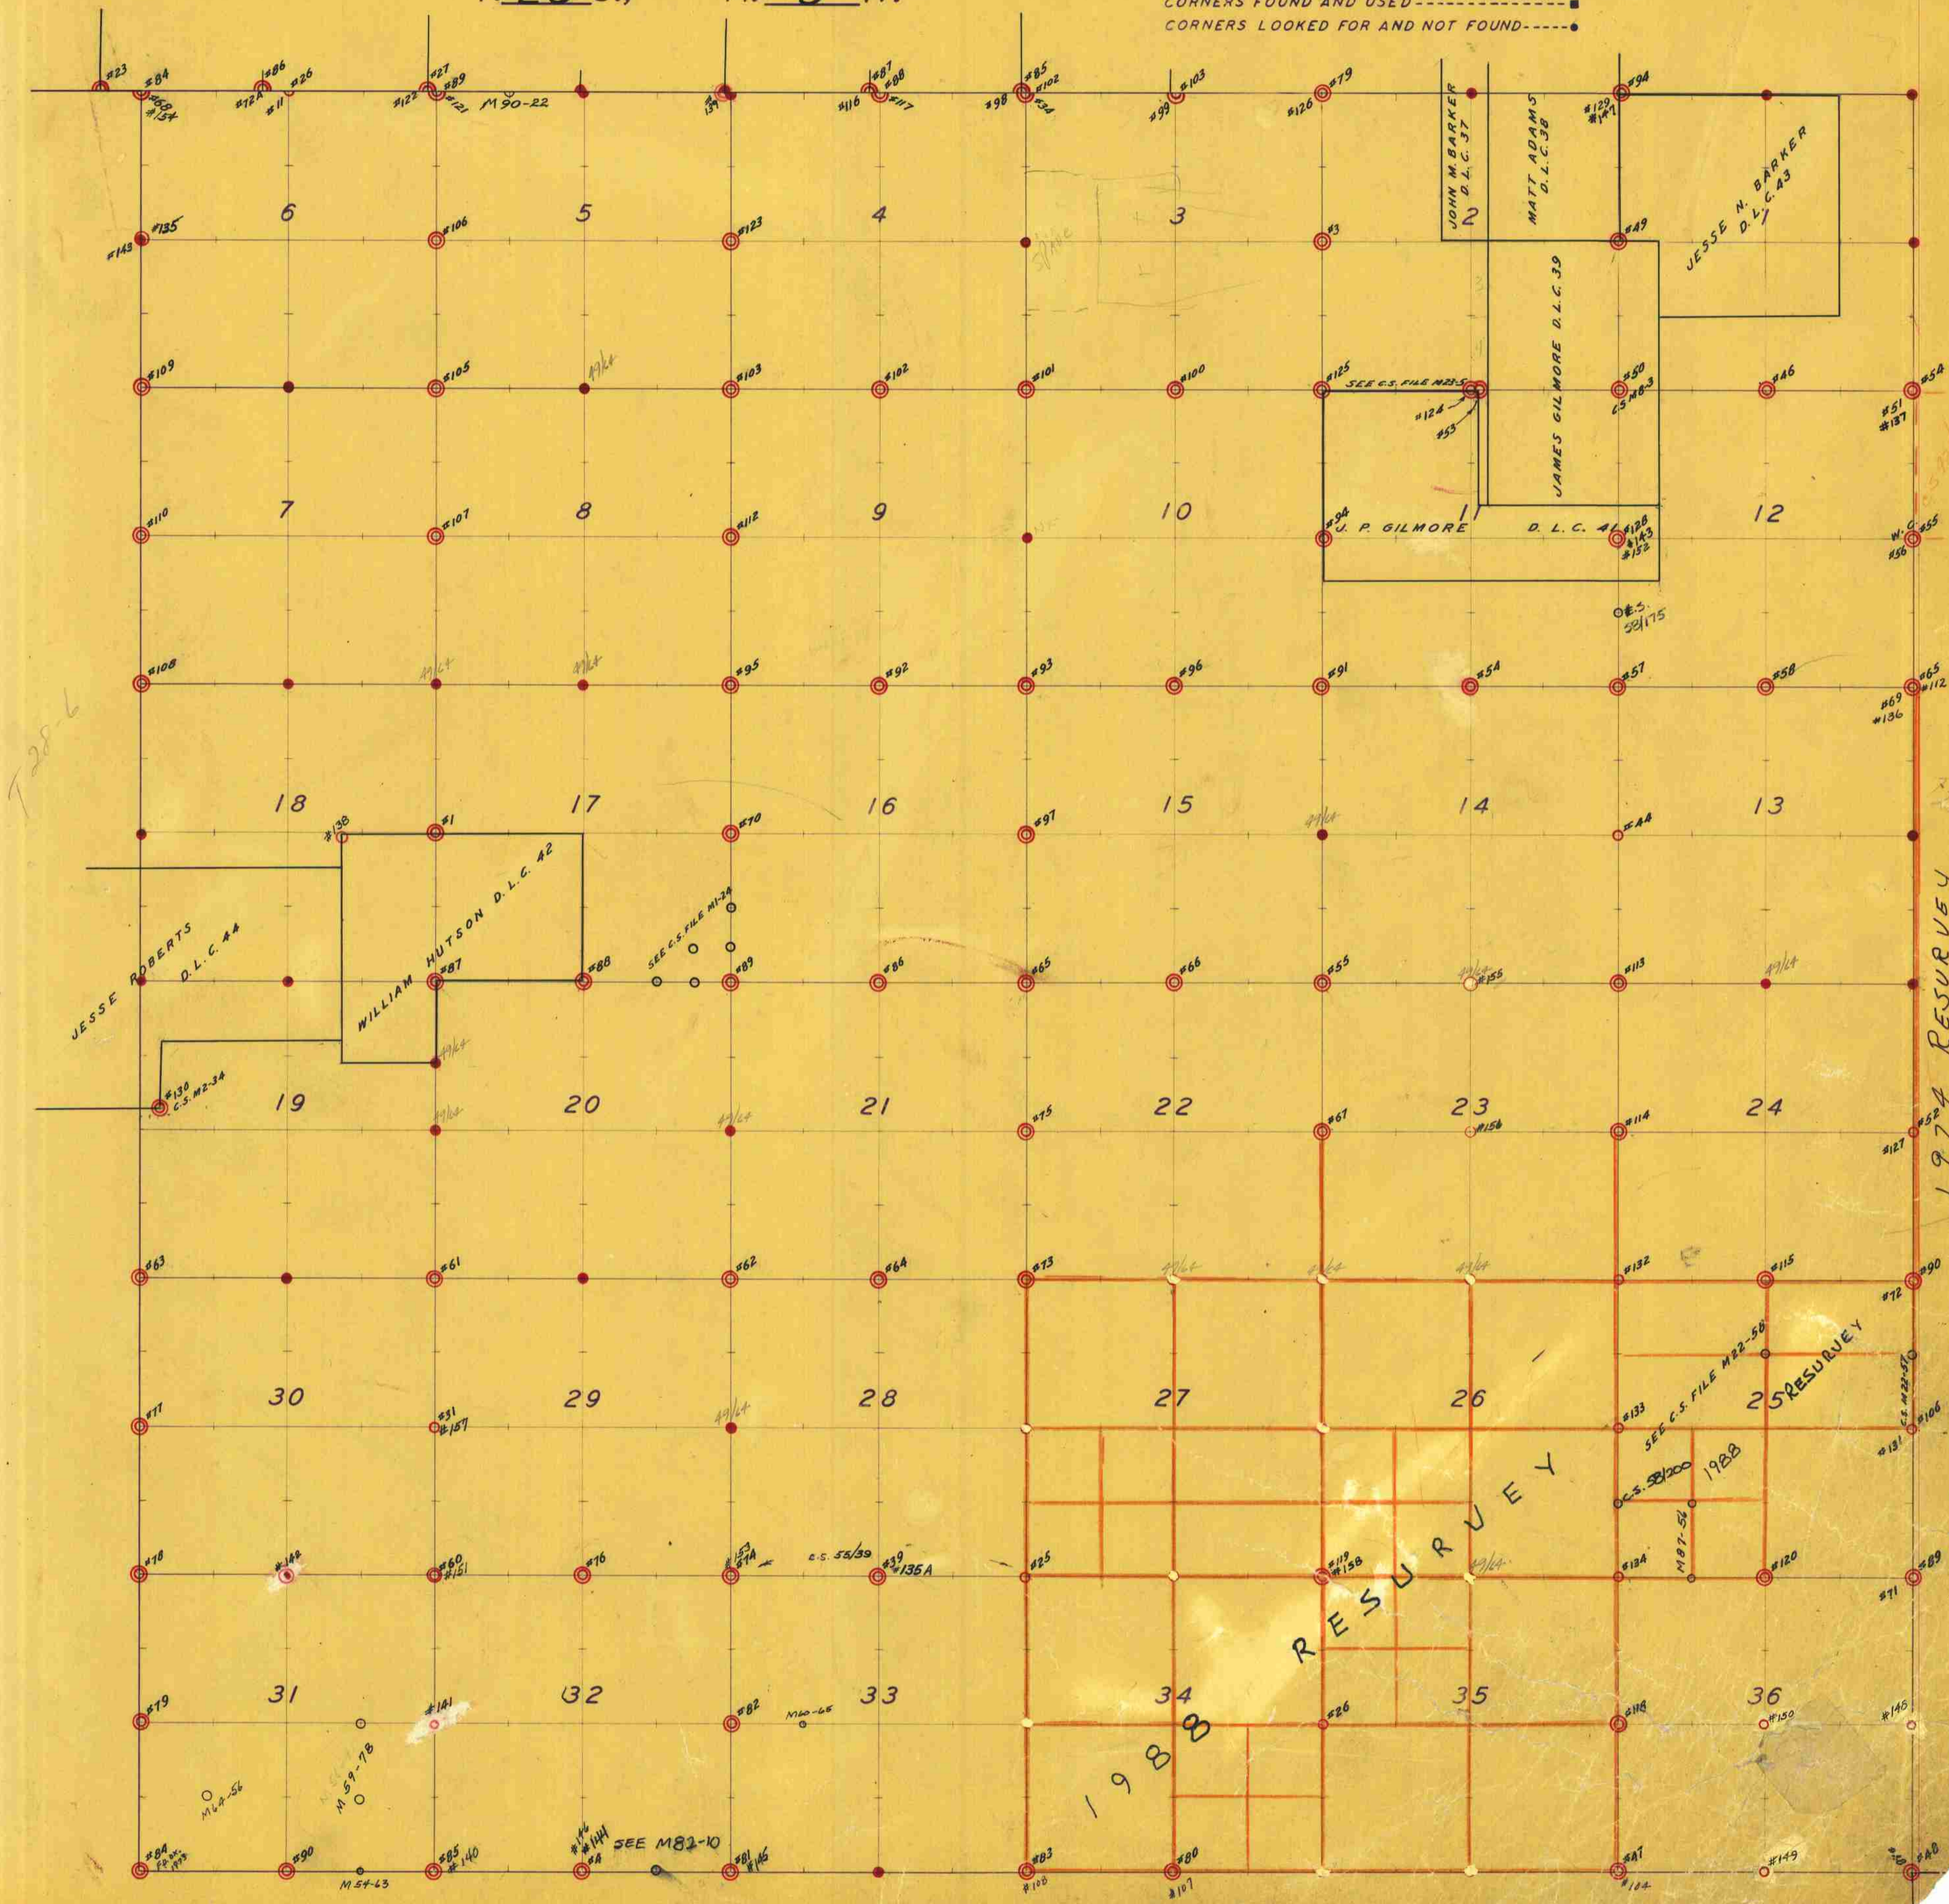

1974 RESURVEY

RESURVEY

RESURVEY

1988

T28-6

JESSE ROBERTS
D. L. C. 44

WILLIAM HUTSON
D. L. C. 42

JOHN M. BARKER
D. L. C. 37

MATT ADAMS
D. L. C. 38

JESSE N. BARKER
D. L. C. 43

JAMES GILMORE
D. L. C. 39

SEE C.S. FILE M124

SEE C.S. FILE M25

SEE C.S. FILE M22-58

C.S. 55/39

SEE M82-10

M 4-56

M 9-78

M 54-63

M 10-65

C.S. 58/200

M 7-56

C.S. M 22-51









