Douglas County Surveyor's Record of Government Corners Renewed

T. 28 S. T. S. R. 6 W. R. W. W. M.

KOKE-CHAPMAN CO., EUGENE, ORE. 21981

102

¼ Corner to Sec. 32, T28-6W. & Sec. 5, T29-6W.
Found - Both BT's. as recorded by Cole, 1915. Ren #3
N.W. BT., now 30" Fir Stump, cut high, shows good bark scribing "¼ S32". S.E. Maple BT., now down.
Note - Corner is 6 ft. North of E. W. Fence.
Set - Brass Cap at Cor. Mkd: County Surveyor's Office, 1962 S32 / S 5 T28S T29S R6W
New BT's: 14" Maple bears S.52°E. 23.0 ft. scribed ¼ S5 CS BT.
13" R. Fir bears N.1½°E. 62.5 ft. scribed ¼ S32 CS BT.

- - - - - - - - - - - -

103

¼ Corner to Sec. 31, T28-6W. & Sec. 6, T29S-6W.
Found - Orig. 15", now 24" Oak, down & out of position, has reverse scribe.
Orig. 15", now 20", high cut, stump, Oak. We open & find good scribe.
Set - Brass Cap at Cor. Mkd: County Surveyor's Office, 1962 ¼ S31 / S 6 T28S T29S R6W
New BT's: 20" R.Fir bears S.17°W. 9.0 ft. scribed ¼ S6 CS BT.
19" R.Fir bears N.46°E. 30.0 ft. scribed ¼ S31 CS BT.
Fence Corner Thus:

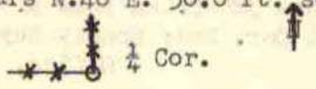

- - - - - - - - - - - -

104

¼ Cor. Sec. 34, T28-6W. & Sec. 3, T29-6W.
Found - Orig. 15", now down, large Oak S.47°E. 76.0 ft. We find good reverse scribing on old section near base "¼S".
Now 36" B.O. N.56°E.82.1 ft., shows good scars, recorded by Cole.
Find 5/8" Bolt at Corner. Ren #15
Set - Brass Cap alongside Bolt & Mkd: County Surveyor's Office, 1961 ¼ S34 / S 3 T28S T29S R6W
New BT's: 6" W.Oak bears S.35°E. 18.2 ft. scribed ¼ S3 CS BT.
14" W.Oak bears N.3½°E. 42.2 ft. scribed ¼ S34 CS BT.

- - - - - - - - - - - -

105

¼ Corner to Sections 34 and 35.
Found - Now 14" B.Oak North not South 6.6 ft. Ren #23 We open & find good scribing "CS ¼S". We do not find either Orig. B.T.
Set - Brass Cap at Cor. Mkd: County Surveyor's Office, 1961 ¼ S34/S35 T28S R6W.
New BT's: 6" W.Oak bears S.87°E. 12.0 ft. scribed ¼ S35 CS BT.
26" R. Fir bears N.58½°W. 51.6 ft. scribed ¼ S34 CS BT.

- - - - - - - - - - - -

106

¼ Corner to Sections 28 and 33.
Found - Stump shell that fits orig. N.E. BT. & impression in ground that fits S.E. BT. Choppen open & found scribing "¼S" on 40" Laurel, set by Cole, 1921. Did not find ½" I. Pipe. Ren #13
10" Oak scribed by Cole showing good scars to be an 18" W. Oak bearing S.29°E. 45.0 ft.
40" Laurel fits Orig. BT., remains. Also is alive & standing.
Set - Brass Cap at Fence Cor. Mkd: County Surveyor's Office, 1961 ¼ S28 / S33 T28S R6W
Fence running N. S. & W.
New BT: 8" W.Oak N.10½°E. 21.8 ft. scribed ¼ S28 CS BT.

#173

RE-RENEWED, SEE CORNER NO.

- - - - - - - - - - - -

107

¼ Section Corner to Sections 27 and 34.
Found - Orig. 10", now 18" B.Oak Snag N.43°E. 113.5 ft. We open & find good scribing "4". N.W. BT. now down.
Set - Brass Cap at Cor. Mkd: County Surveyor's Office, 1961 ¼ S27 / S34 T28S R6W
New BT's: 12" R.Fir bears N.87°W. 10.0 ft. scribed ¼ S27 CS BT.
16" Fir R. bears S.2°W. 29.5 ft. scribed ¼ S34 CS BT.

- - - - - - - - - - - -

108

Section Corner to Sections 27 - 28 - 33 - 34.
Found - Orig. 16", now 30" B.O. N.50°W. 11C.0 ft., open & find good scribe"S". Also find remnants & Stump Holes for S.W., N.E. & S. E. BT's.
Set - Brass Cap at Cor. Mkd: County Surveyor's Office, 1961 S28 | S27 / S33 | S34 T28S R6W
New BT's: 10" W.Oak bears N.15°E. 19.8 ft. scribed S27 T28S R6W CS BT.
22" R.Fir bears S.24°E. 32.9 ft. scribed S34 T28S R6W CS BT.
7" Laurel bears S.46½°W. 19.0 ft. scribed S33 CS BT.
16" R.Fir bears N.73°W. 30.2 ft. scribed S25 T28S R6W CS BT.

#174

RE-RENEWED, SEE CORNER NO

- - - - - - - - - - - -

James W. Byron, Deputy County Surveyor
Dale McFarland and John Powell
December 1961 C. S. File No. 49/139