84

T. 28 S., R. 7 & 7½ W.
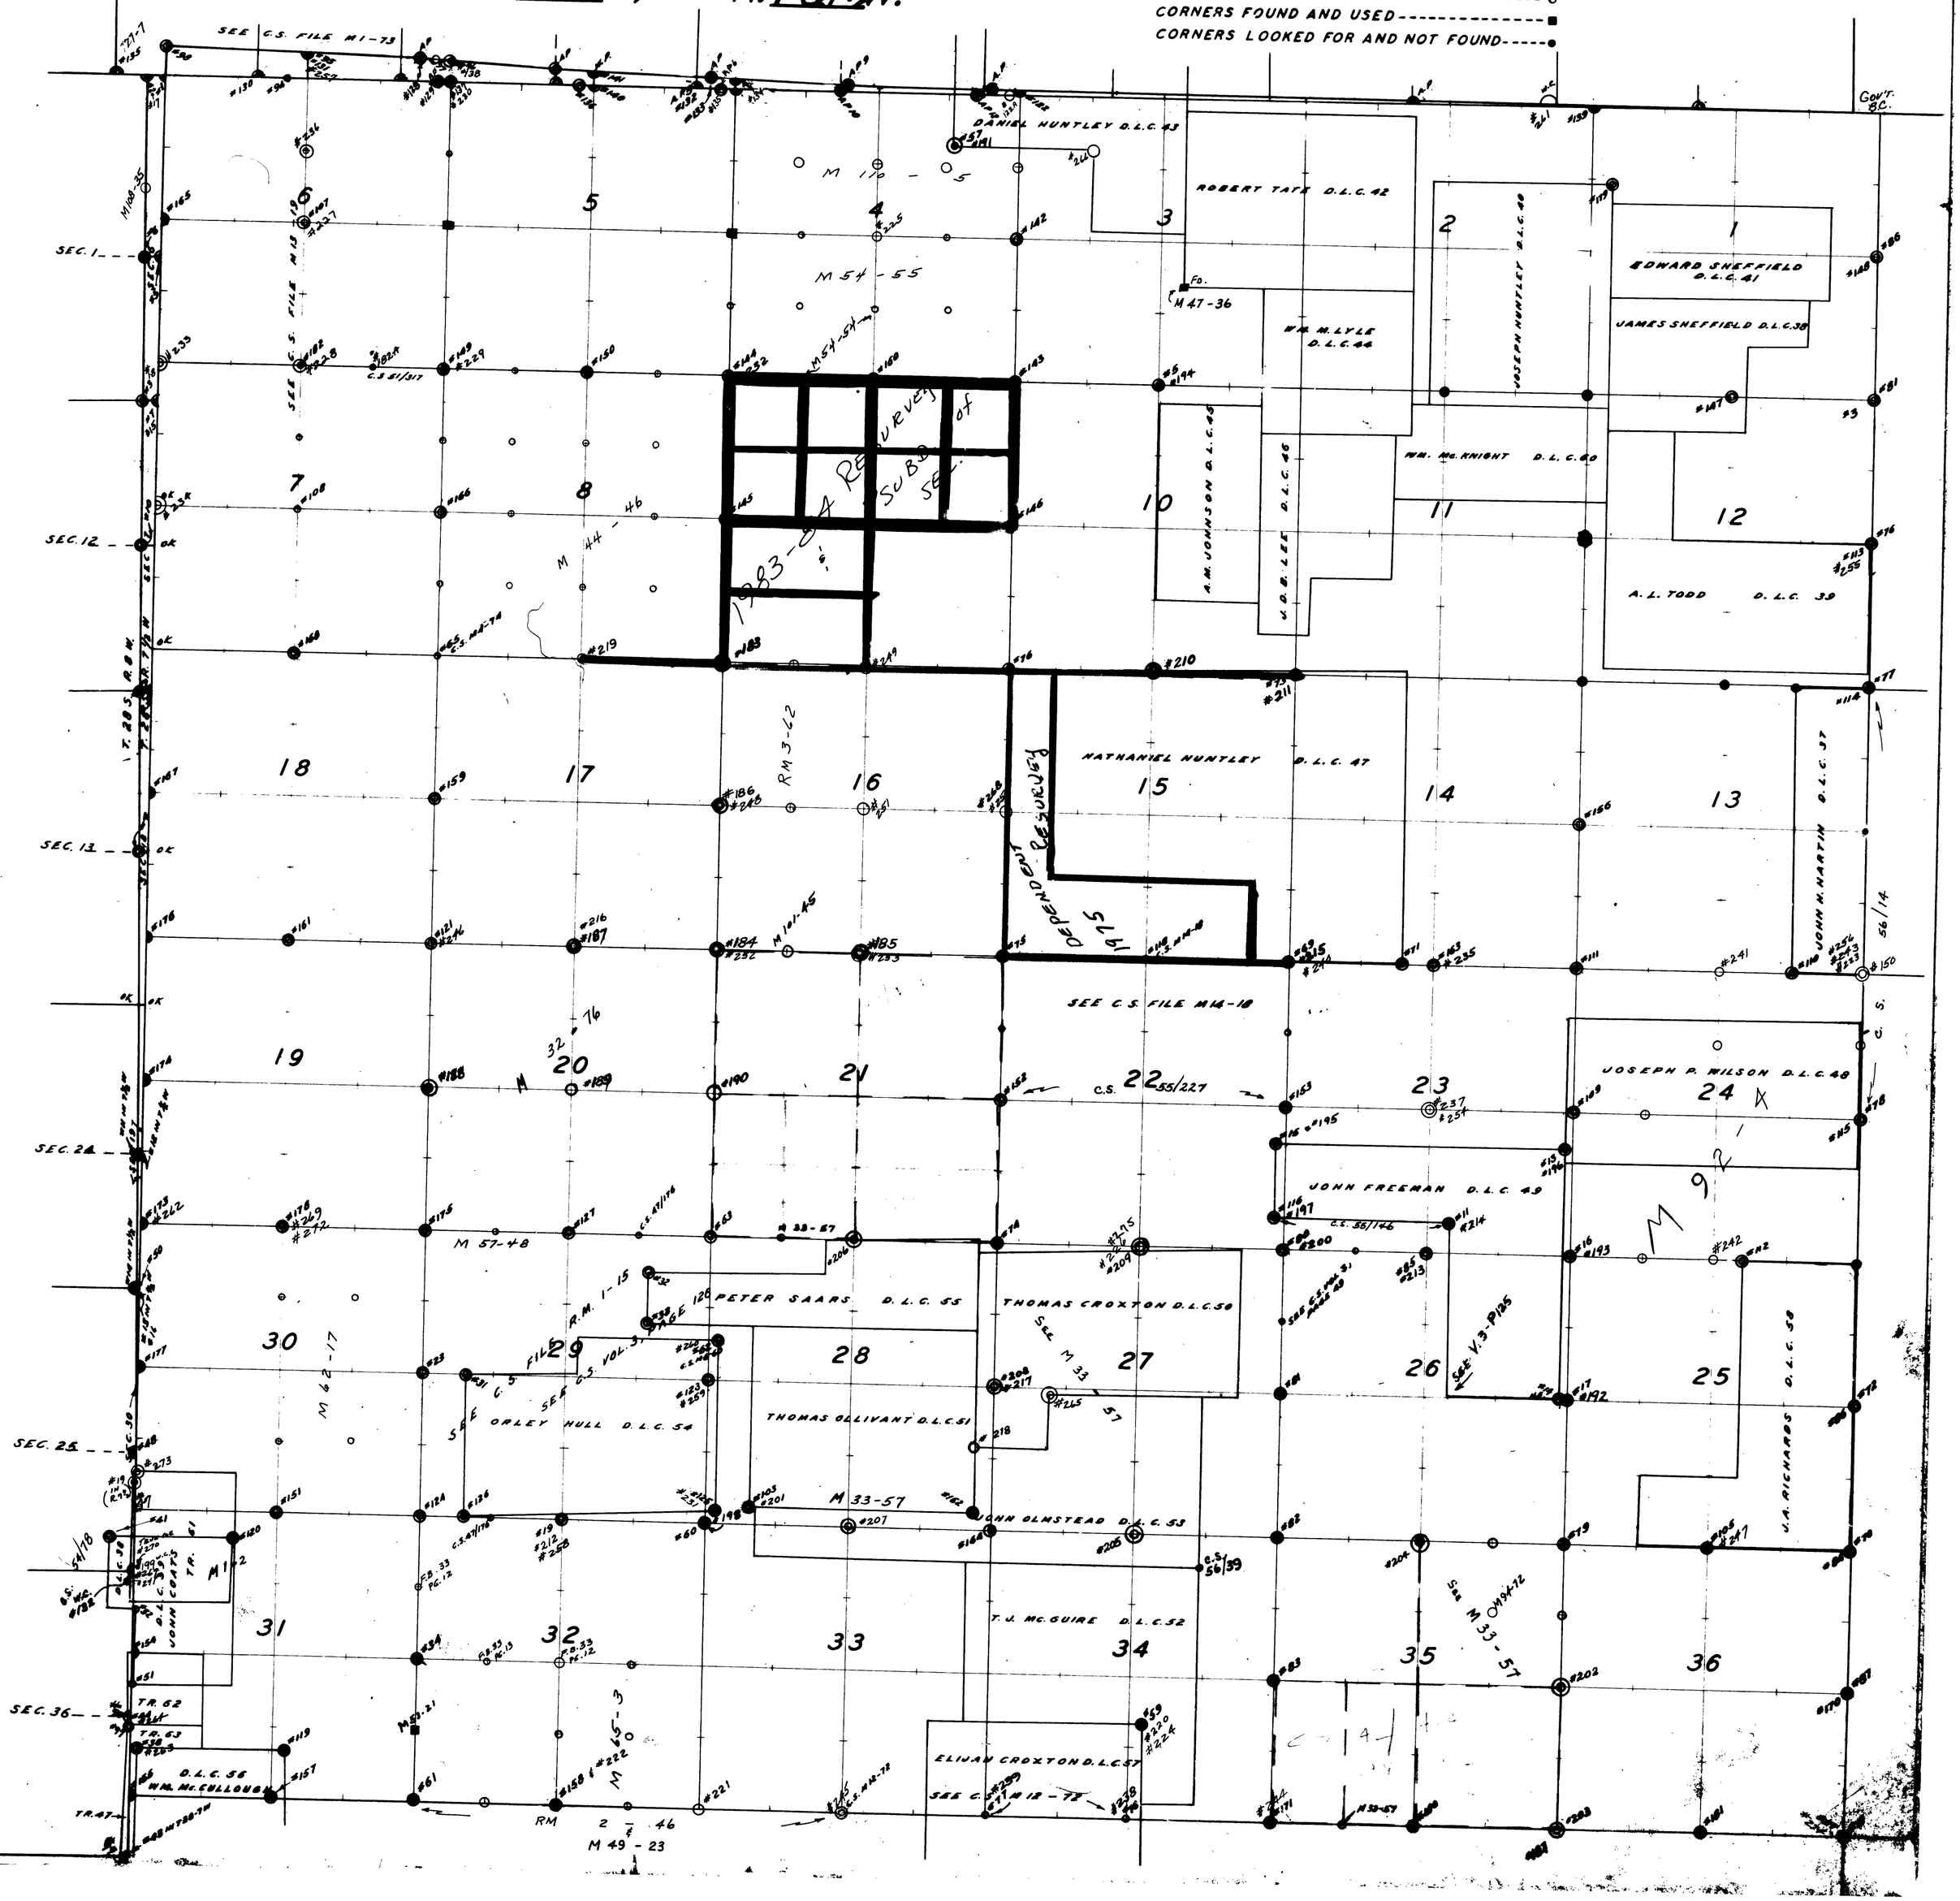
CORNERS RENEWED BY
BUREAU OF LAND MANAGEMENT ----------
COUNTY SURVEYOR'S OFFICE ----------
PRIVATE SURVEYORS ----------
CORNERS FOUND AND USED ----------
CORNERS LOOKED FOR AND NOT FOUND -----