Douglas County Surveyor's Record of Government Corners Renewed

28 T. S. 8 R. W. W. M.

KOKE-CHAPMAN CO., EUGENE, ORE. 97196

(CONTINUED)

New BT's: 6" R. Fir bears S.22°W. 54.6 ft. scribed S25 CS BT.
20" R.Fir bears N. 9°E. 46.0 ft. scribed S19 T28S R7½W CS BT.

- - - - - - - - - - - - - -

106

R8W R7W
Sec. Corner S36/S31 T27S
S1 T28S

Found - Both BT's. recorded by Eppstein. Each shows scribing but have been dozed out of position. We do not find Iron Bolt set for Corner. See C.S. 14/59 & M 1 - 73.
Corner is in old logging Road - Corner reset by Traverse from North Line of Range 7½R8W R7W
Set Brass Cap at Cor.Mkd: County Surveyor's Office, 1961 T27S S36/S31 T28S S1
New BT: 32" B.Oak bears N.26°W. 289.3 ft. scribed S36 T27S R8W CS BT.

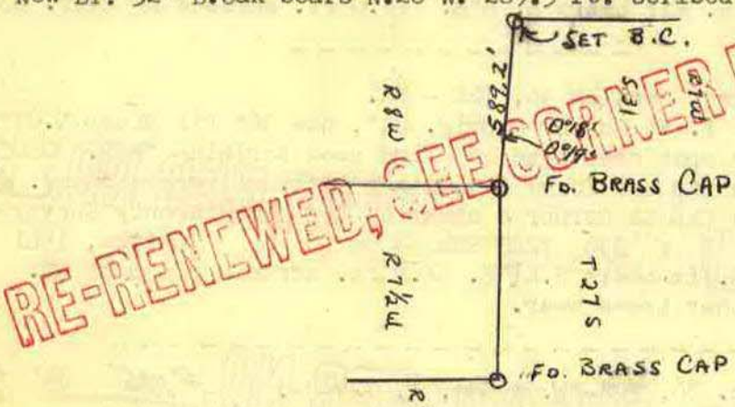

RE-RENEWED, SEE CORNER NO. #186

James W. Byron, Deputy
Milo Godfrey & Clete Putnam
May and June 1961
C. S. File No. 52/79

- - - - - - - - - - - - - -

107

Section Corner to Sections 3 - 4 - 9 - 10.
Found - Orig. 30", now 36" Fir Snag N.53°E. 44.9 ft., shows good bark scribing "T28S R8W S3 B"
Orig. 30", now down Fir, N.52°W. 33.0 ft., bark gone.
Orig. SW. BT. not found.
Orig. 30", now 40" Fir S.4½°E. 14.5 ft., shows good bark scribing "B".
Set Brass Cap at Corner Mkd: County Surveyor's Office, 1961 S 4 | S 3 / S 9 | S10 T28SR8W
New BT's: 28" Hemlock bears N.81½°W. 31.8 ft. scribed S4 T28S R8W CS BT.
10" Fir bears S.15½°E. 18.1 ft. scribed S10 T28S R8W CS BT.
12" Hemlock bears S.46°W. 62.1 ft. scribed S9T28S R8W CS BT.
12" Hemlock bears N.60°E. 63.4 ft. scribed S 3 T28S R8W CS BT.

- - - - - - - - - - - - -

NEXT

PAGE