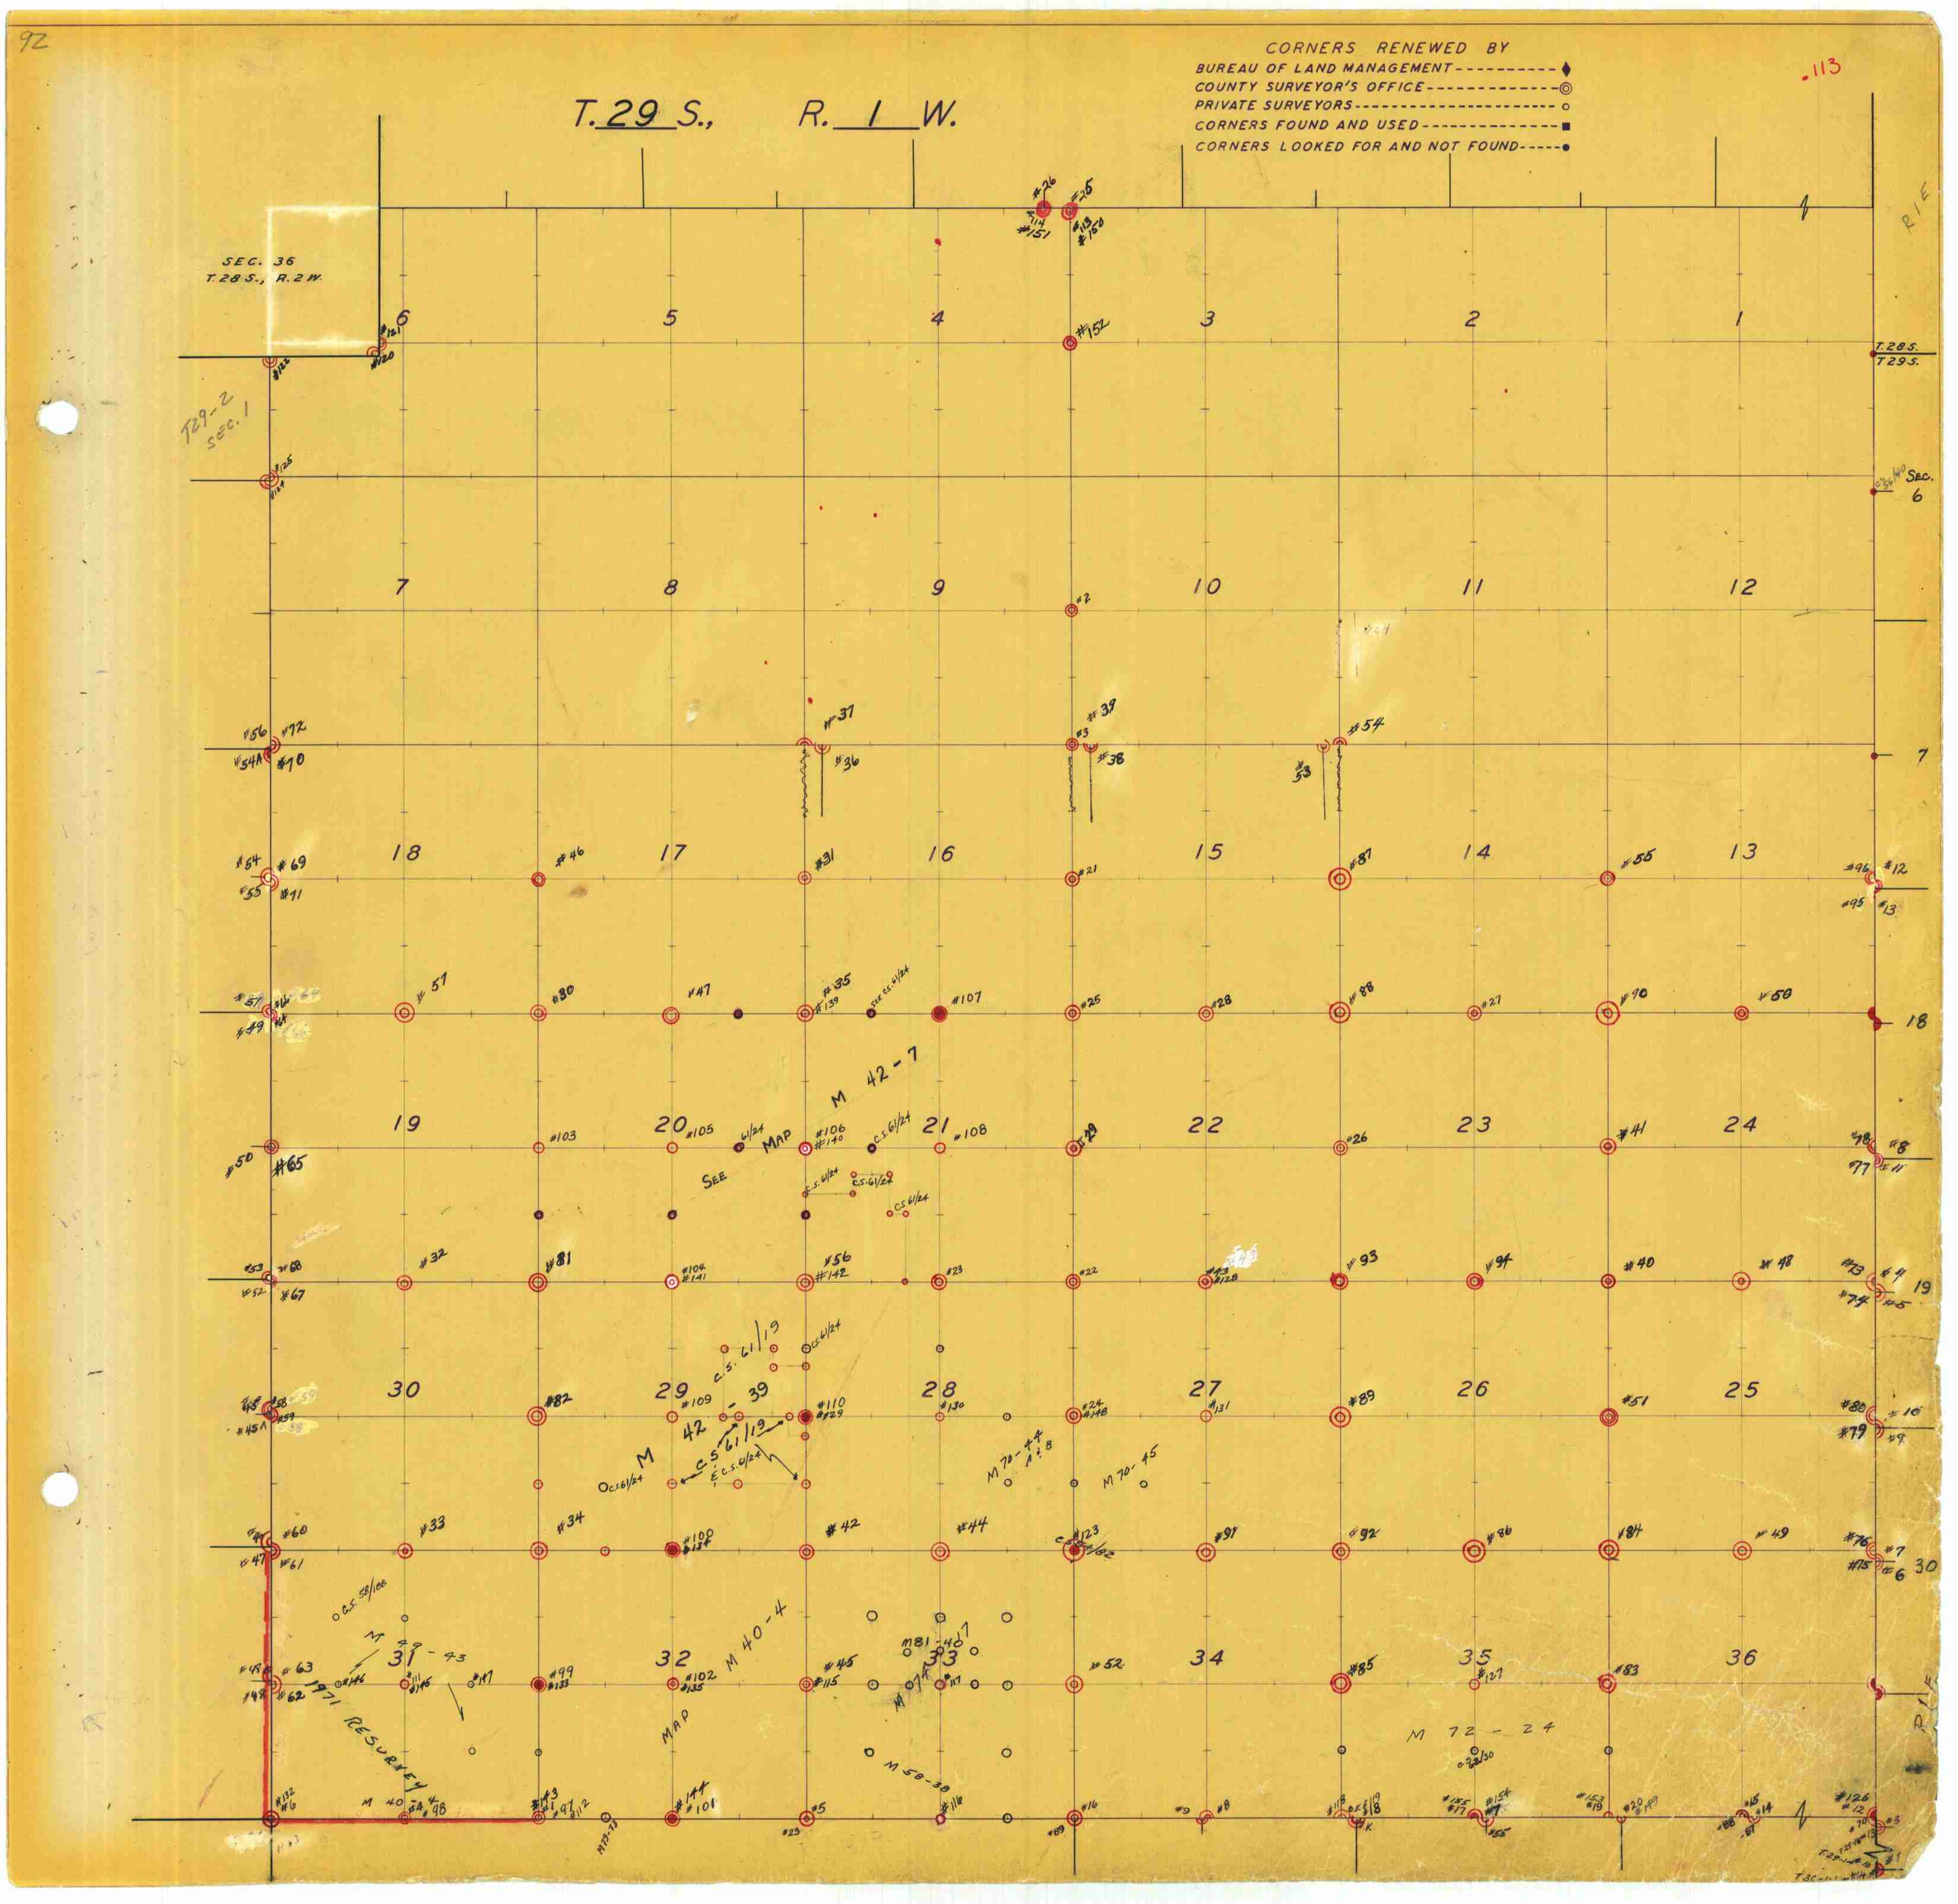
92
.113
T. 29 S., R. 1 W.
CORNERS RENEWED BY
BUREAU OF LAND MANAGEMENT
COUNTY SURVEYOR'S OFFICE
PRIVATE SURVEYORS
CORNERS FOUND AND USED
CORNERS LOOKED FOR AND NOT FOUND
SEC. 36
T. 28 S., R. 2 W.
T29-2
SEC. 1
T. 28 S.
T 29 S.
SEC. 6
M 42-7
SEE MAP
M 42-39
M 40-4
M 49-43
1971 RESURVEY
M 72-24
M 70-44
M 70-45
M 58-38
M 81-40
C.S. 61/19
C.S. 61/24
C.S. 58/100