


T. 29 S., R. 2 W.

CORNERS RENEWED BY  
 BUREAU OF LAND MANAGEMENT -----◆  
 COUNTY SURVEYOR'S OFFICE -----◎  
 PRIVATE SURVEYORS -----○  
 CORNERS FOUND AND USED -----■  
 CORNERS LOOKED FOR AND NOT FOUND -----●

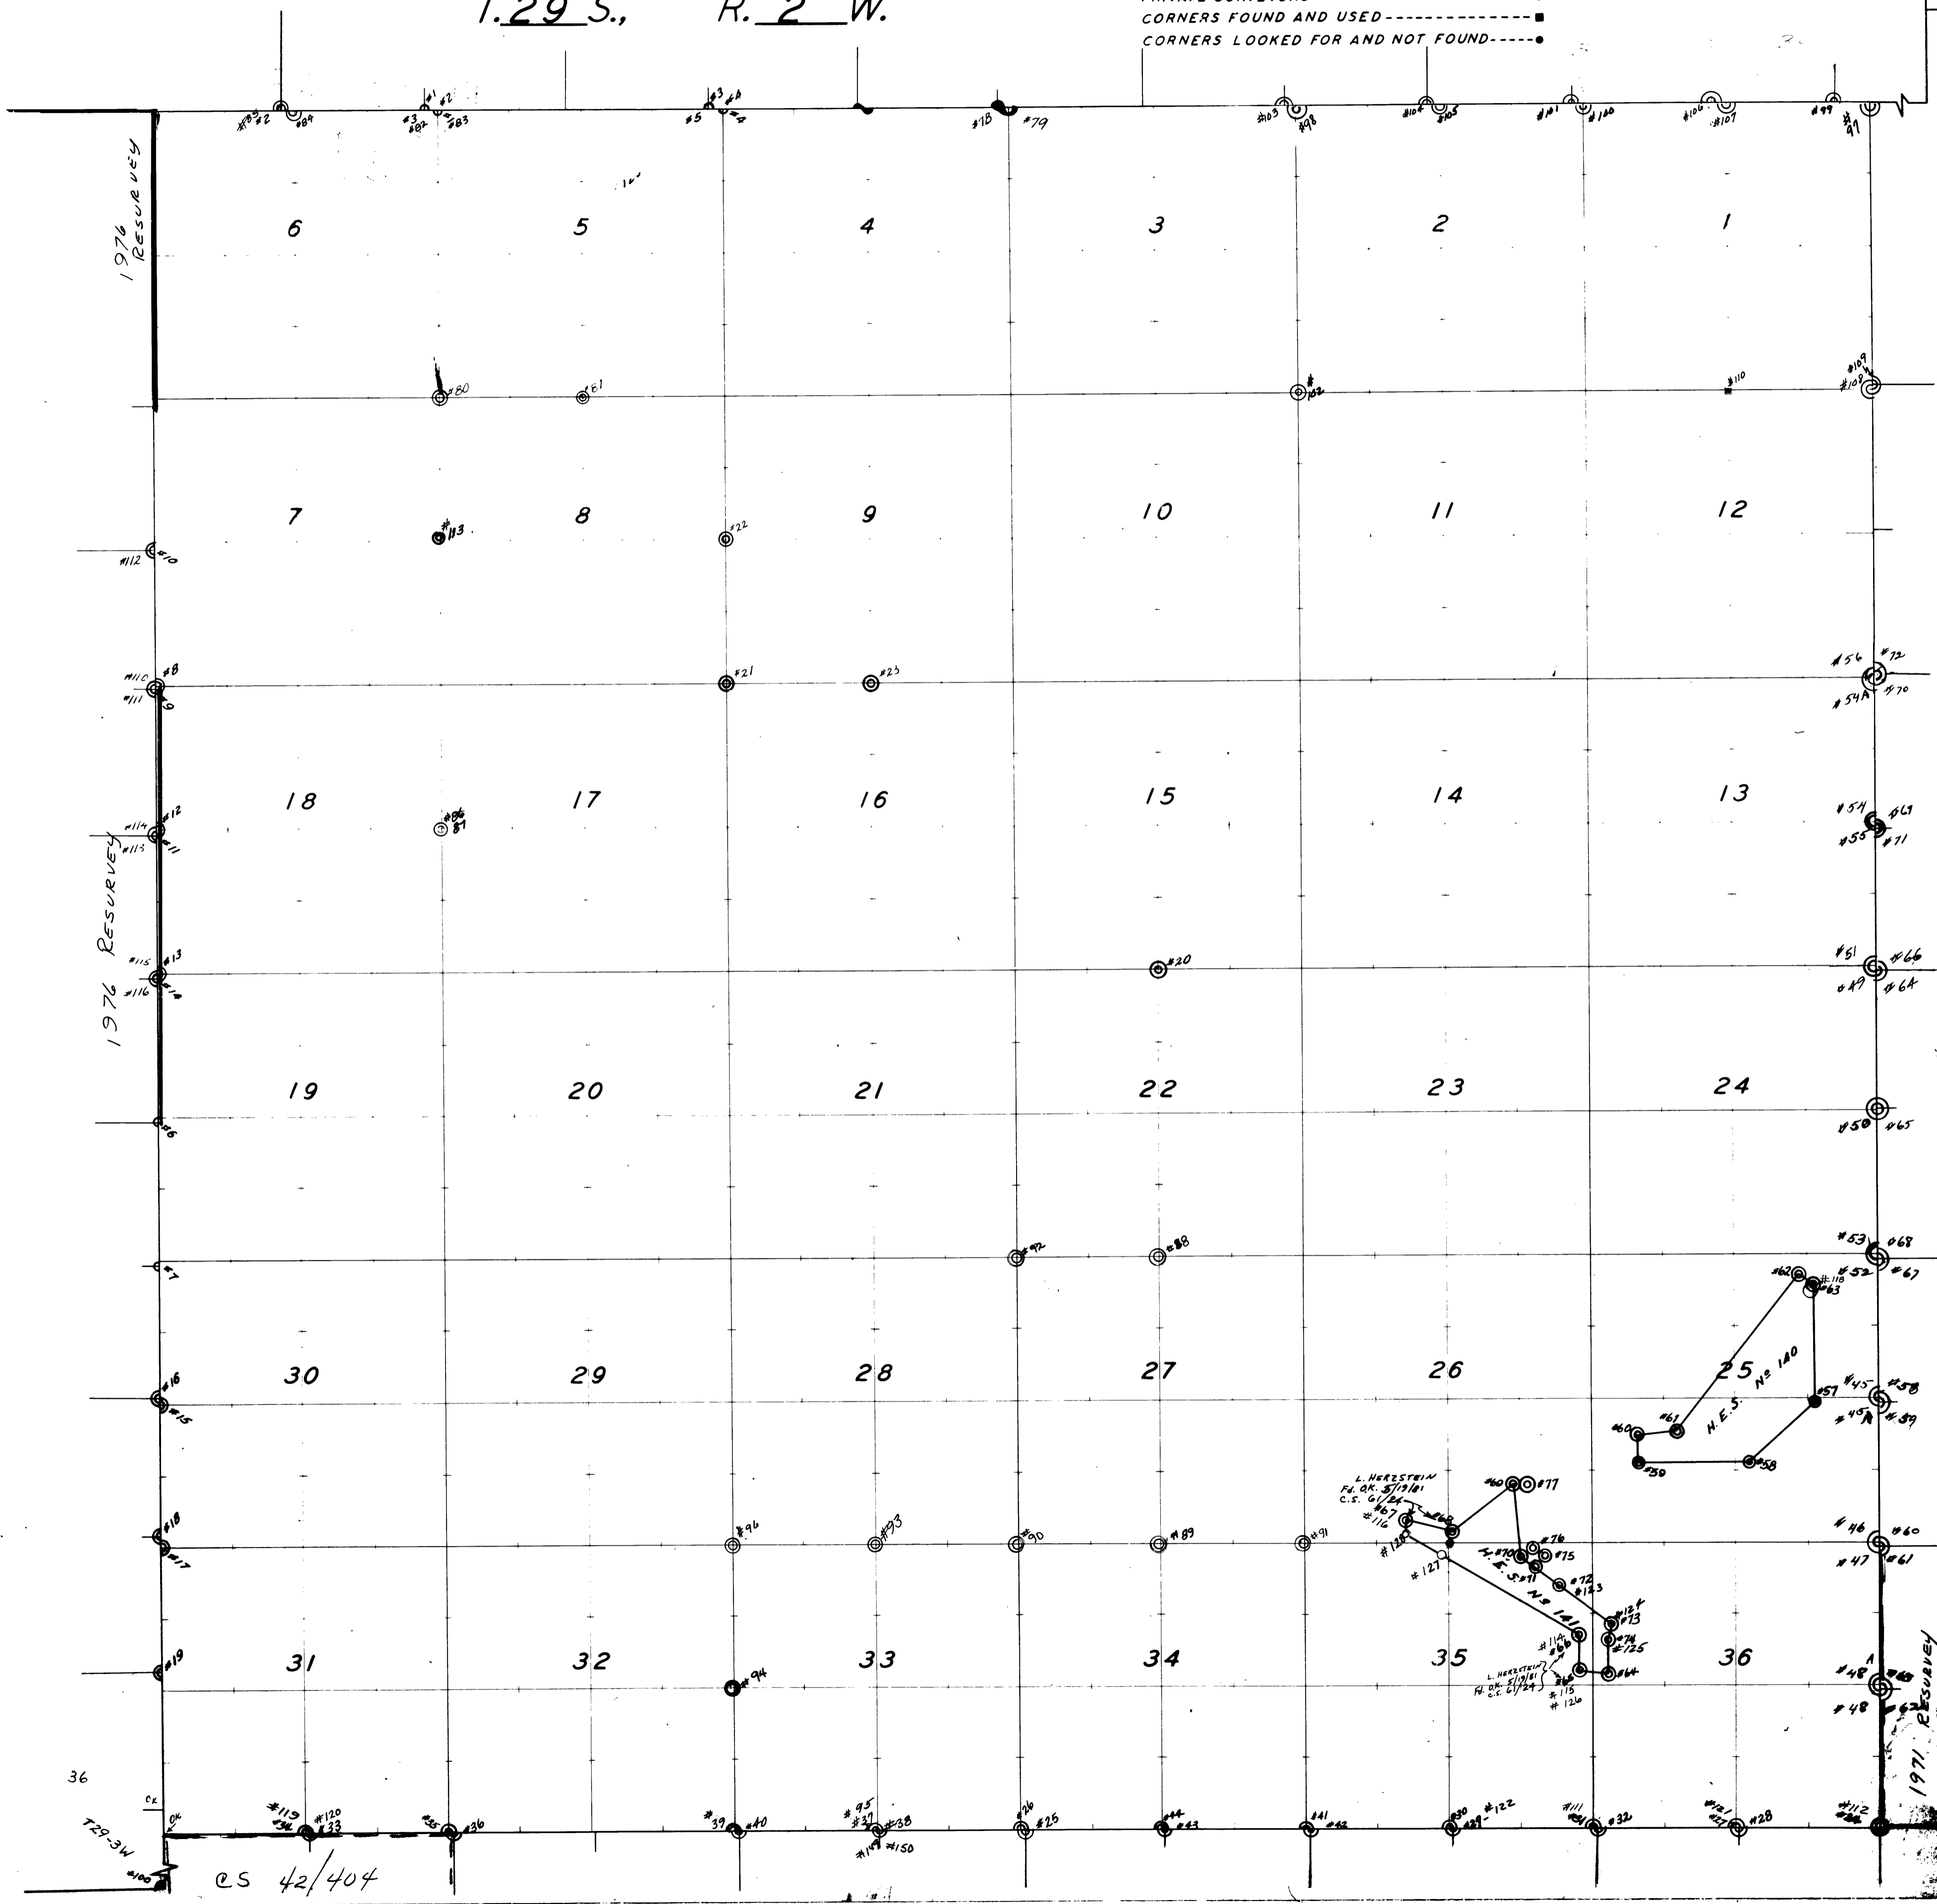

1976 RESURVEY

1976 RESURVEY


36

T29-3W

CS 42/404

L. HERZSTEIN  
 C.S. 61/24  
 #116  
 #117  
