


T. 29 S., R. 3 W.

CORNERS RENEWED BY  
 BUREAU OF LAND MANAGEMENT -----◆  
 COUNTY SURVEYOR'S OFFICE -----○  
 PRIVATE SURVEYORS -----○  
 CORNERS FOUND AND USED -----■  
 CORNERS LOOKED FOR AND NOT FOUND -----●

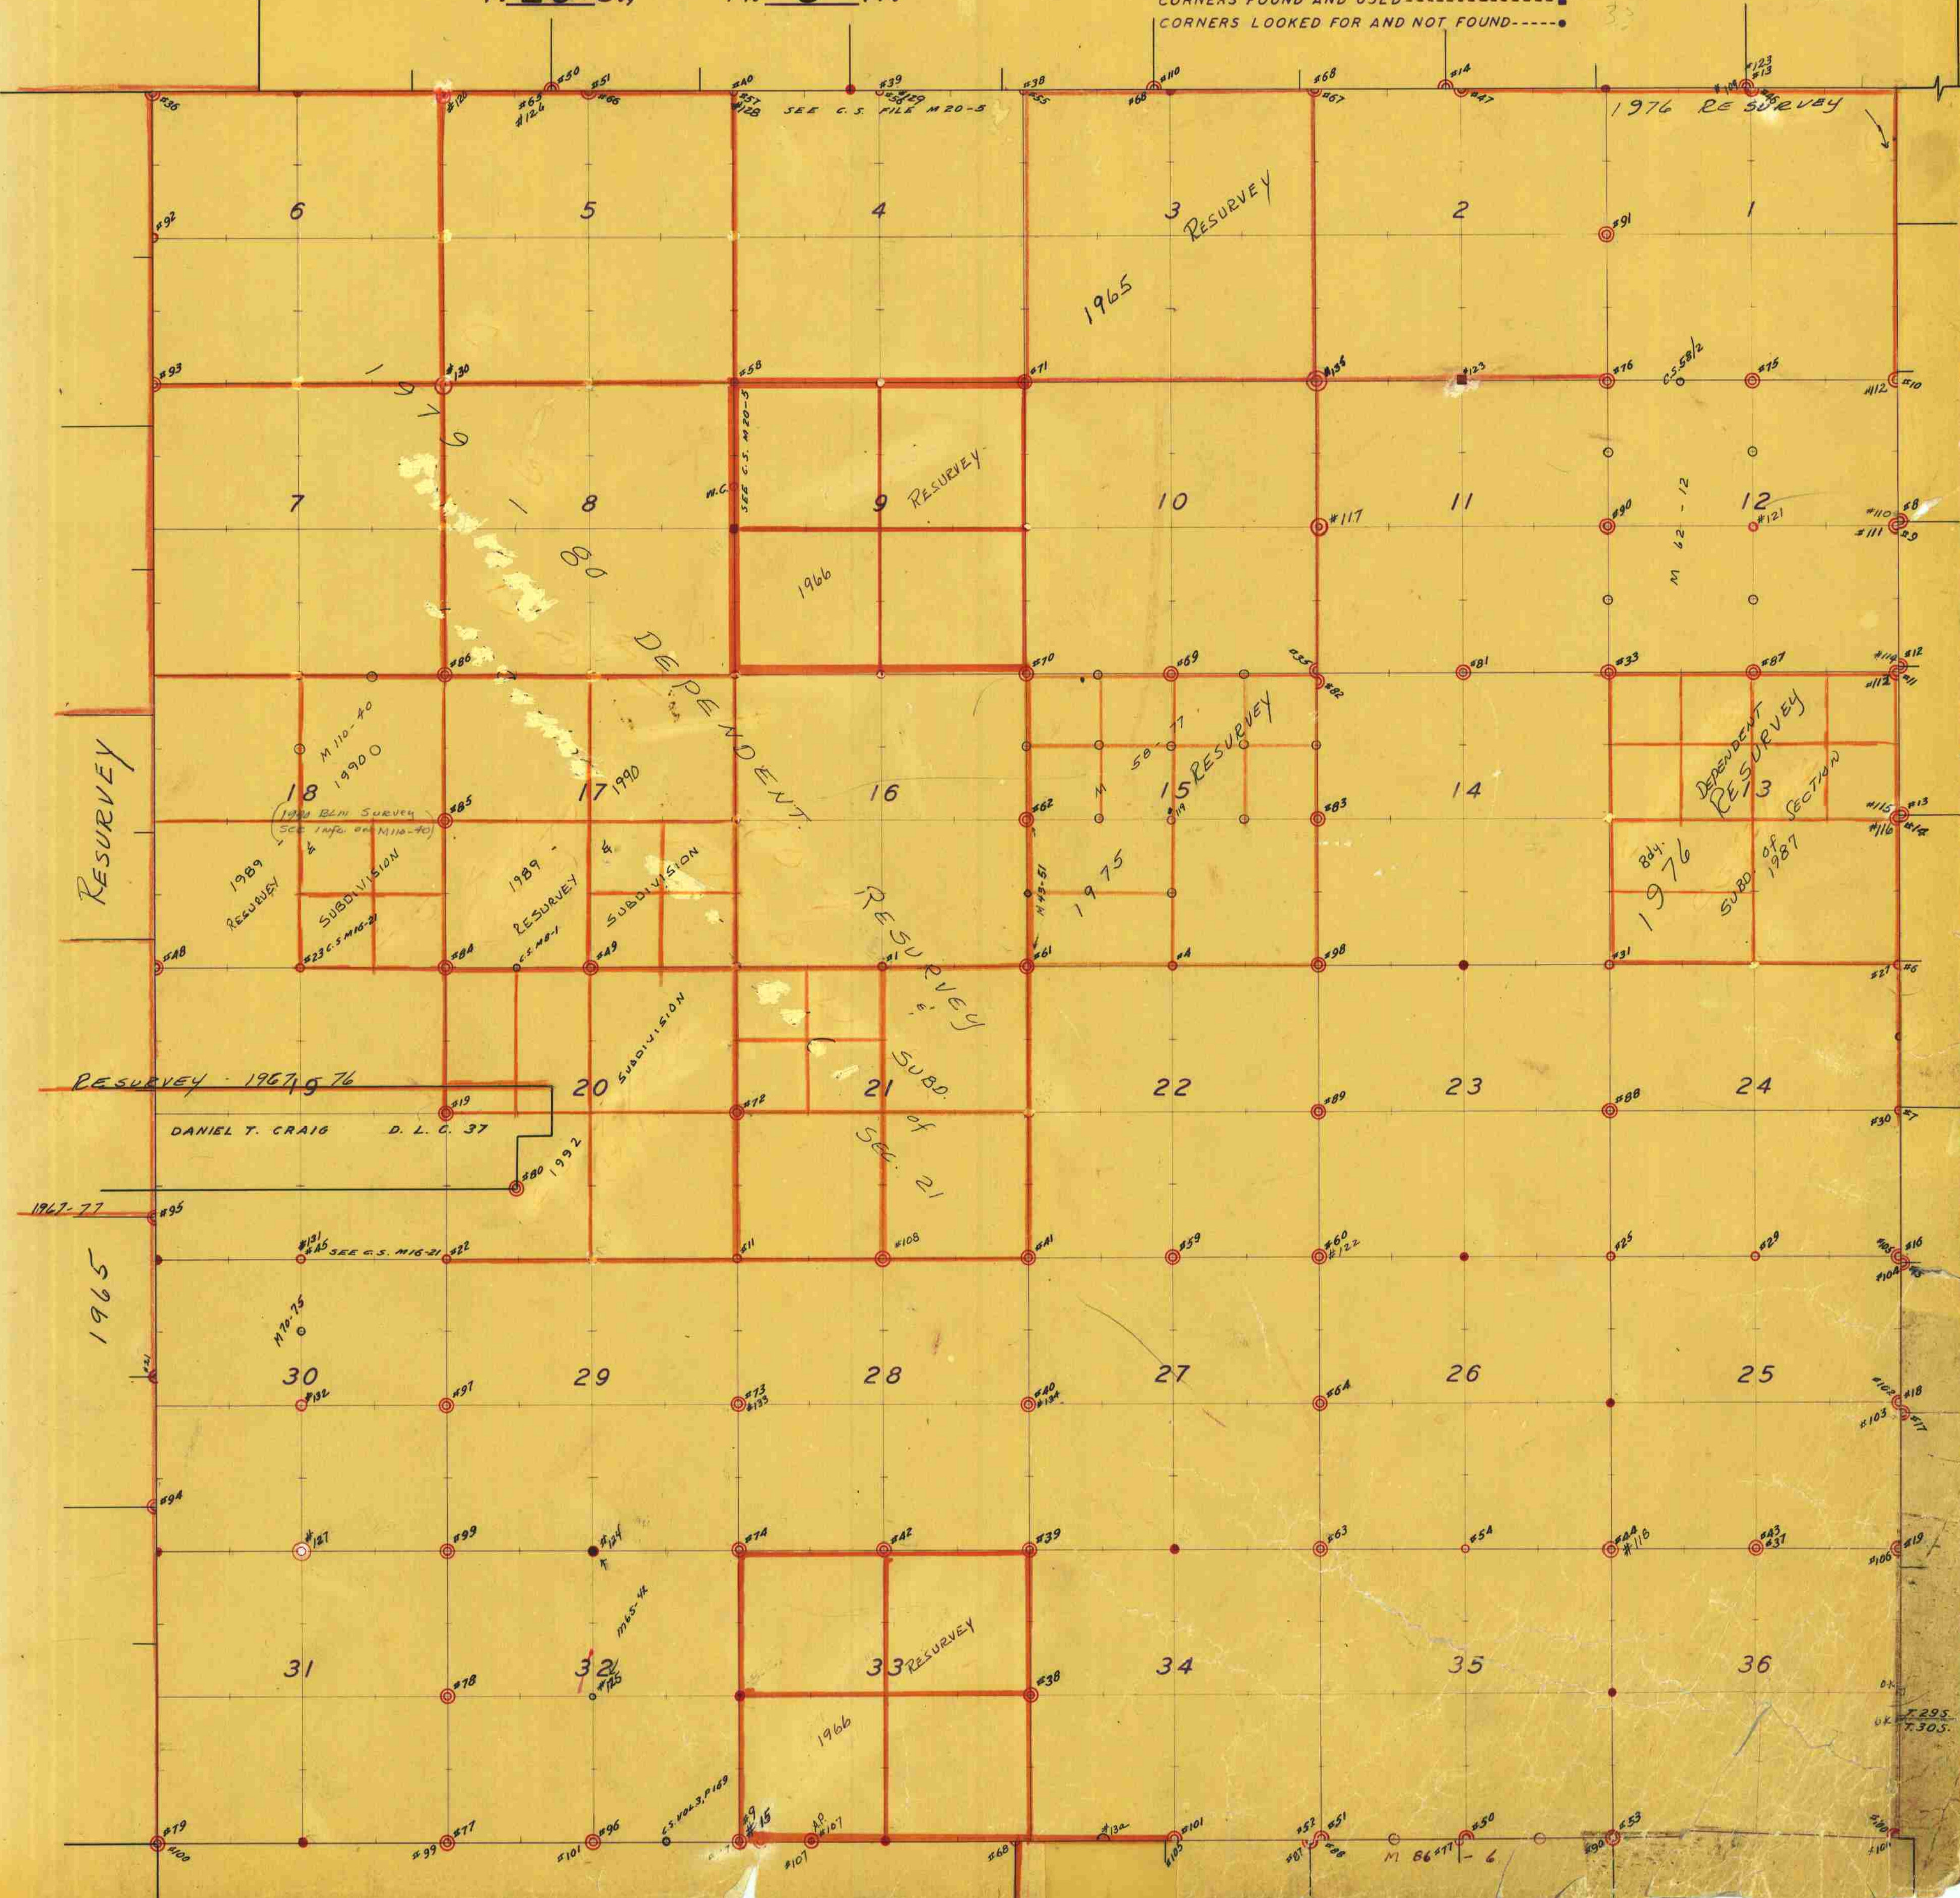

T. 29 S. R. 3 W. 7305.