T. 29 S., R. 4 W.
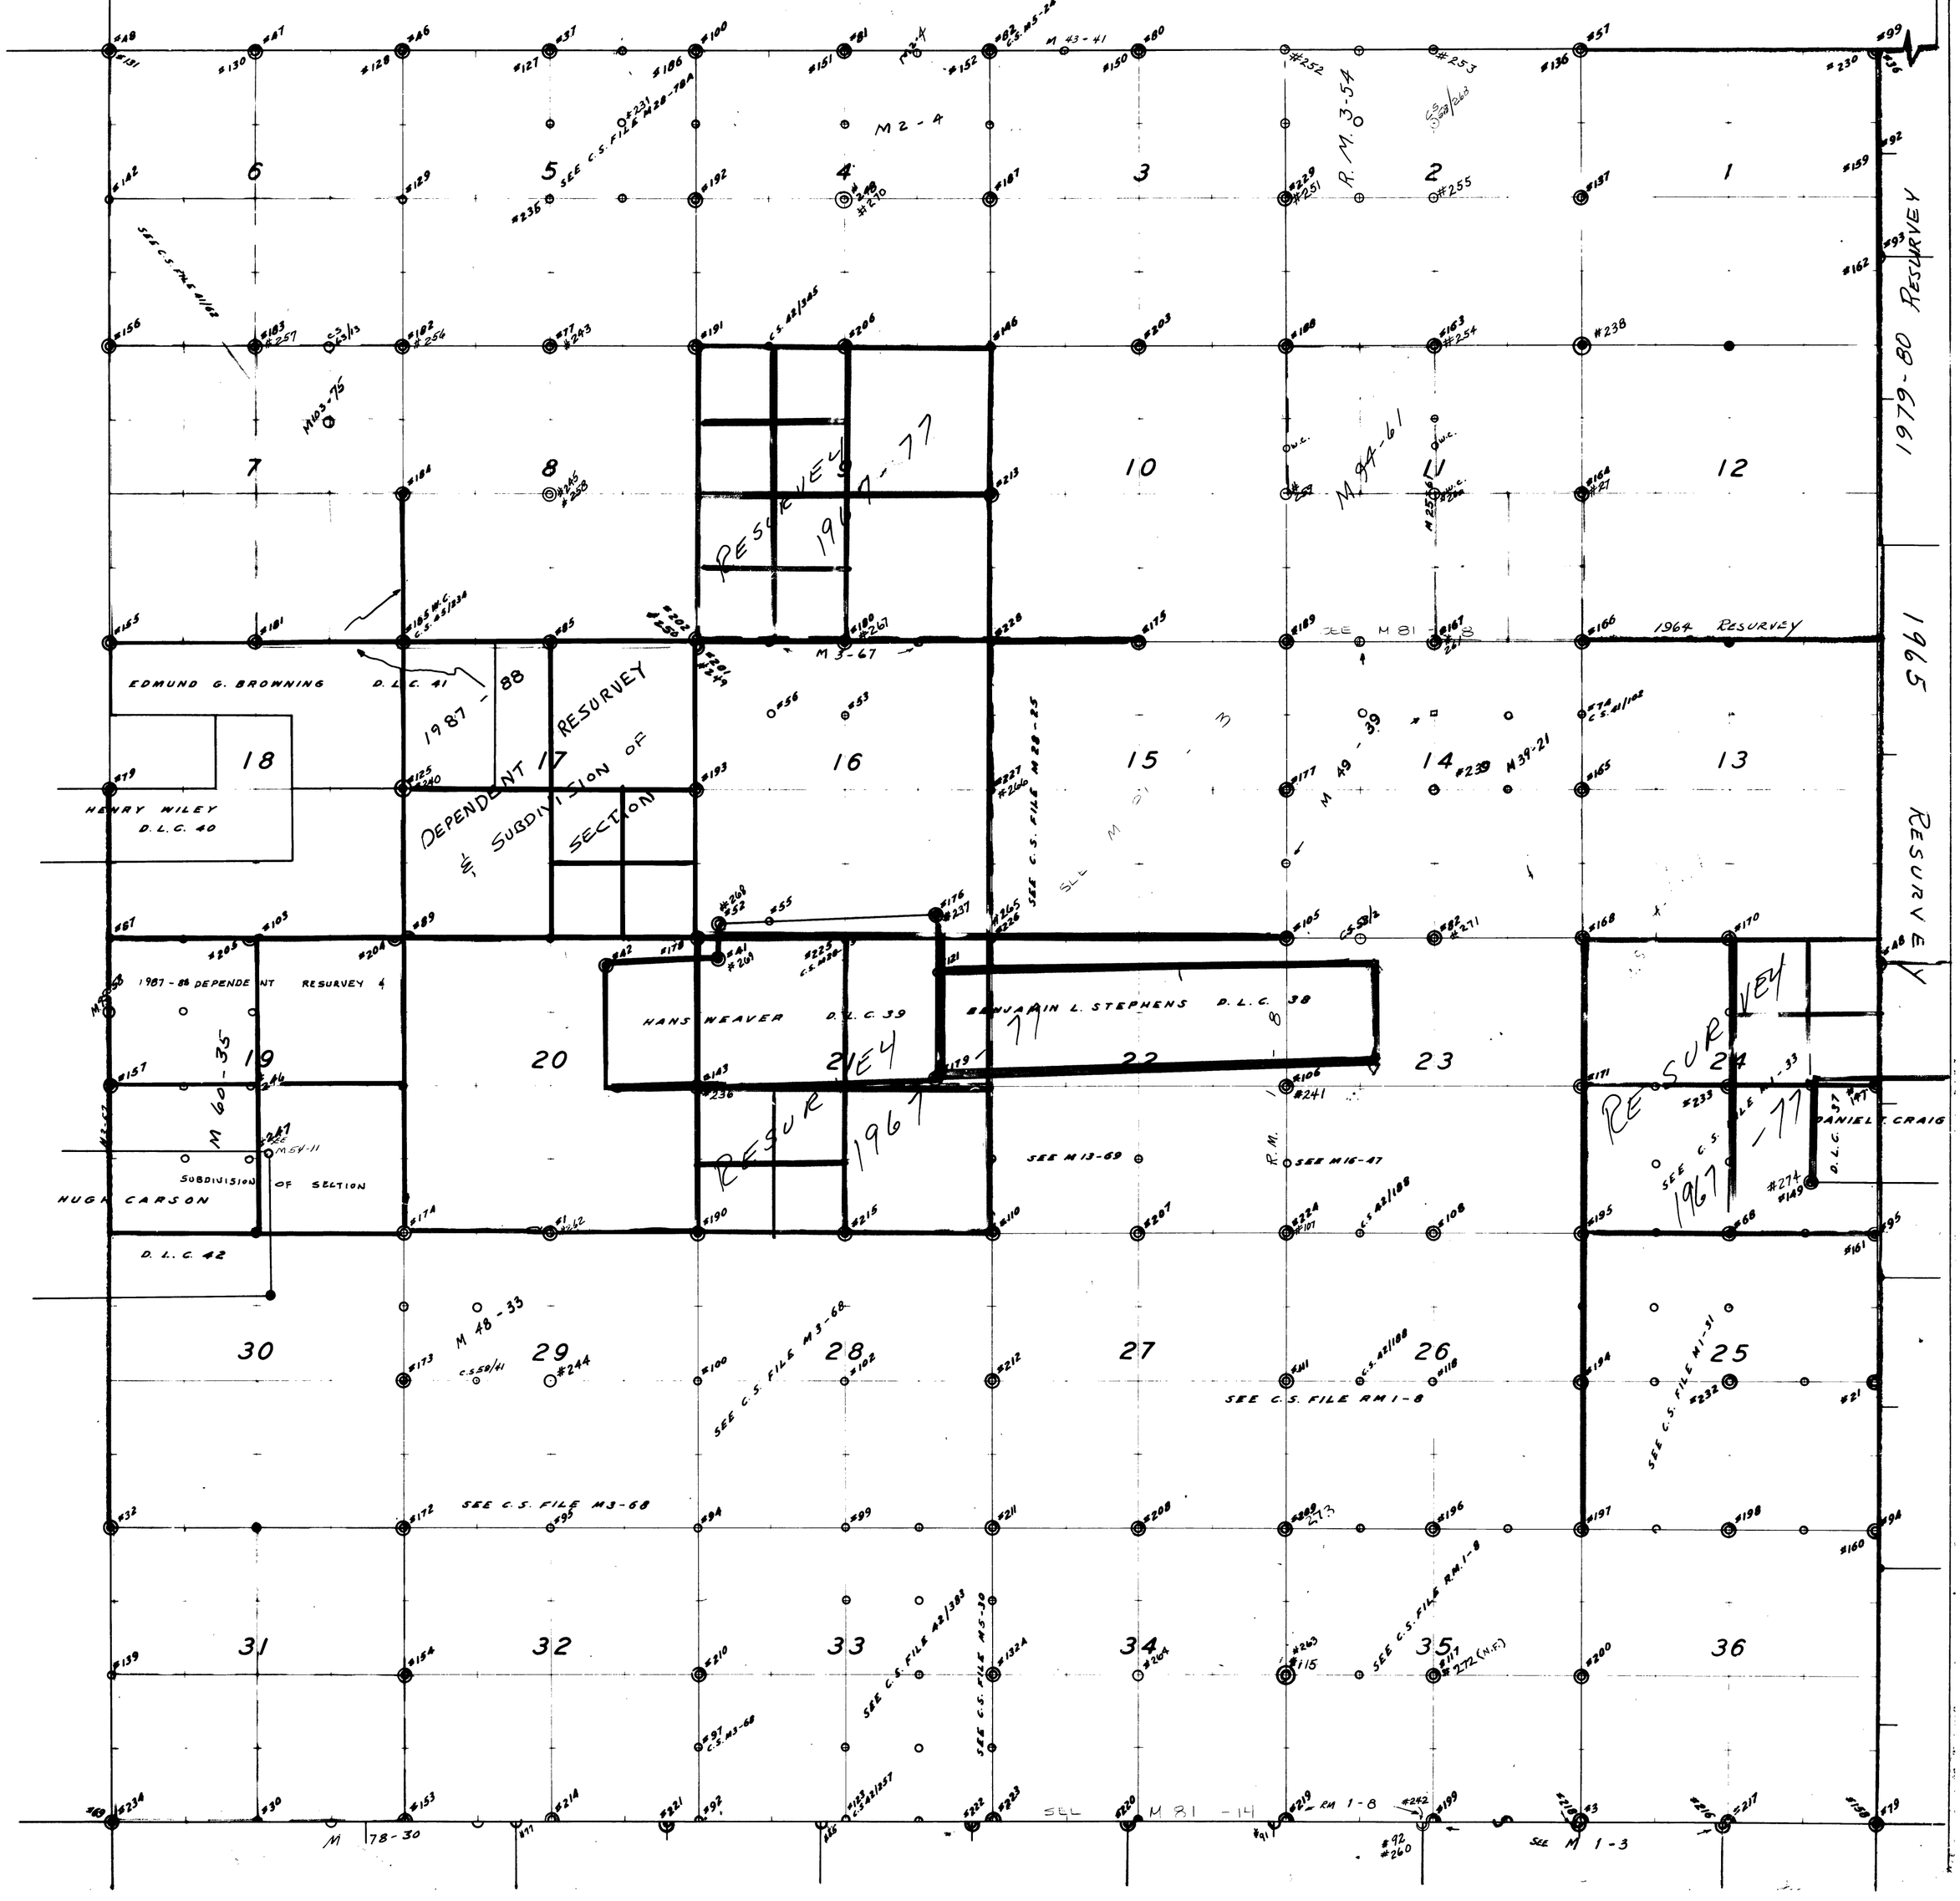
CORNERS RENEWED BY
BUREAU OF LAND MANAGEMENT ----------◆
COUNTY SURVEYOR'S OFFICE ----------◎
PRIVATE SURVEYORS ----------○
CORNERS FOUND AND USED ----------■
CORNERS LOOKED FOR AND NOT FOUND-----●