Douglas County Surveyor's Record of Government Corners Renewed

T. 29 S. T. S. R. 6 W. R. W. W. M.

KOKE-CHAPMAN CO., EUGENE, ORE. 21881

RE-RENEWED, SEE CORNER NO. #256

163

Renew Corner S36 | S31 T29S
S 1 | S 6 T30S
R7W R6W

Found - All BT's. as recorded by Markham, 1956. - See Cor. #120
Do not find Bolt set at Corner.

Set - Brass Cap at Corner Mkd: County Surveyor's Office, 1962 S36 | S31 T29S
S 1 | S 6 T30S
R7W R6W.

Note - We find Stone N.20°W. 1.5 ft. from corner that may have been set for corner.

- - - - - - - - - - - - -

164

Closing Corner to Sections 24 & 25, T29-7W, West boundary, T29-6W.

Found - Corner Stone with "C" chisled on face. We find Corner Stone at Base of fence corner post & out of ground. We do not find N.W. BT. This area in yard. We check record bearing S.2°W. (See B.B.I. survey) & record dist. to Sec. Cor. S19 / S30

Set - Brass Cap at Fence Cor. Mkd: C C S24 | T29S County Surveyor's Office, 1962
R7W S25 | R6W

Fence Thus:

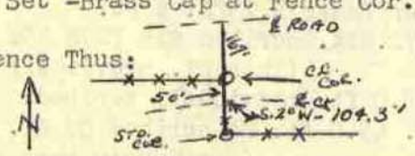

New BT: 9" Maple bears S.64°W. 22.6 ft. scribed CC S25 CS BT.

- - - - - - - - - - - - -

165

Corner to Sections 19 and 30 only. FD OK PER JOHNSTONE M101-73 12/89

Found - Yewood Anchor Post, (see B.B.I. survey) & see renewal above. We do not find Original BT's.

Set - Brass Cap along West edge of Anchor Post & Mkd: County Surveyor's Office, 1962 S19 T29S
R7W | S30 R6W

New BT's: 10" R.Fir bears S.88½°E. 101.5 ft. scribed S30 T29S R6W CS BT.
5" Maple bears N.15°E. 41.3 ft. scribed S19 CS BT.

- - - - - - - - - - - - -

166

¼ Cor. to Sections 29 and 32.

Found - All BT's as recorded by Markham, 1956, but do not find Axle set for corner. - See Cor. No. 116

Set - Brass Cap at Corner Mkd: County Surveyor's Office, 1962 ¼ S29 T29S R6W
S32

No New Bearing Trees.

FD OK 3/87 B. HALT M104-3

- - - - - - - - - - - - -

167

¼ Corner to Sections 5 and 8.

Found - Both BT's. as recorded by Boyer, 1941. The N.E. BT. is now down, shows good bark faces but I do not find scribing. The S.E. BT. now stump, shows faint scribe mark on bark. This area has been logged & burned. Corner is at fence corner. We do not find I.P. Set for corner by Boyer. - See Cor. #70

Set - Brass Cap at Corner Mkd: County Surveyor's Office, 1962 ¼ S 5 T29S R6W
S 8

New BT: 7" Laurel bears N.46½°W. 16.5 ft. scribed ¼ S5 CS BT.
No trees near to South.

- - - - - - - - - - - - -

168

Section Corner to Sections 15 - 16 - 21 - 22.

Found - Axle at corner, All BT's. as recorded by B.B.I., 1929, except all bearing to BT's, as below: See Cor. No. 44
Now 18" Fir bears S.27°E, not S.37½°E.
Now 18" Fir bears S.19½°W., not S.10°E.
Now 26" Fir Stump N.10½°W., not N.37½°W..
Stump shows good bark scribing "BT"
Now 12" W.O. bears N.69°E., not N.55°E.
All distances are O.K. as recorded.

New BT: 6" W.Oak bears N. 3½°W. 11.0 ft. scribed S16 CS BT.

- - - - - - - - - - - - -

Section Corner to Sections 20 - 21 - 28 - 29.

Found - Pipe

James W. Byron, Deputy County Surveyor
Dale McFarland and John Powell
March and April 1962 C. S. File No. 49/139