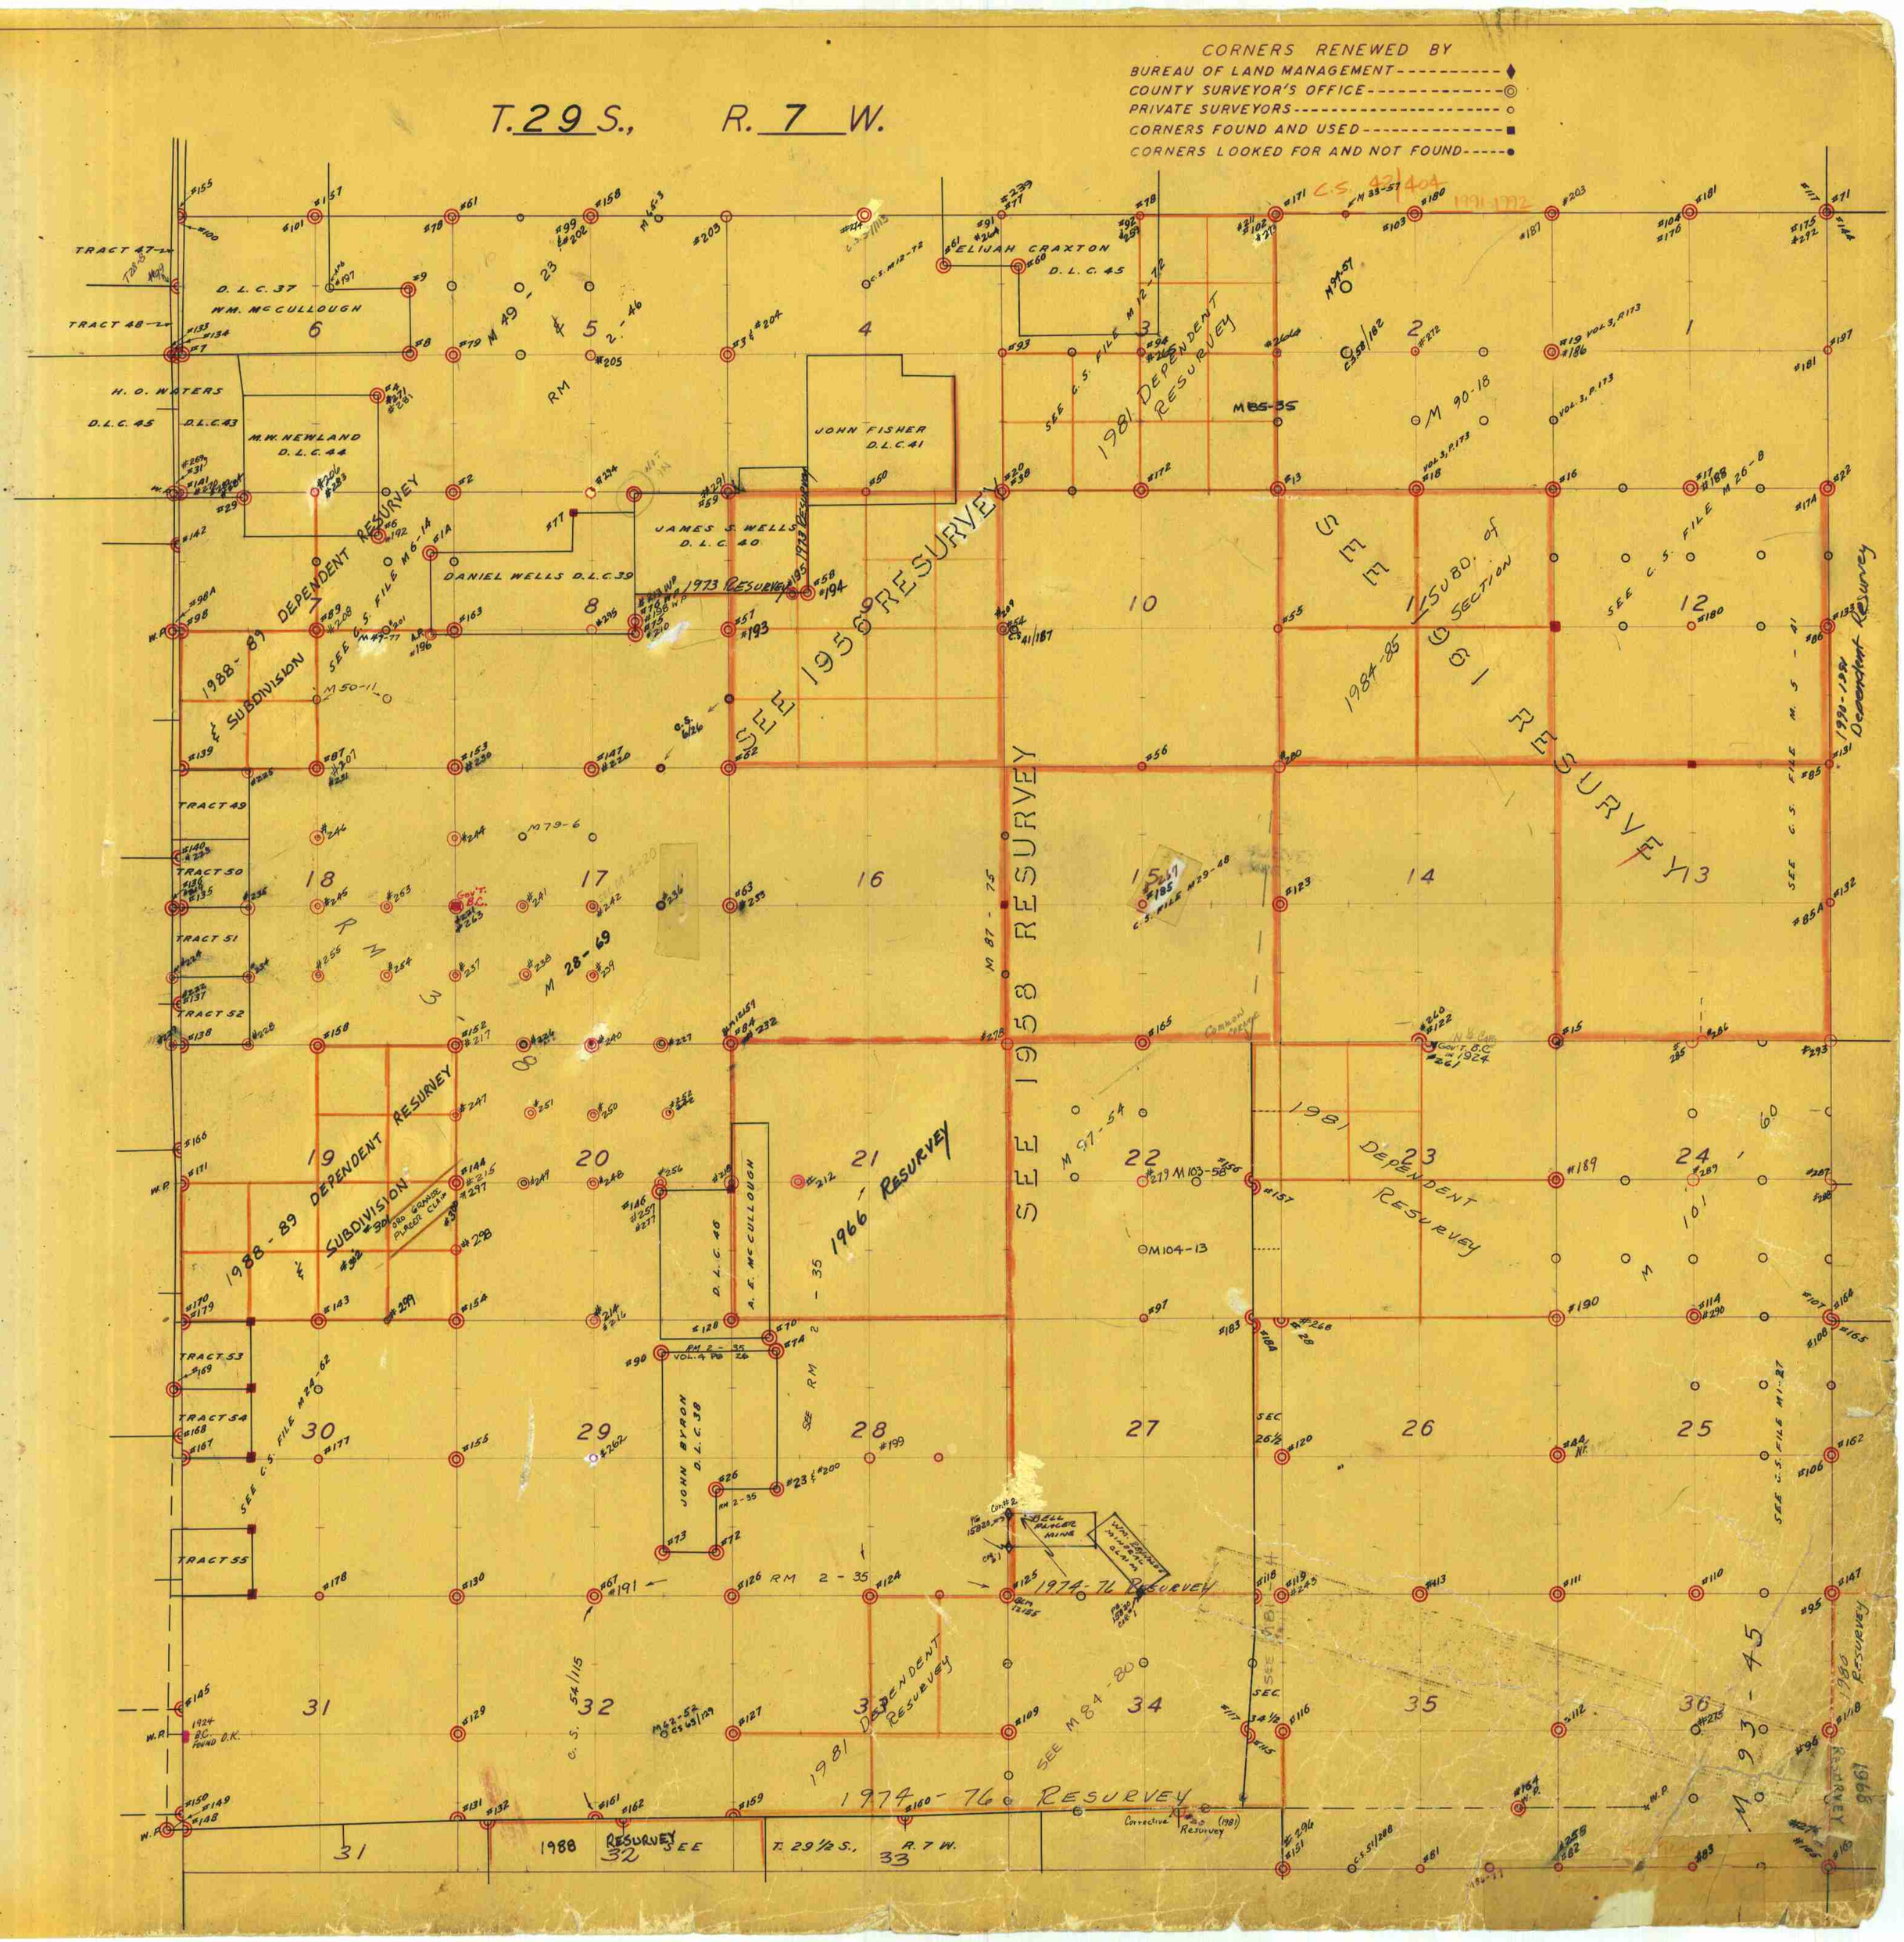
T. 29 S., R. 7 W.
CORNERS RENEWED BY
BUREAU OF LAND MANAGEMENT
COUNTY SURVEYOR'S OFFICE
PRIVATE SURVEYORS
CORNERS FOUND AND USED
CORNERS LOOKED FOR AND NOT FOUND
ELIJAH CRAXTON D.L.C. 45
WM. McCULLOUGH D.L.C. 37
H. O. WATERS D.L.C. 45
M.W. NEWLAND D.L.C. 44
JOHN FISHER D.L.C. 41
JAMES S. WELLS D.L.C. 40
DANIEL WELLS D.L.C. 39
A. E. McCULLOUGH D.L.C. 46
JOHN BYRON D.L.C. 38
1981 DEPENDENT RESURVEY
1988-89 DEPENDENT RESURVEY
1988-89 SUBDIVISION
1956 RESURVEY
1973 RESURVEY
1966 RESURVEY
1974-76 RESURVEY
1984-85 SUBD. OF SECTION
1990-1991 DEPENDENT RESURVEY
1980 RESURVEY
1988 RESURVEY
T. 29 1/2 S., R. 7 W.