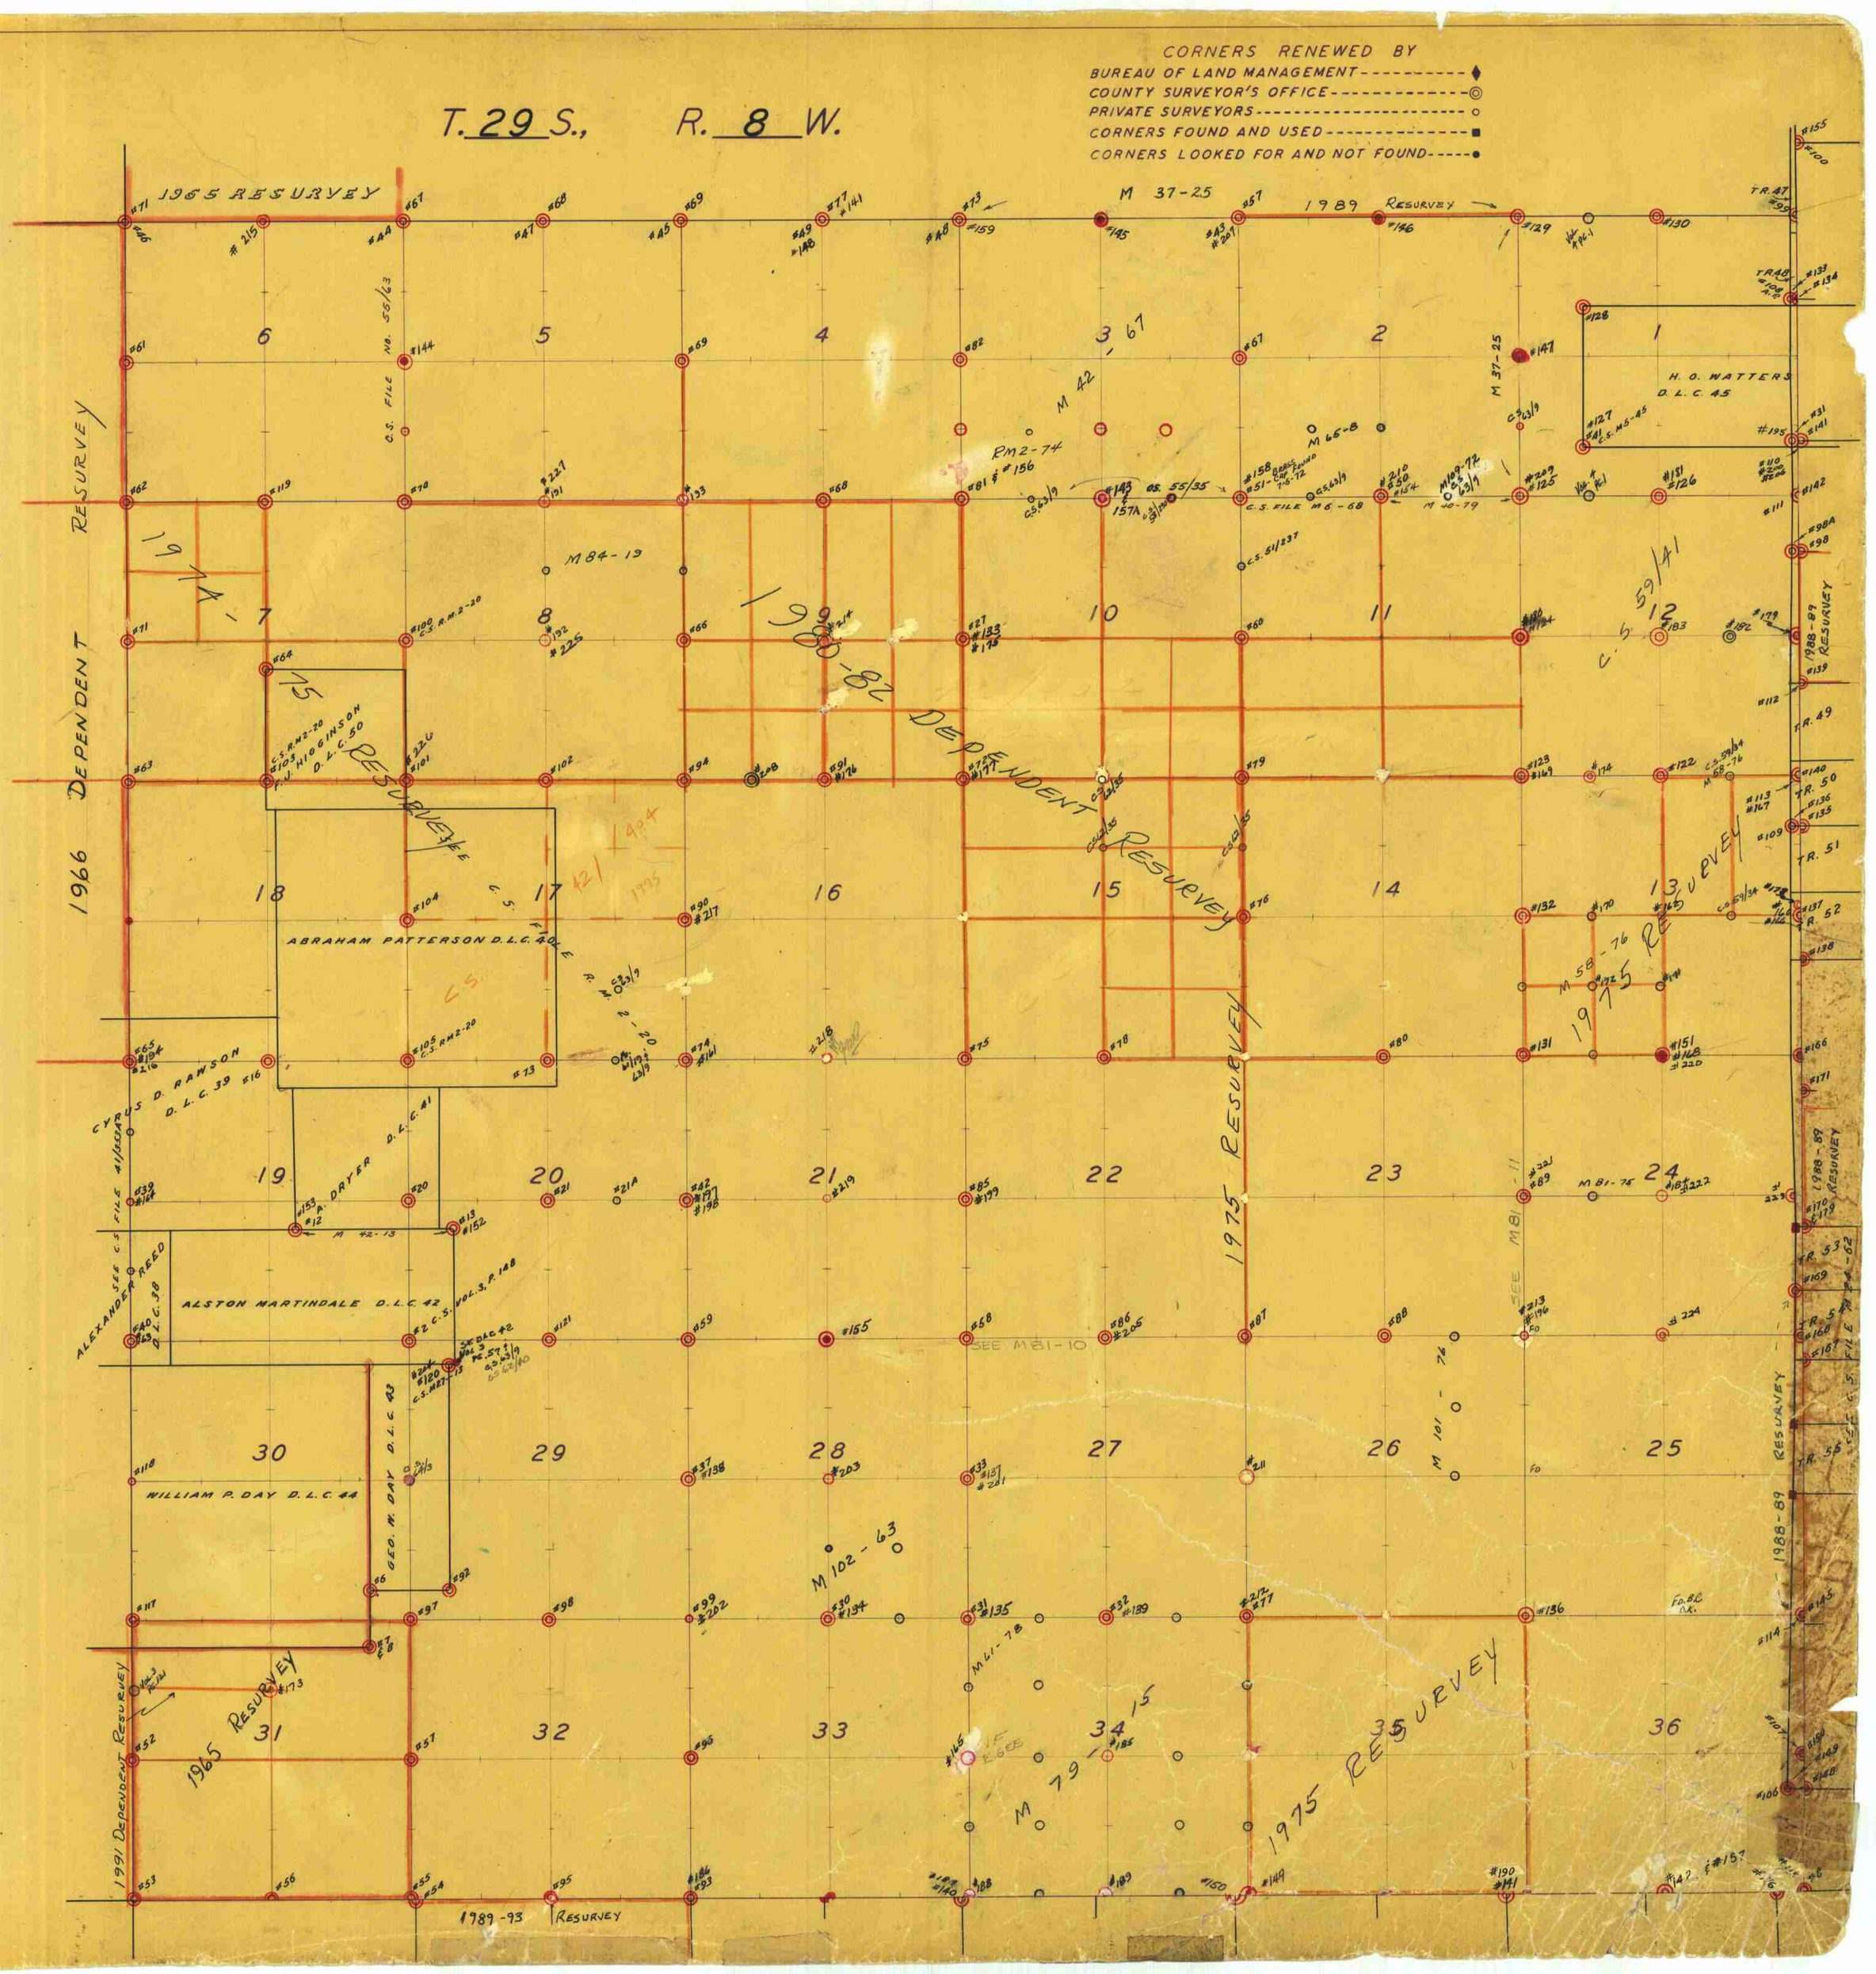
T. 29 S., R. 8 W.
CORNERS RENEWED BY
BUREAU OF LAND MANAGEMENT
COUNTY SURVEYOR'S OFFICE
PRIVATE SURVEYORS
CORNERS FOUND AND USED
CORNERS LOOKED FOR AND NOT FOUND
1965 RESURVEY
1989 RESURVEY
H. O. WATTERS D.L.C. 45
1966 DEPENDENT RESURVEY
1988-89 DEPENDENT RESURVEY
1988-89 RESURVEY
1975 RESURVEY
ABRAHAM PATTERSON D.L.C. 40
CYRUS D. RAWSON D.L.C. 39
A. DRYER D.L.C. 41
ALEXANDER REED D.L.C. 38
ALSTON MARTINDALE D.L.C. 42
WILLIAM P. DAY D.L.C. 44
GEO. N. DAY D.L.C. 43
1991 DEPENDENT RESURVEY
1965 RESURVEY
1989-93 RESURVEY