T. 29 S., R. 8 W.
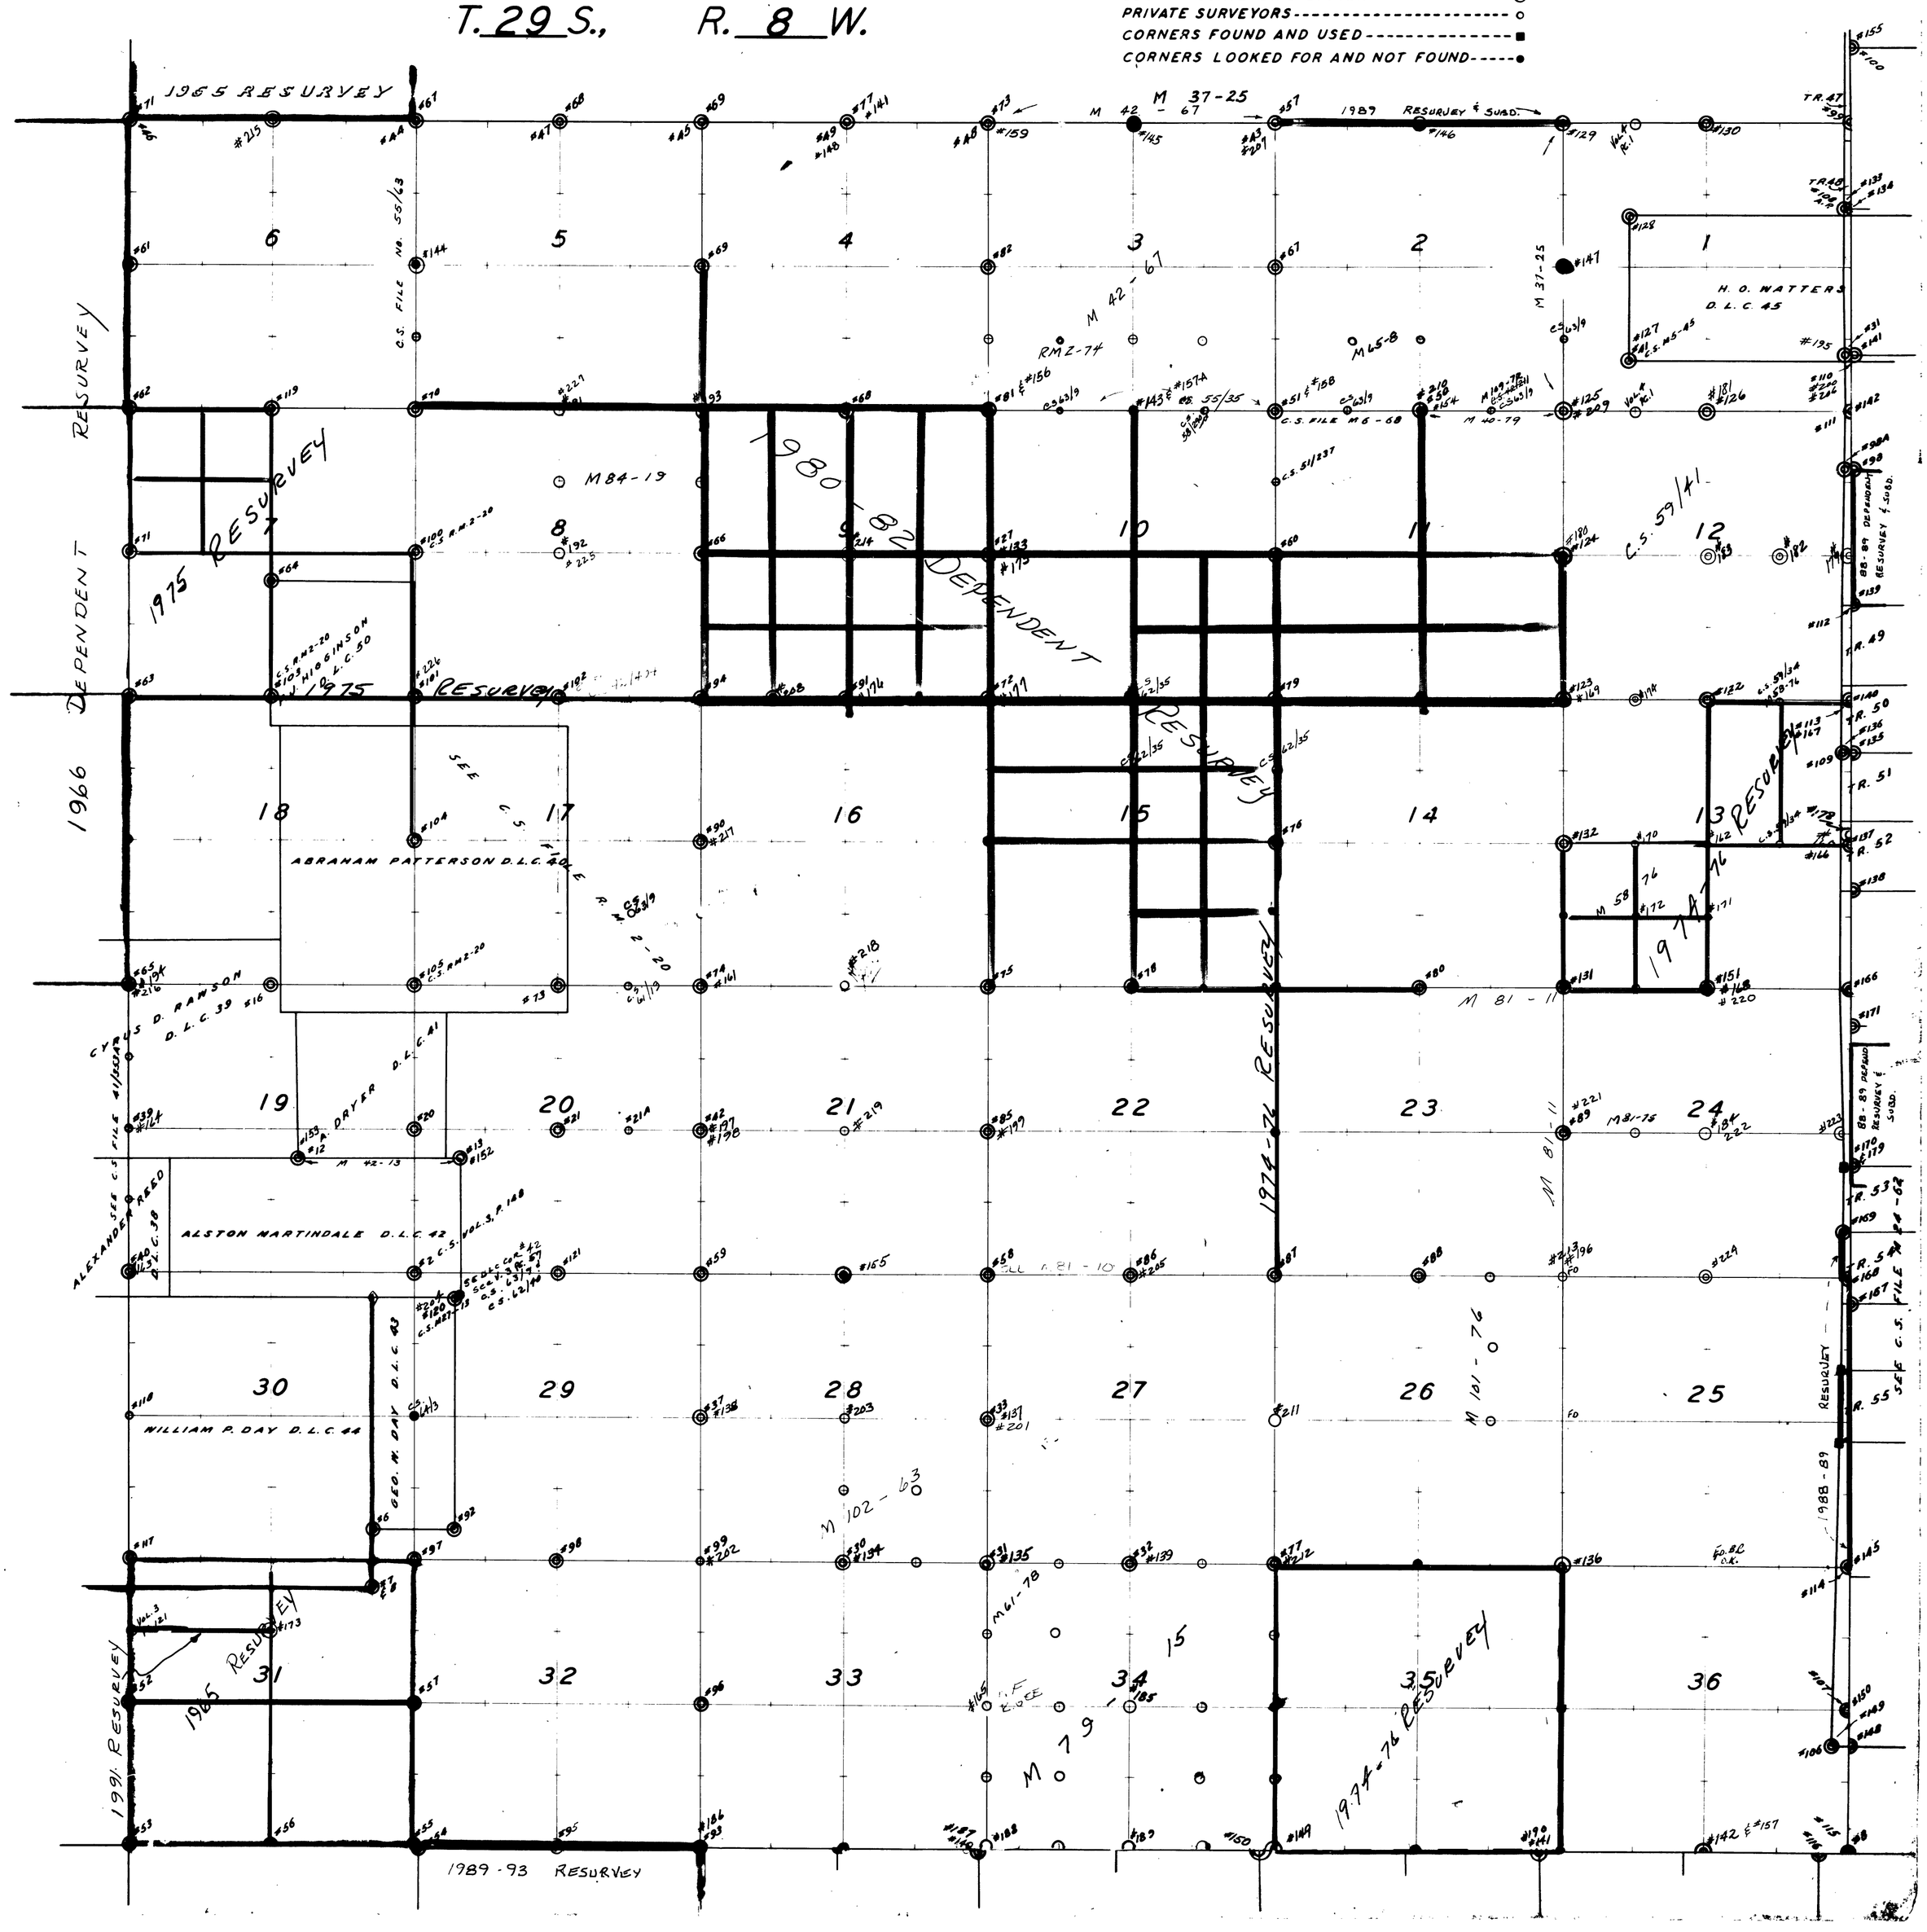
CORNERS RENEWED BY
- BUREAU OF LAND MANAGEMENT ◆
- COUNTY SURVEYOR'S OFFICE ◎
- PRIVATE SURVEYORS ○
- CORNERS FOUND AND USED ■
- CORNERS LOOKED FOR AND NOT FOUND ●