103

CORNERS RENEWED BY
BUREAU OF LAND MANAGEMENT ----------
COUNTY SURVEYOR'S OFFICE ----------
PRIVATE SURVEYORS ----------
CORNERS FOUND AND USED ----------
CORNERS LOOKED FOR AND NOT FOUND -----
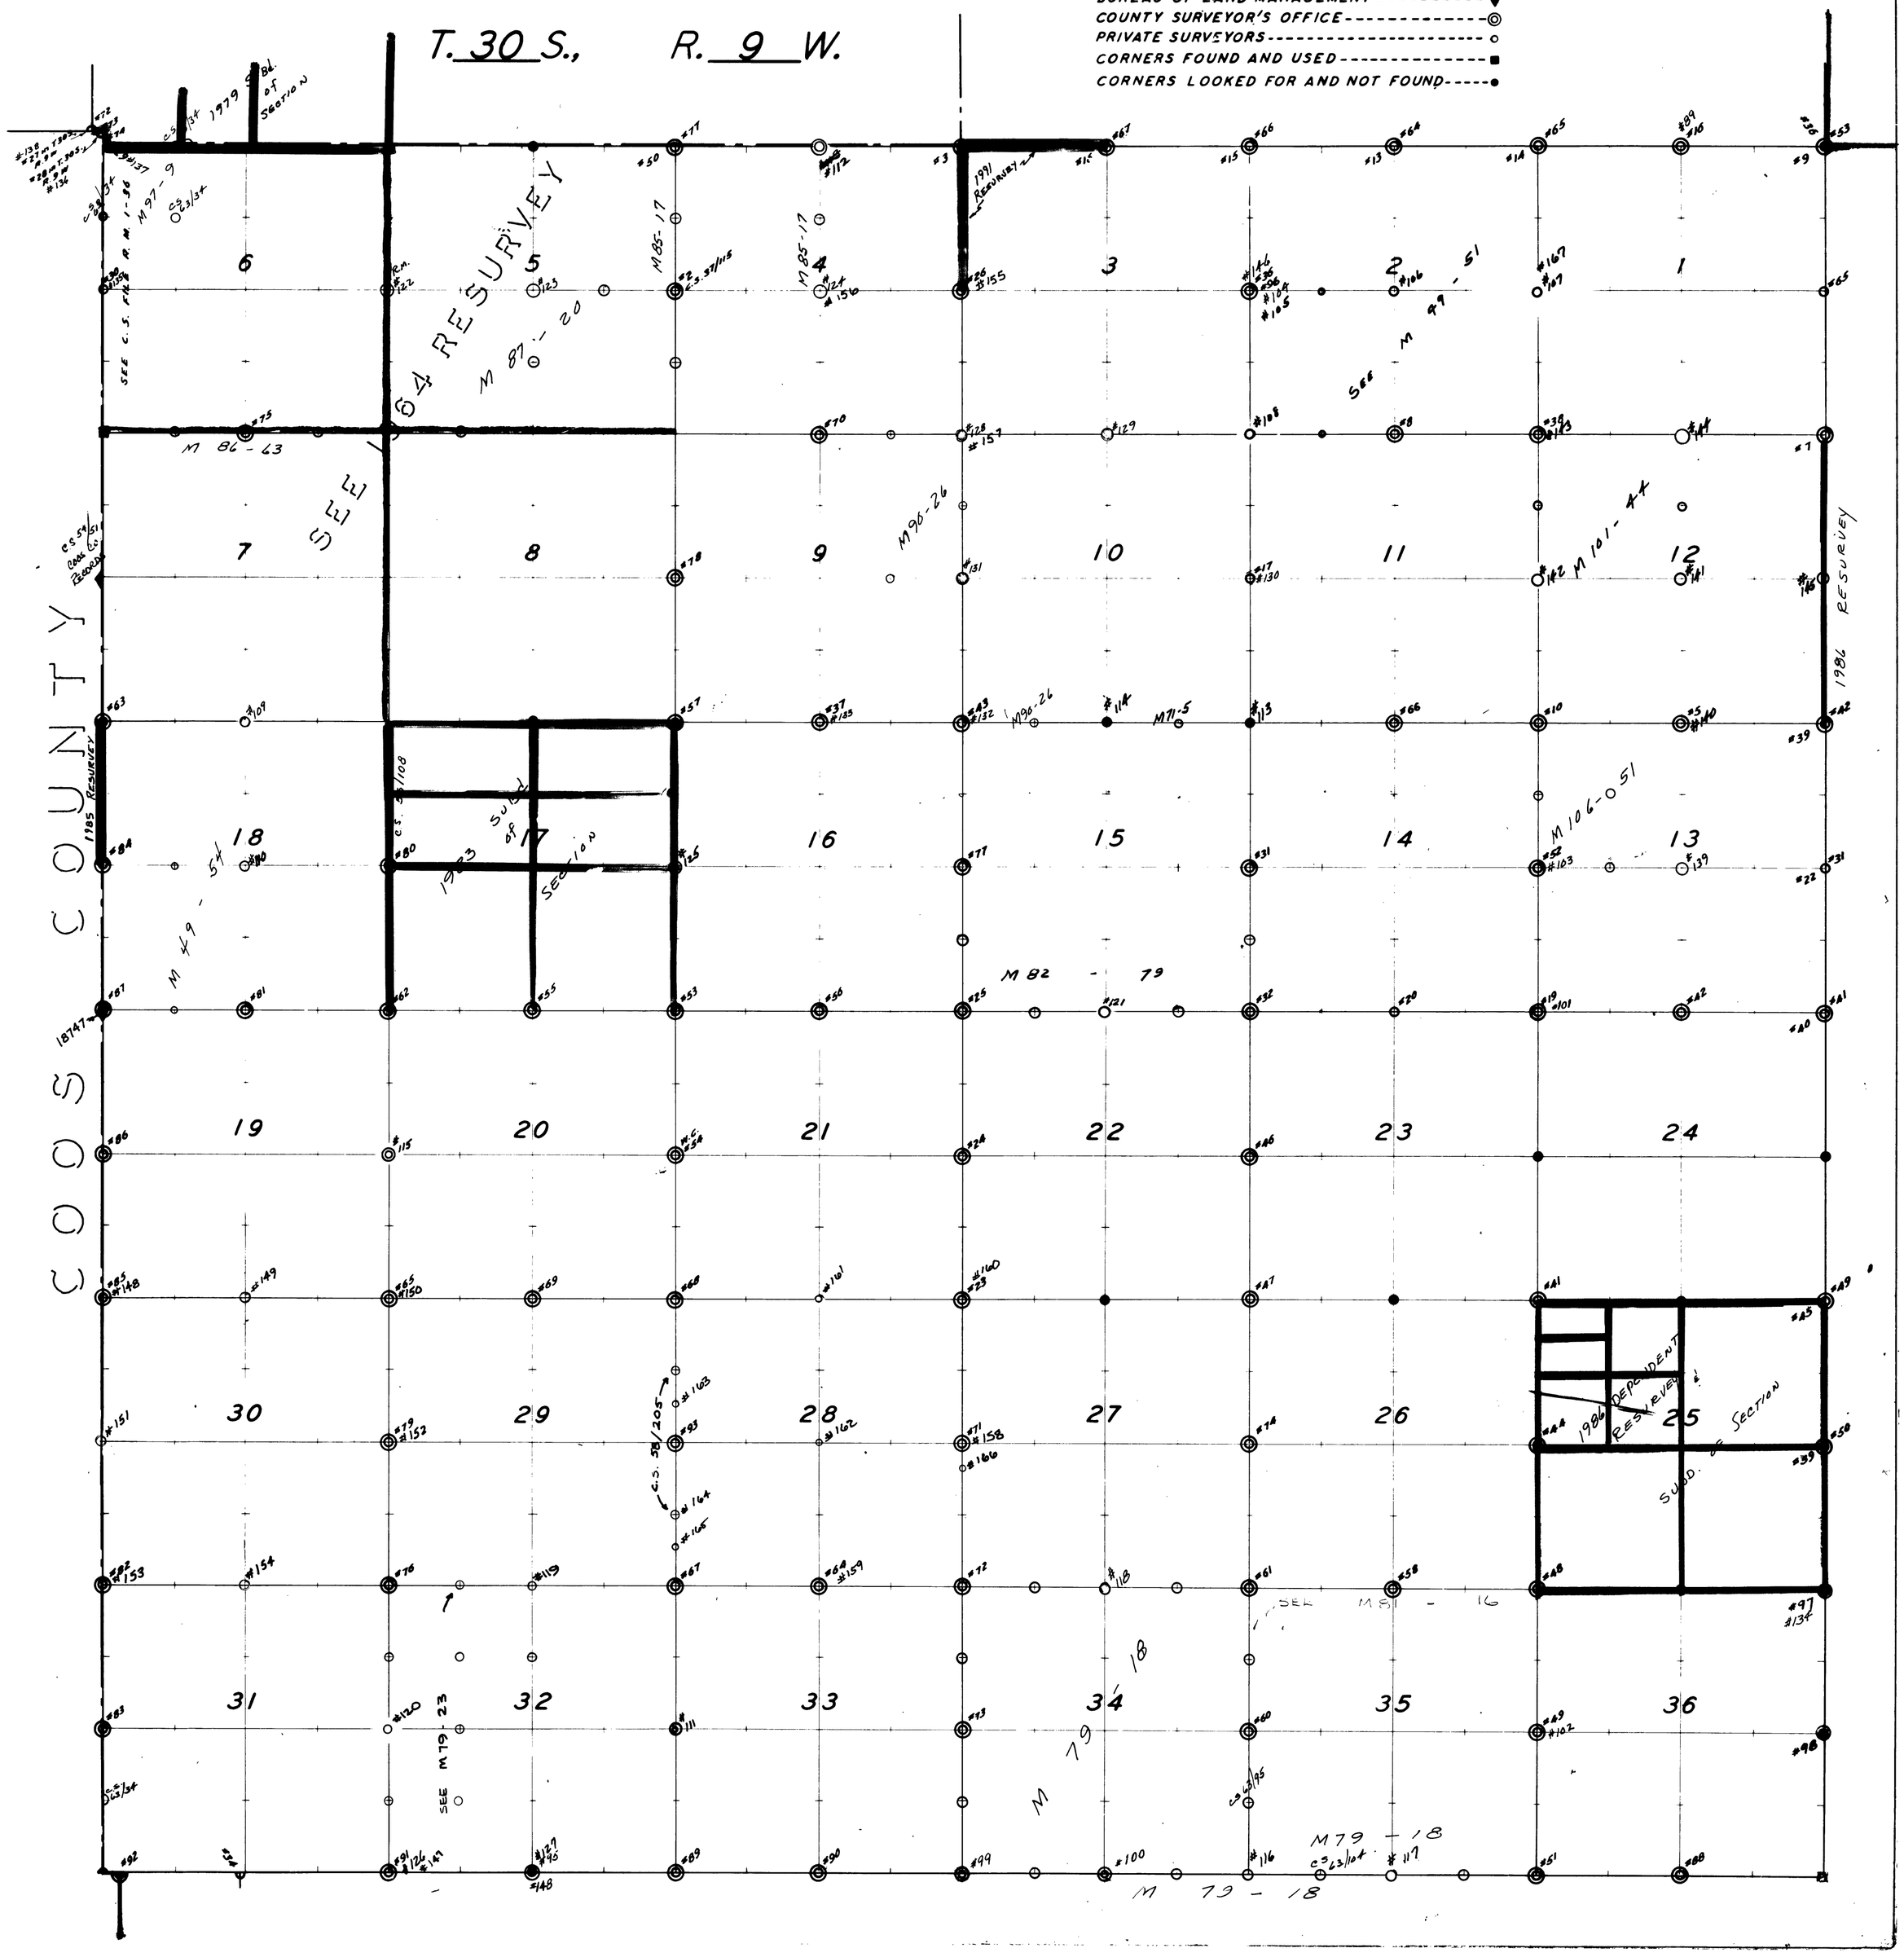
# T. 30 S., R. 9 W.