#105

CORNERS RENEWED BY
BUREAU OF LAND MANAGEMENT ----------◆
COUNTY SURVEYOR'S OFFICE ----------◎
PRIVATE SURVEYORS ----------○
CORNERS FOUND AND USED ----------■
CORNERS LOOKED FOR AND NOT FOUND -----●
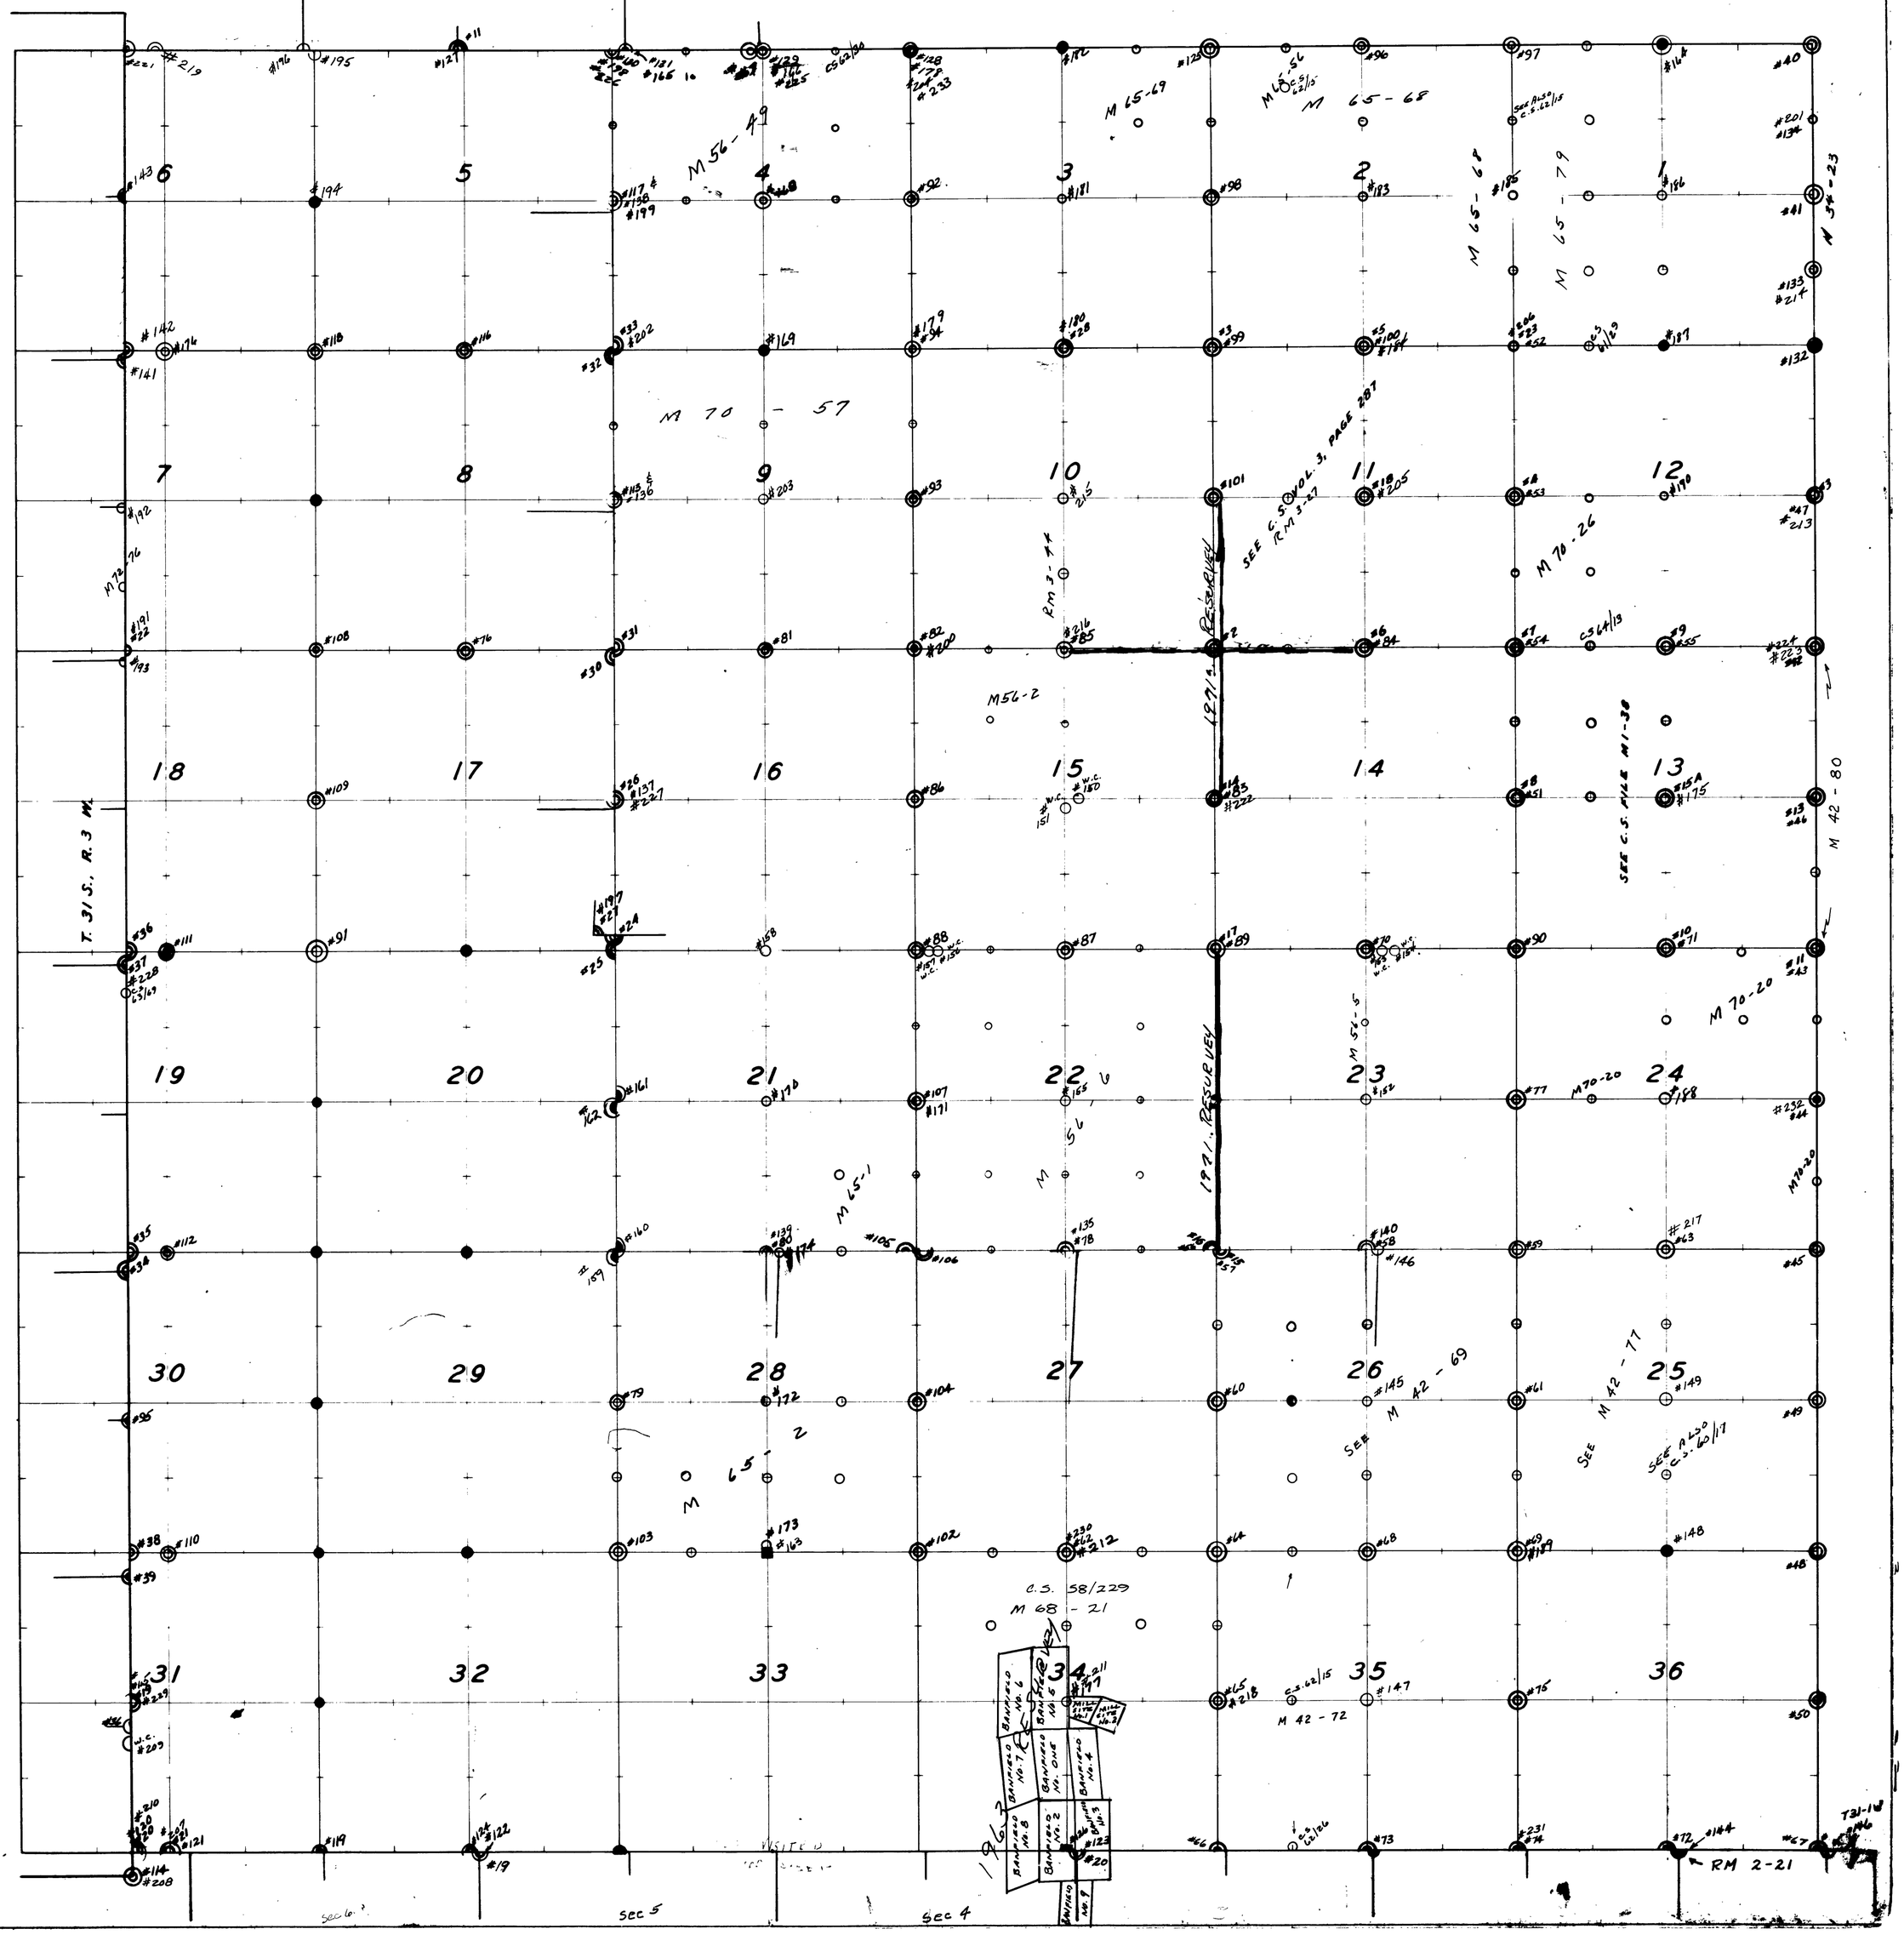
T. 31 S., R. 2 W.