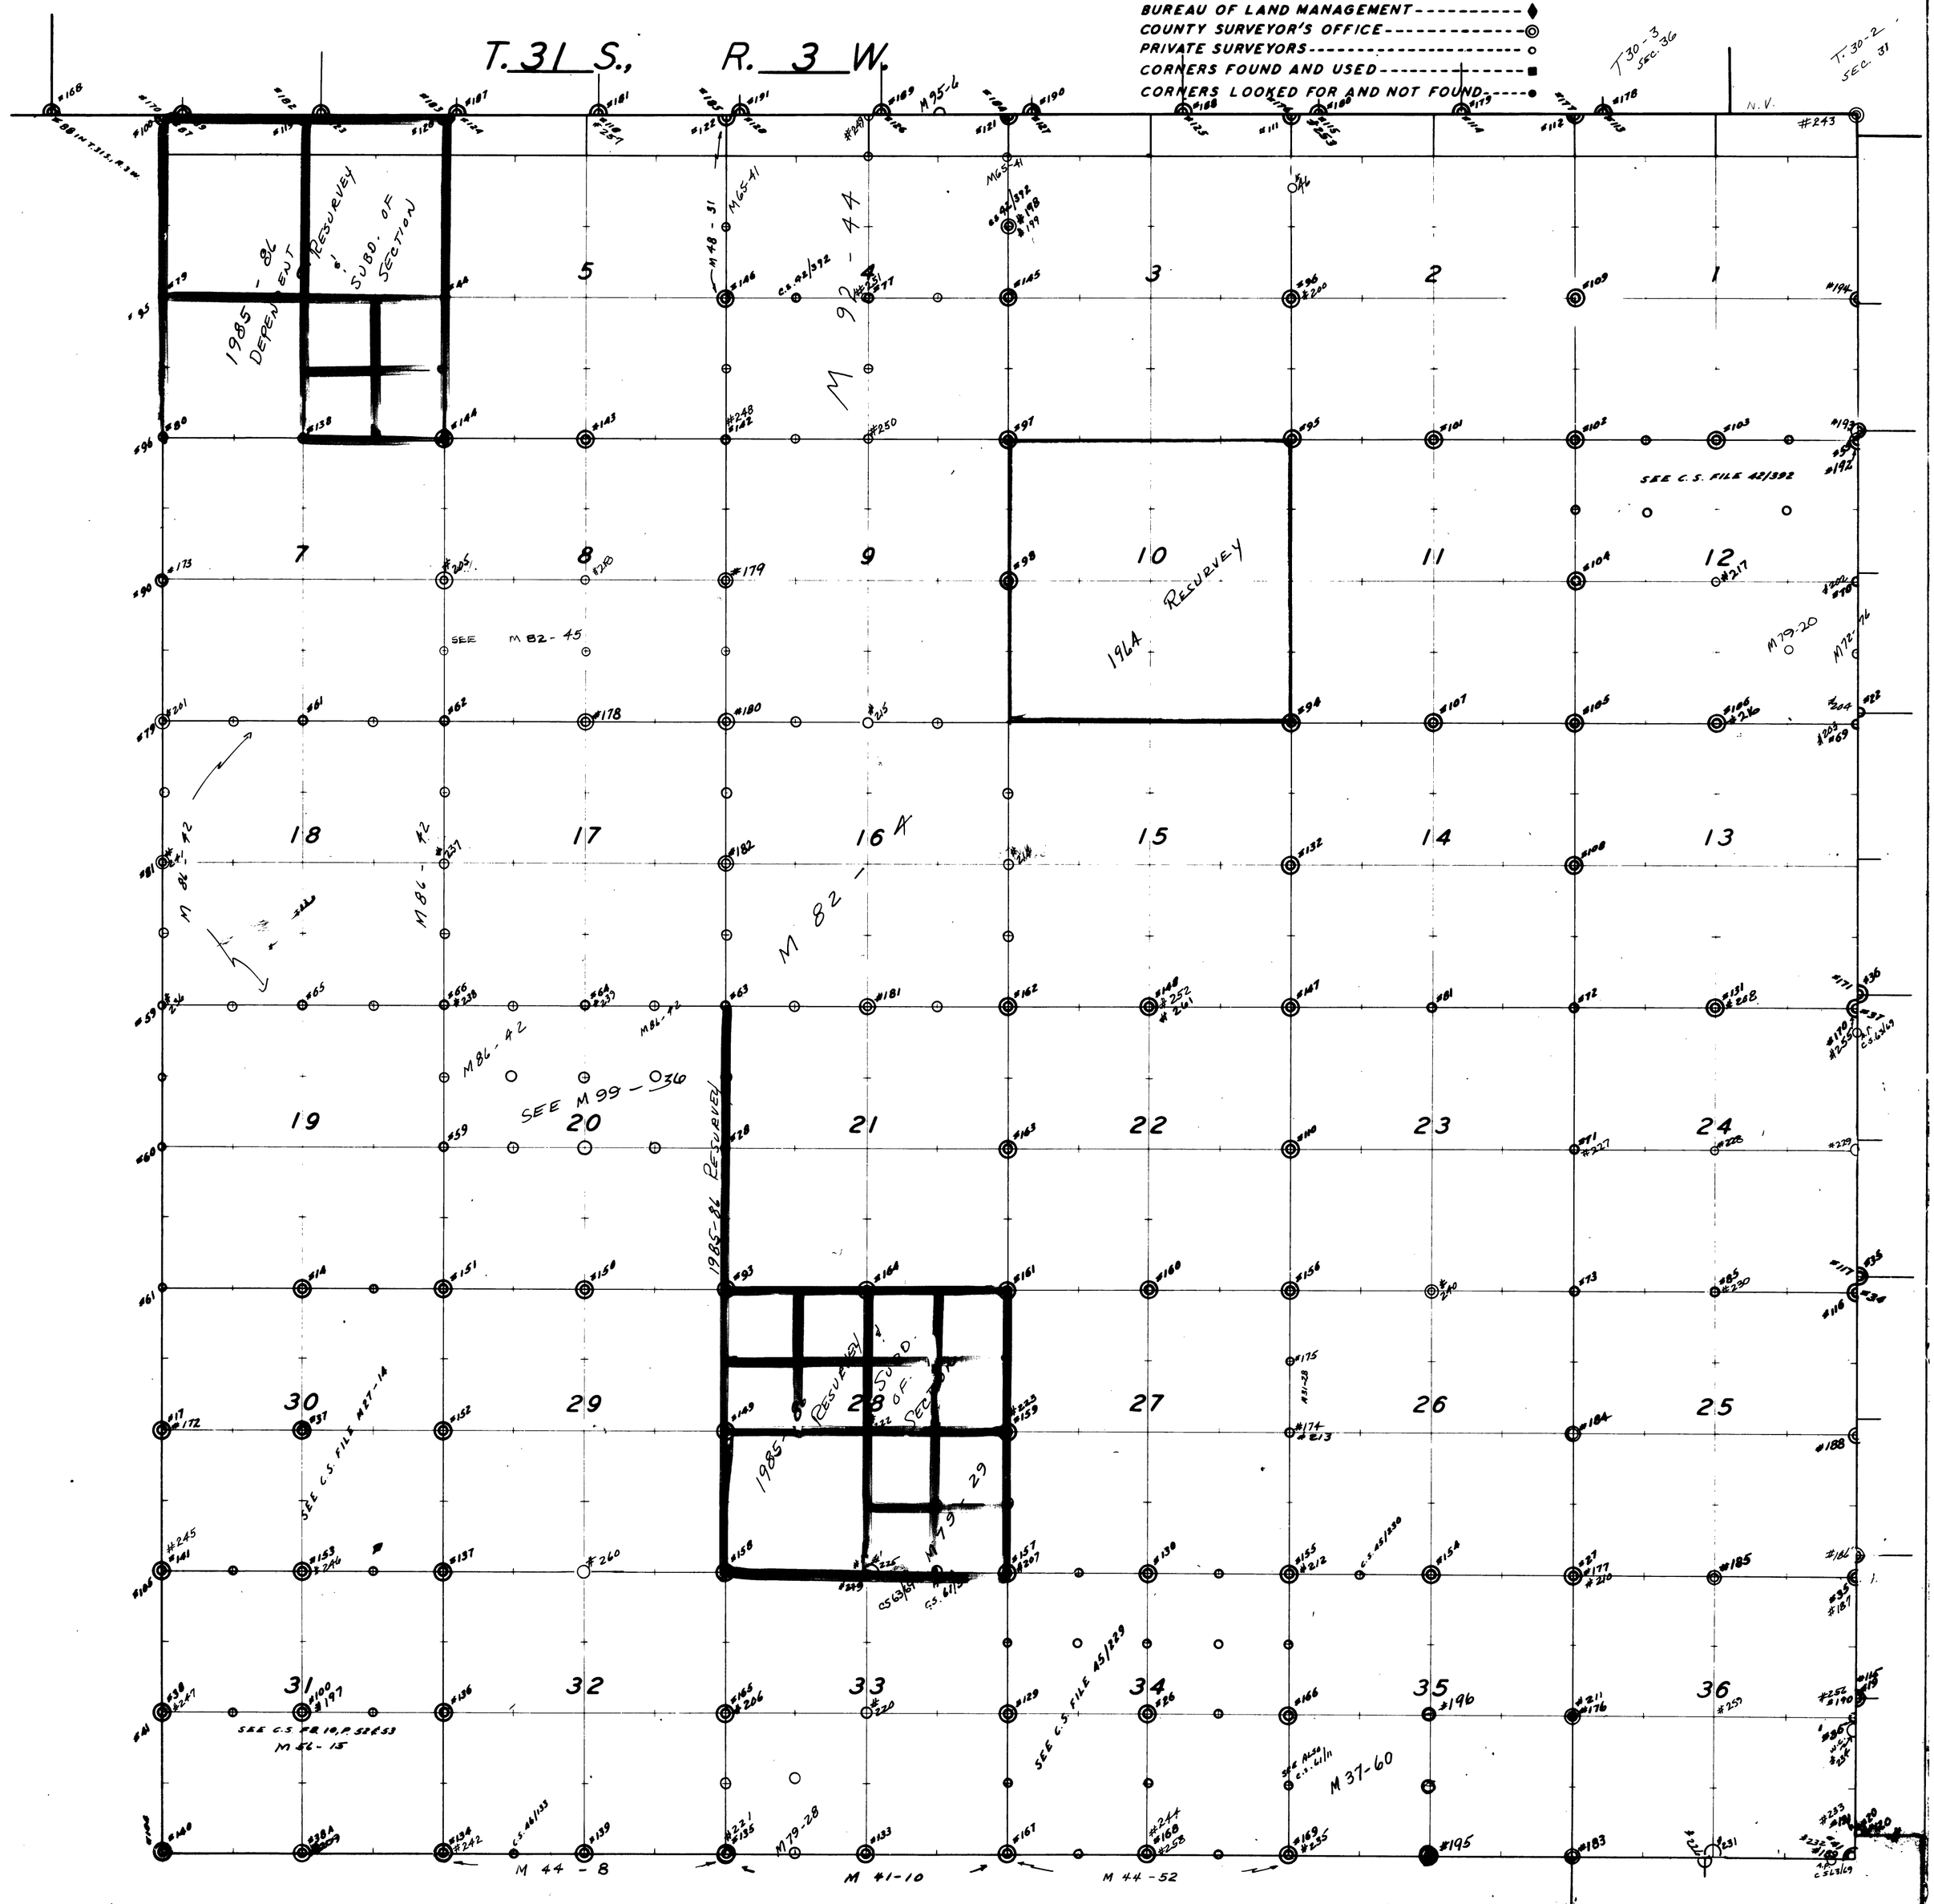
CORNERS RENEWED BY
BUREAU OF LAND MANAGEMENT
COUNTY SURVEYOR'S OFFICE
PRIVATE SURVEYORS
CORNERS FOUND AND USED
CORNERS LOOKED FOR AND NOT FOUND
T. 31 S., R. 3 W.
T 30-3 SEC. 36
T. 30-2 SEC. 31
N.V.
1985-86 RESURVEY & SUBD. OF SECTION
1985-86 DEPENDENT RESURVEY
M 92-44
M 82-
M 86-
M 86-42
SEE M 99-036
SEE M 82-45
SEE C.S. FILE M 27-14
SEE C.S. FILE 45/229
SEE C.S. FILE 42/392
SEE C.S. FR 10, P. 52 & 53
M 86-15
M 37-60
M 44-8
M 41-10
M 44-52
M 79-28
M 79-29
M 79-20
M 72-96
M 95-6
M 48-31
M 65-41
196A
16A