CORNERS RENEWED BY
BUREAU OF LAND MANAGEMENT ---------- ◆
COUNTY SURVEYOR'S OFFICE ---------- ◎
PRIVATE SURVEYORS ---------- ○
CORNERS FOUND AND USED ---------- ■
CORNERS LOOKED FOR AND NOT FOUND ----- ●
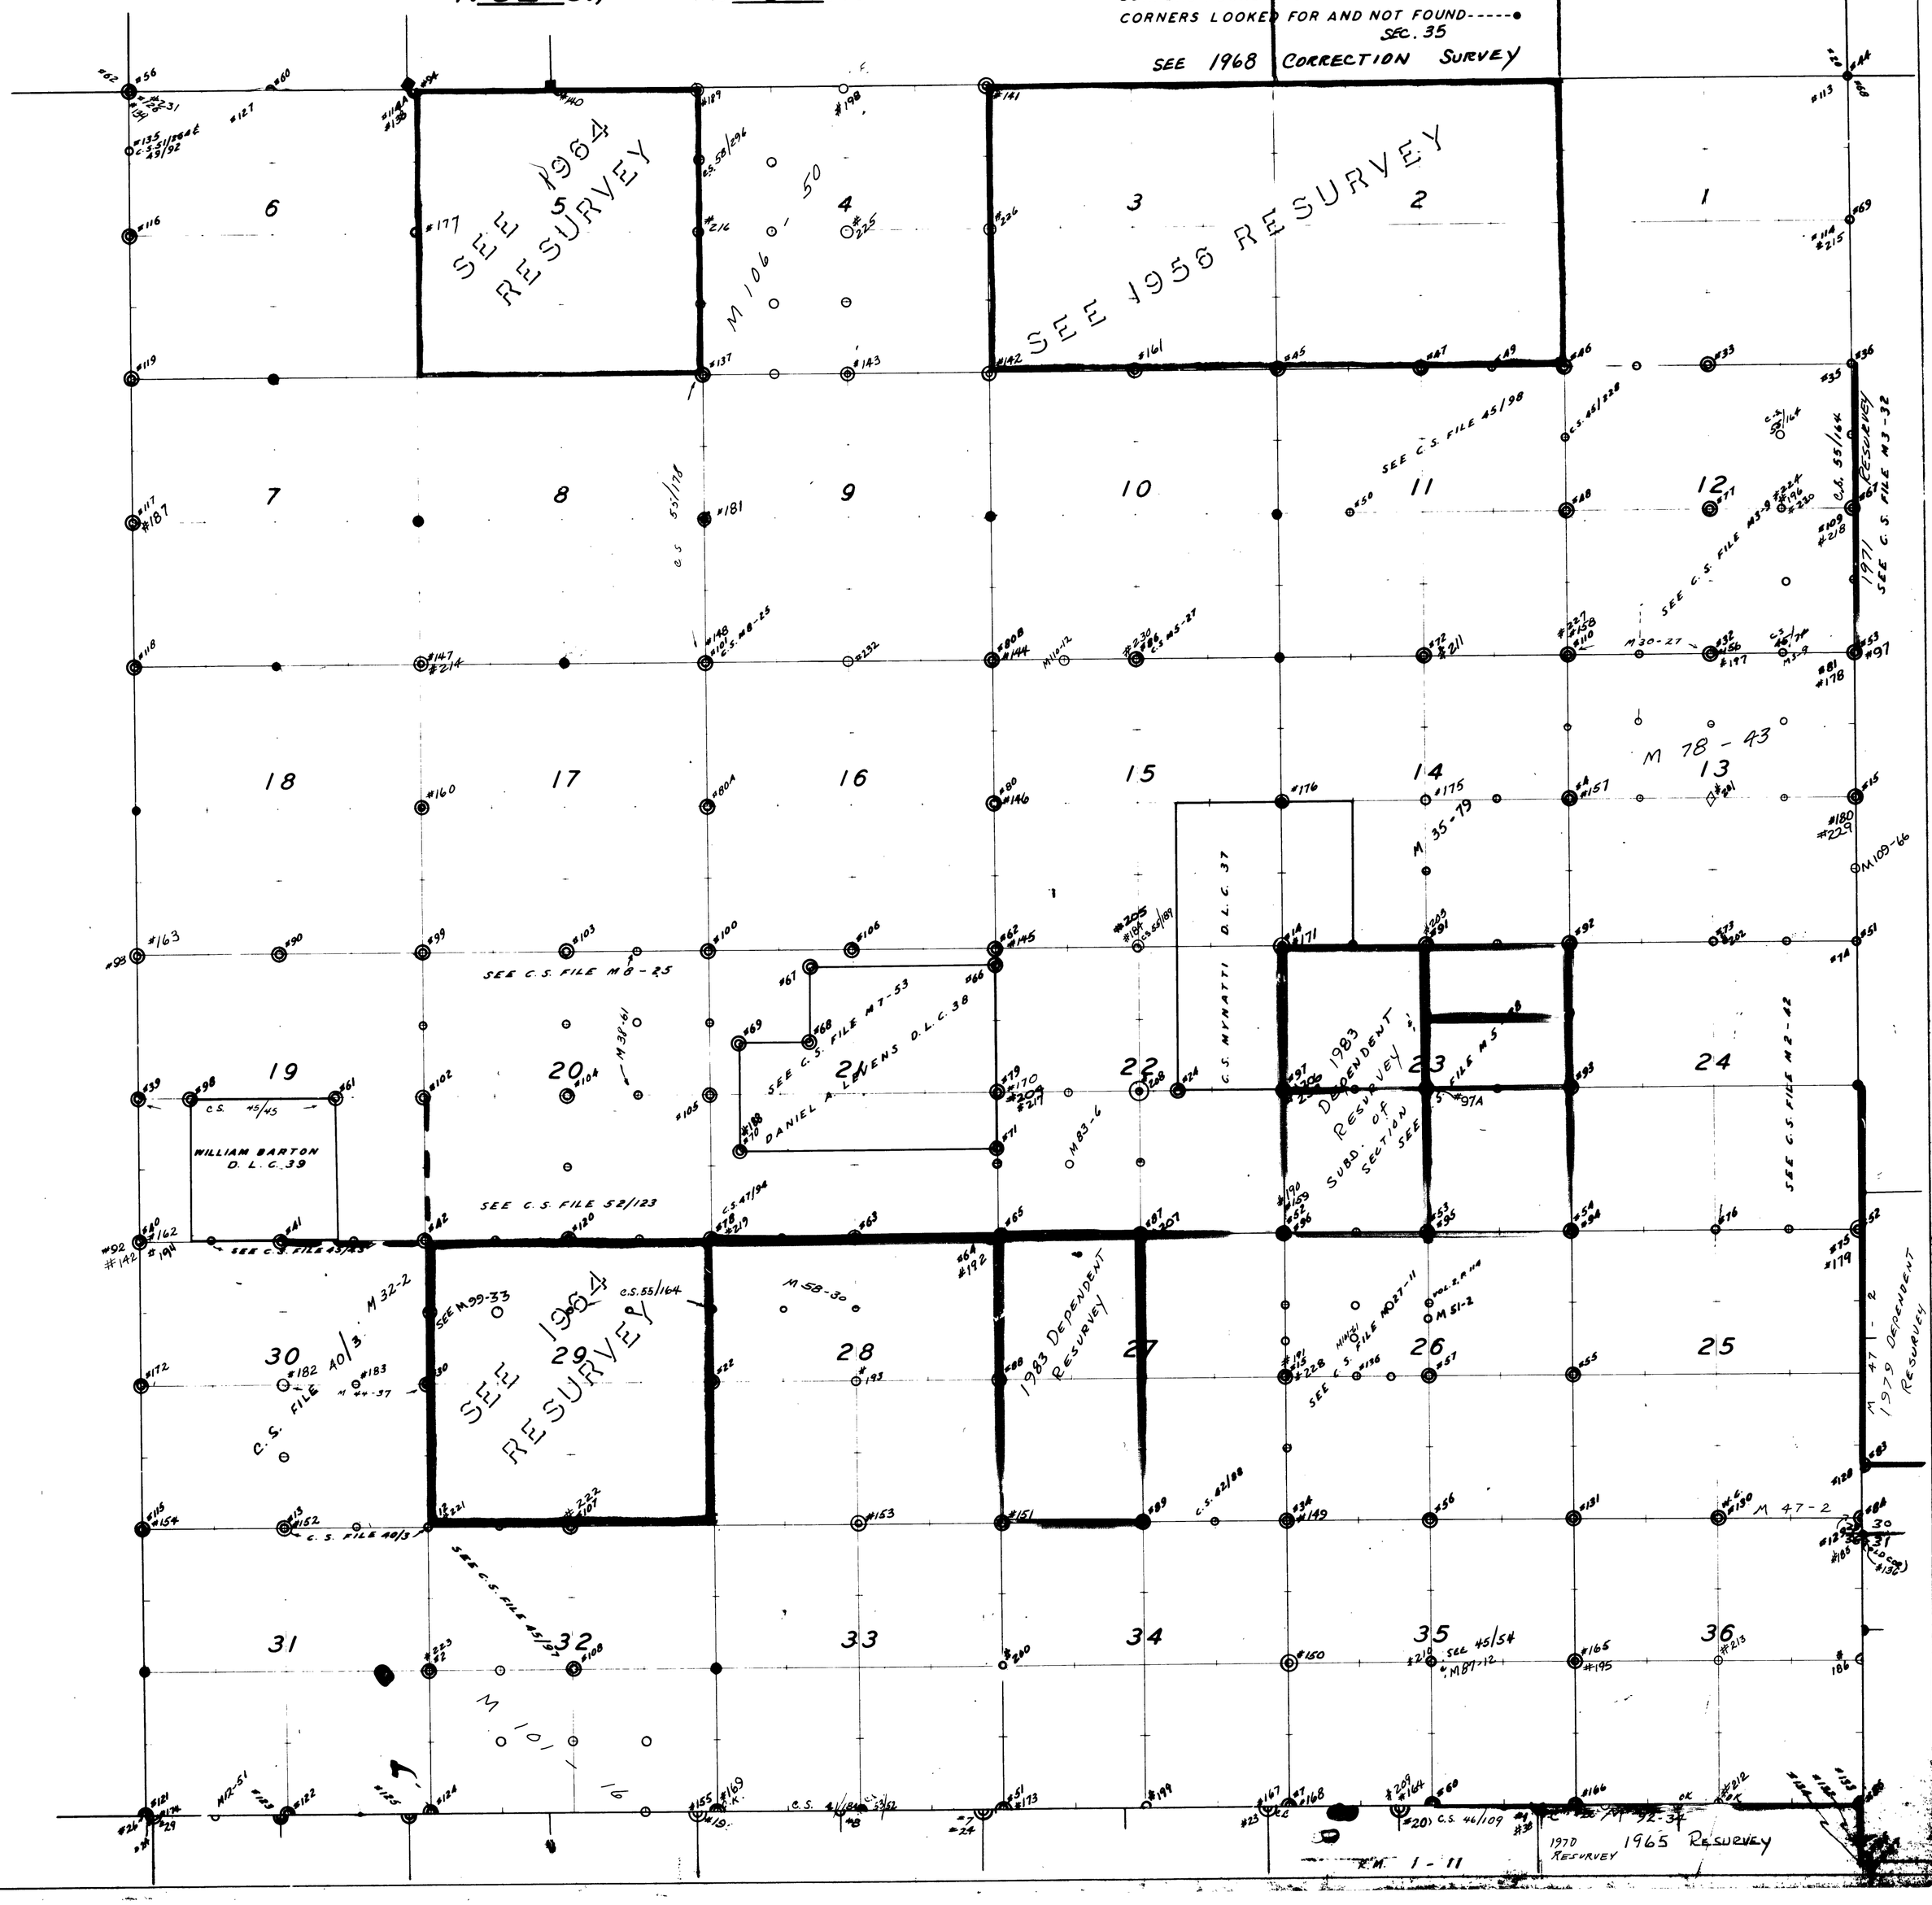
T. 32 S., R. 5 W.