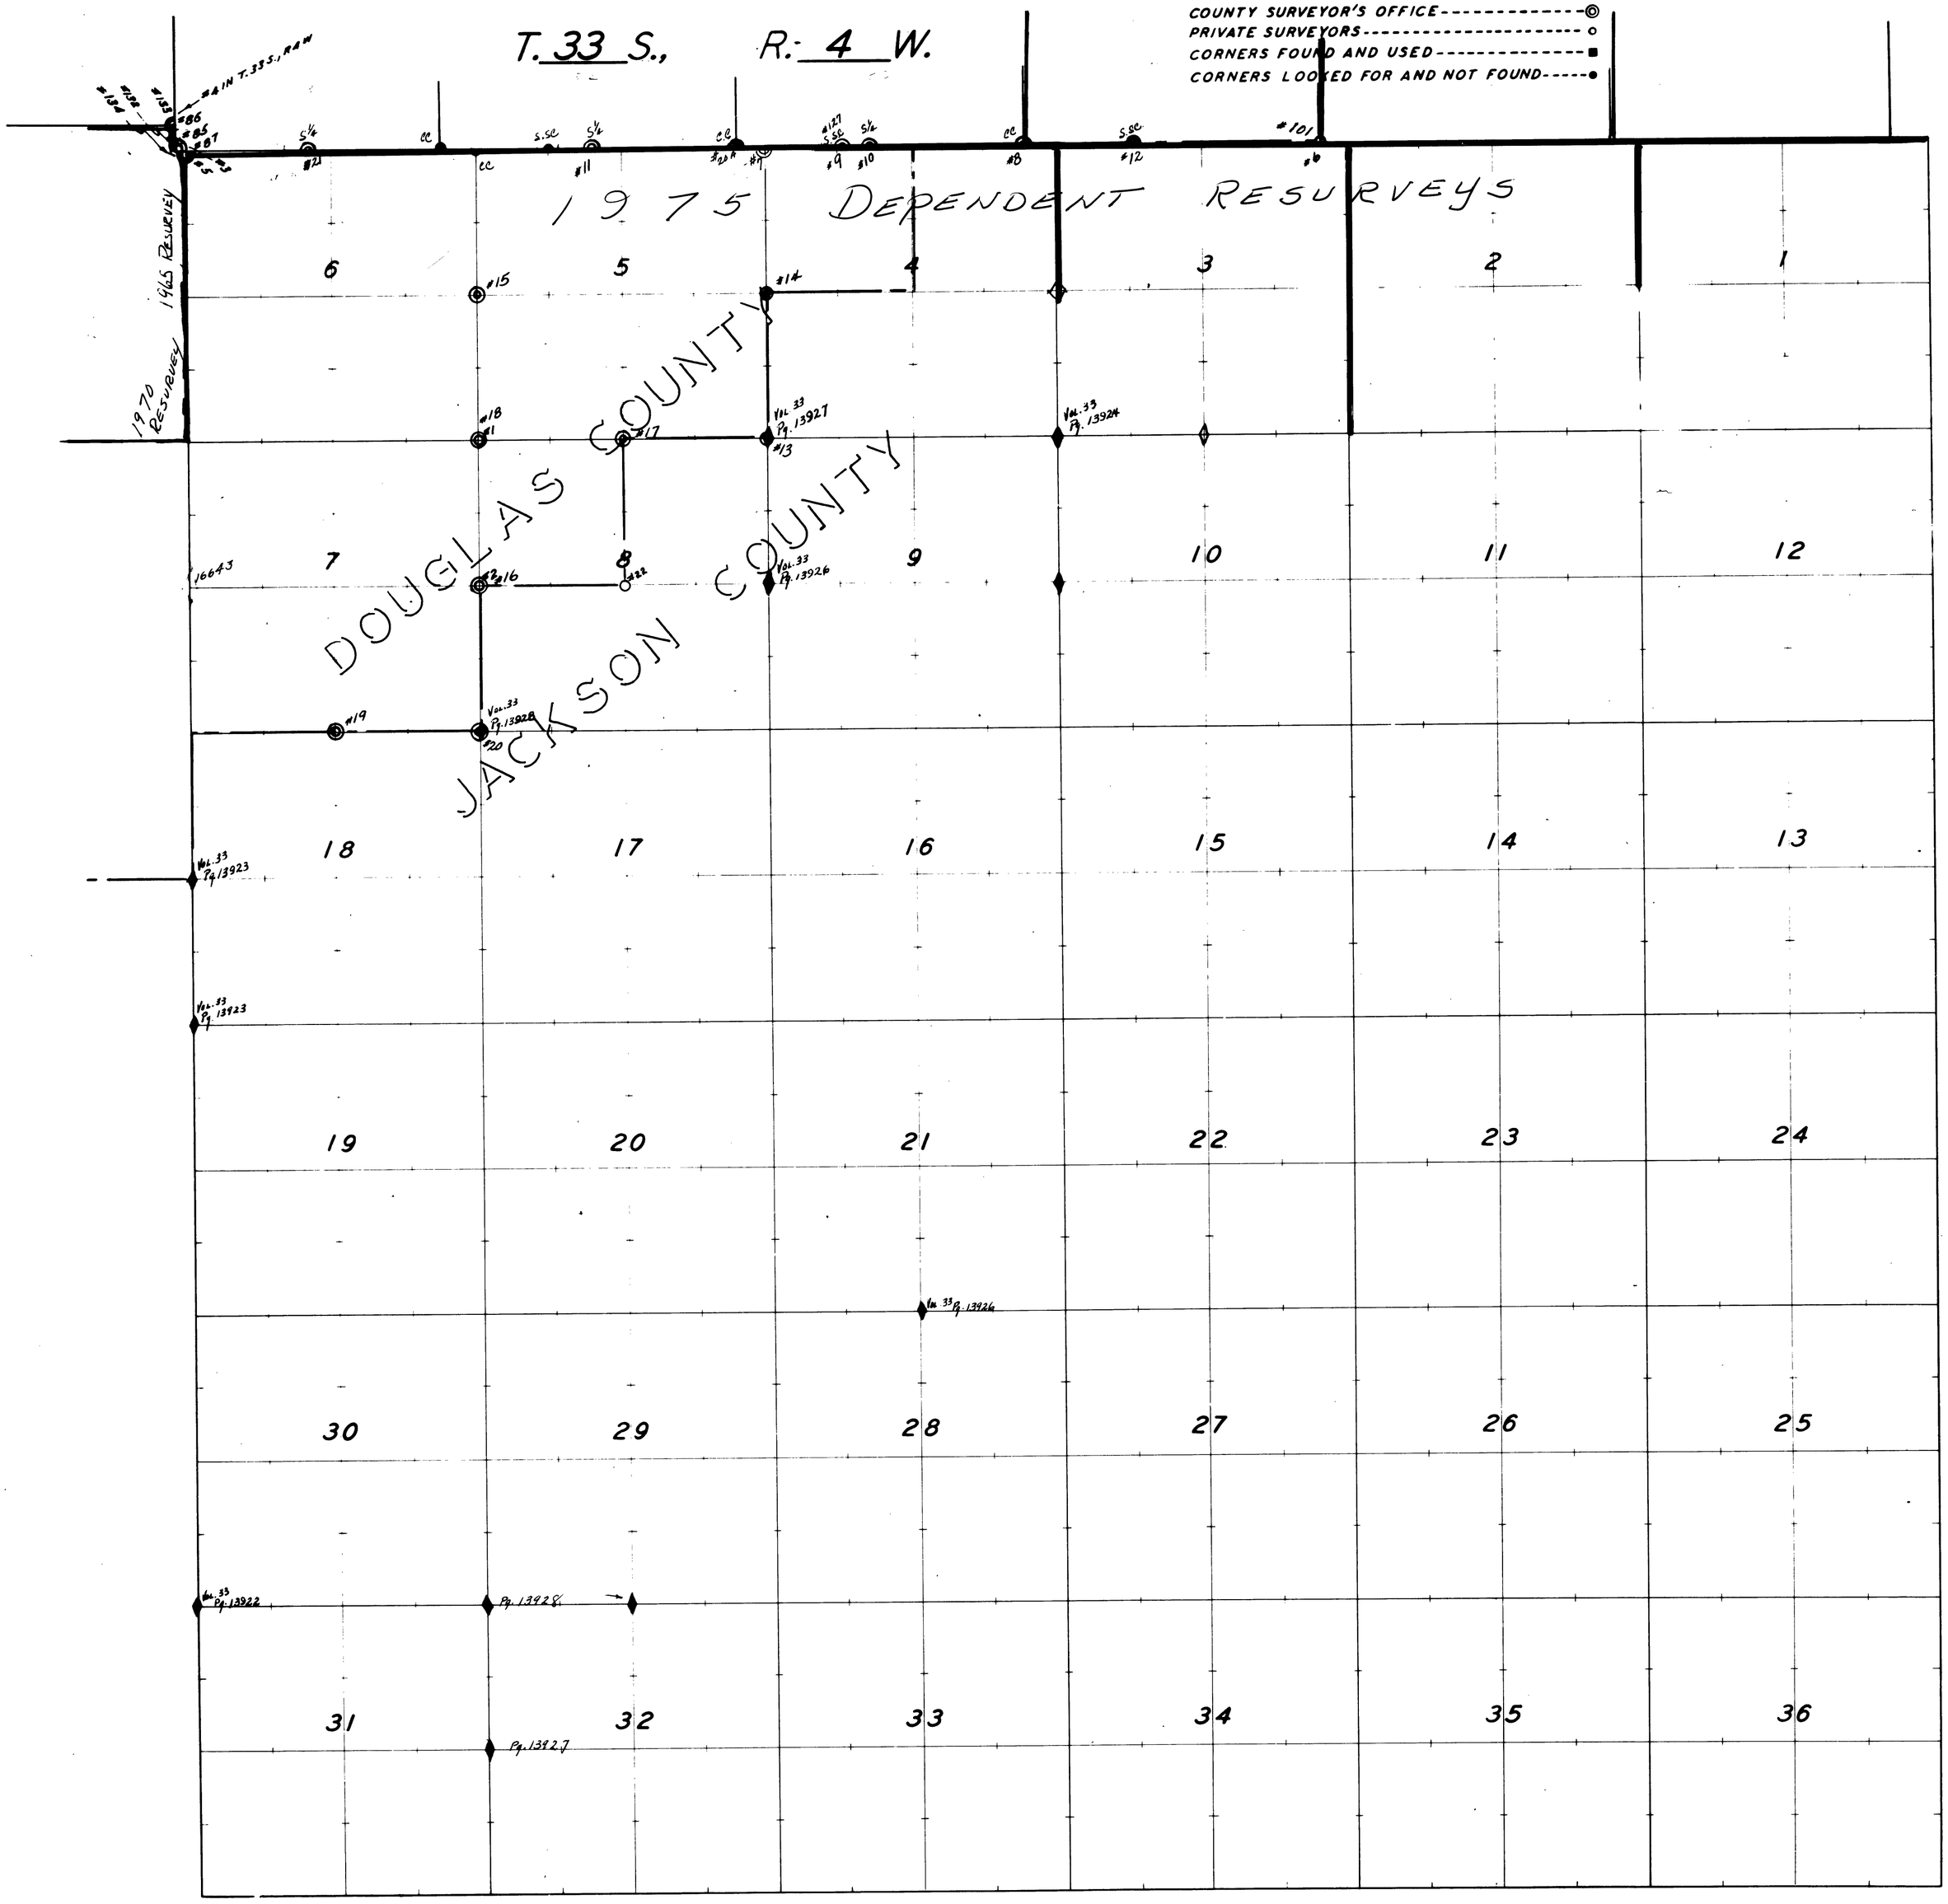
CORNERS RENEWED BY
BUREAU OF LAND MANAGEMENT
COUNTY SURVEYOR'S OFFICE
PRIVATE SURVEYORS
CORNERS FOUND AND USED
CORNERS LOOKED FOR AND NOT FOUND
T. 33 S., R. 4 W.
1975 DEPENDENT RESURVEYS
1965 RESURVEY
1970 RESURVEY
DOUGLAS COUNTY
JACKSON COUNTY
Vol. 33 Pg. 13927
Vol. 33 Pg. 13924
Vol. 33 Pg. 13926
Vol. 33 Pg. 13928
Vol. 33 Pg. 13923
Vol. 33 Pg. 13922
Pg. 13928
Pg. 13927
6 5 4 3 2 1
7 8 9 10 11 12
18 17 16 15 14 13
19 20 21 22 23 24
30 29 28 27 26 25
31 32 33 34 35 36