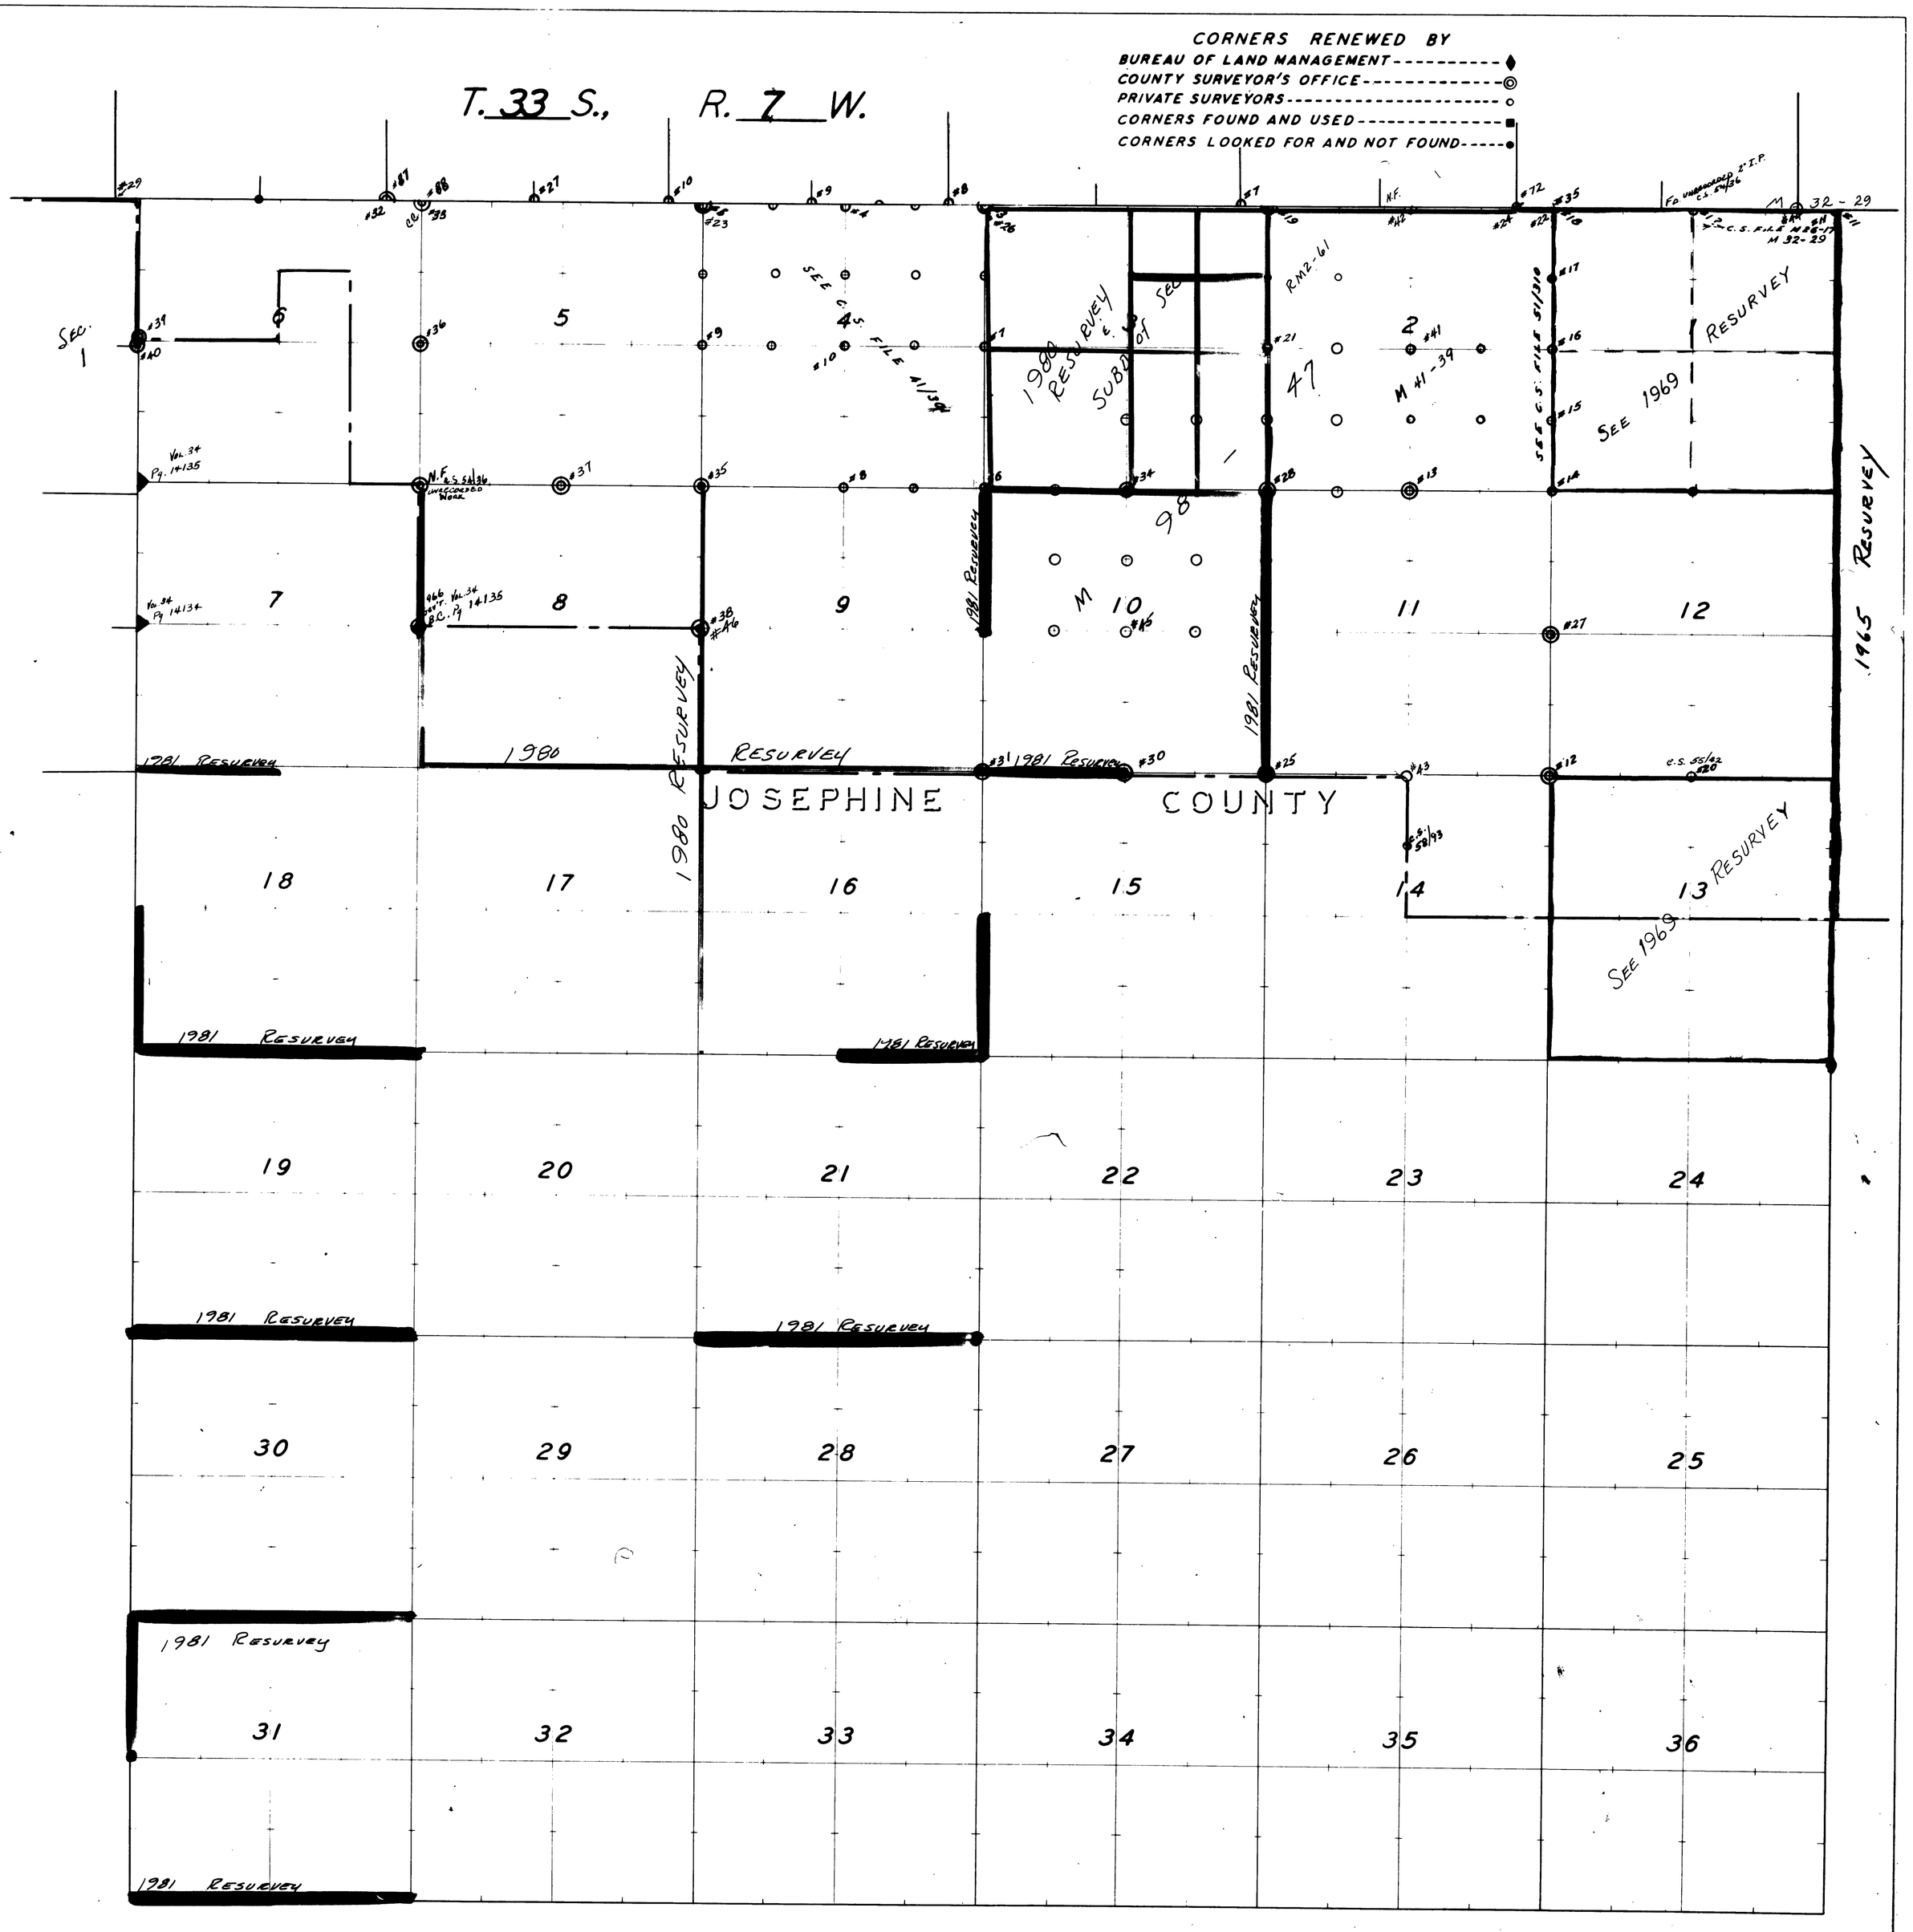
CORNERS RENEWED BY
BUREAU OF LAND MANAGEMENT
COUNTY SURVEYOR'S OFFICE
PRIVATE SURVEYORS
CORNERS FOUND AND USED
CORNERS LOOKED FOR AND NOT FOUND
T. 33 S., R. 7 W.
JOSEPHINE COUNTY
1981 RESURVEY
1980 RESURVEY
1965 RESURVEY
SEE 1969
SEE C.S. FILE 41/194
SEE C.S. FILE 51/310
SEE C.S. FILE N28-17 M 32-29
M 32-29
M 41-39
RM2-61
1980 RESURVEY E. 1/2 OF SEC
SUBD
47
98
M
N.F. C.S. 54/36 UNRECORDED WORK
Vol. 34 Pg. 14135
Vol. 34 Pg. 14134
N.F. C.S. 55/82
C.S. 58/93
C.S. 55/82
SEC. 1