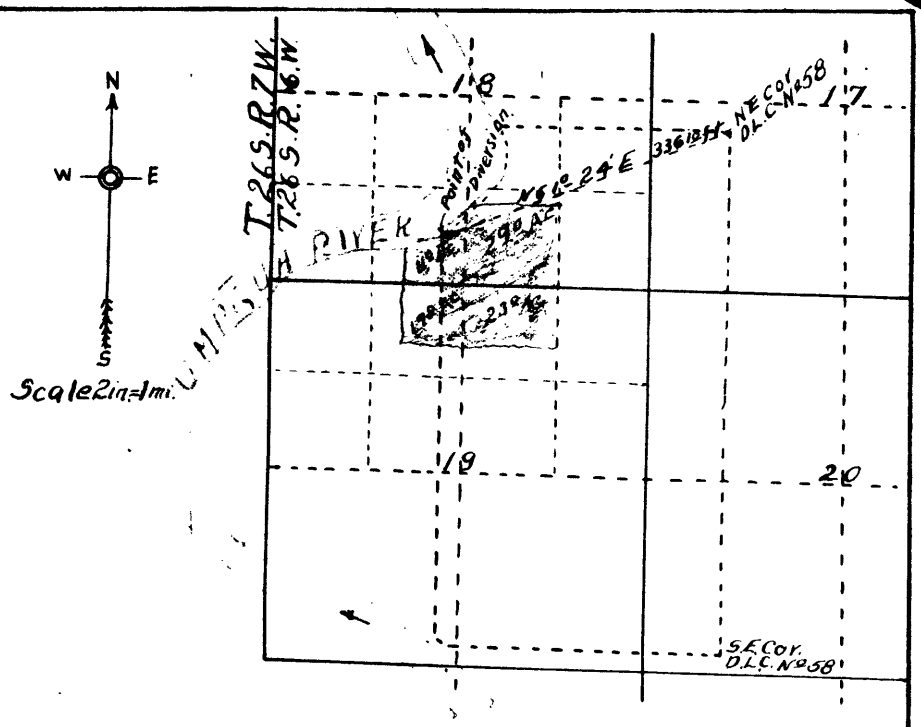

R.H.G. WOOD IRRIGATION SYSTEM

IN

SEC. S 18 & 19 T26S. R6W. Wil. Mer.

DOUGLAS CO. ORE.

Office of F.C. Frear Co. Surv.

Jan. 1921

CERTIFICATE OF SURVEYOR

I. H.L. Eppstein of Roseburg Oregon, do hereby certify that this map was made from note taken during an actual survey made by me on Jan. 23. 1921. and that it correctly represents the works described in the accompanying application to gather with the location of streams and other ditches in the immediate vicinity.

H. L. Eppstein

Dep Co. Surveyor.