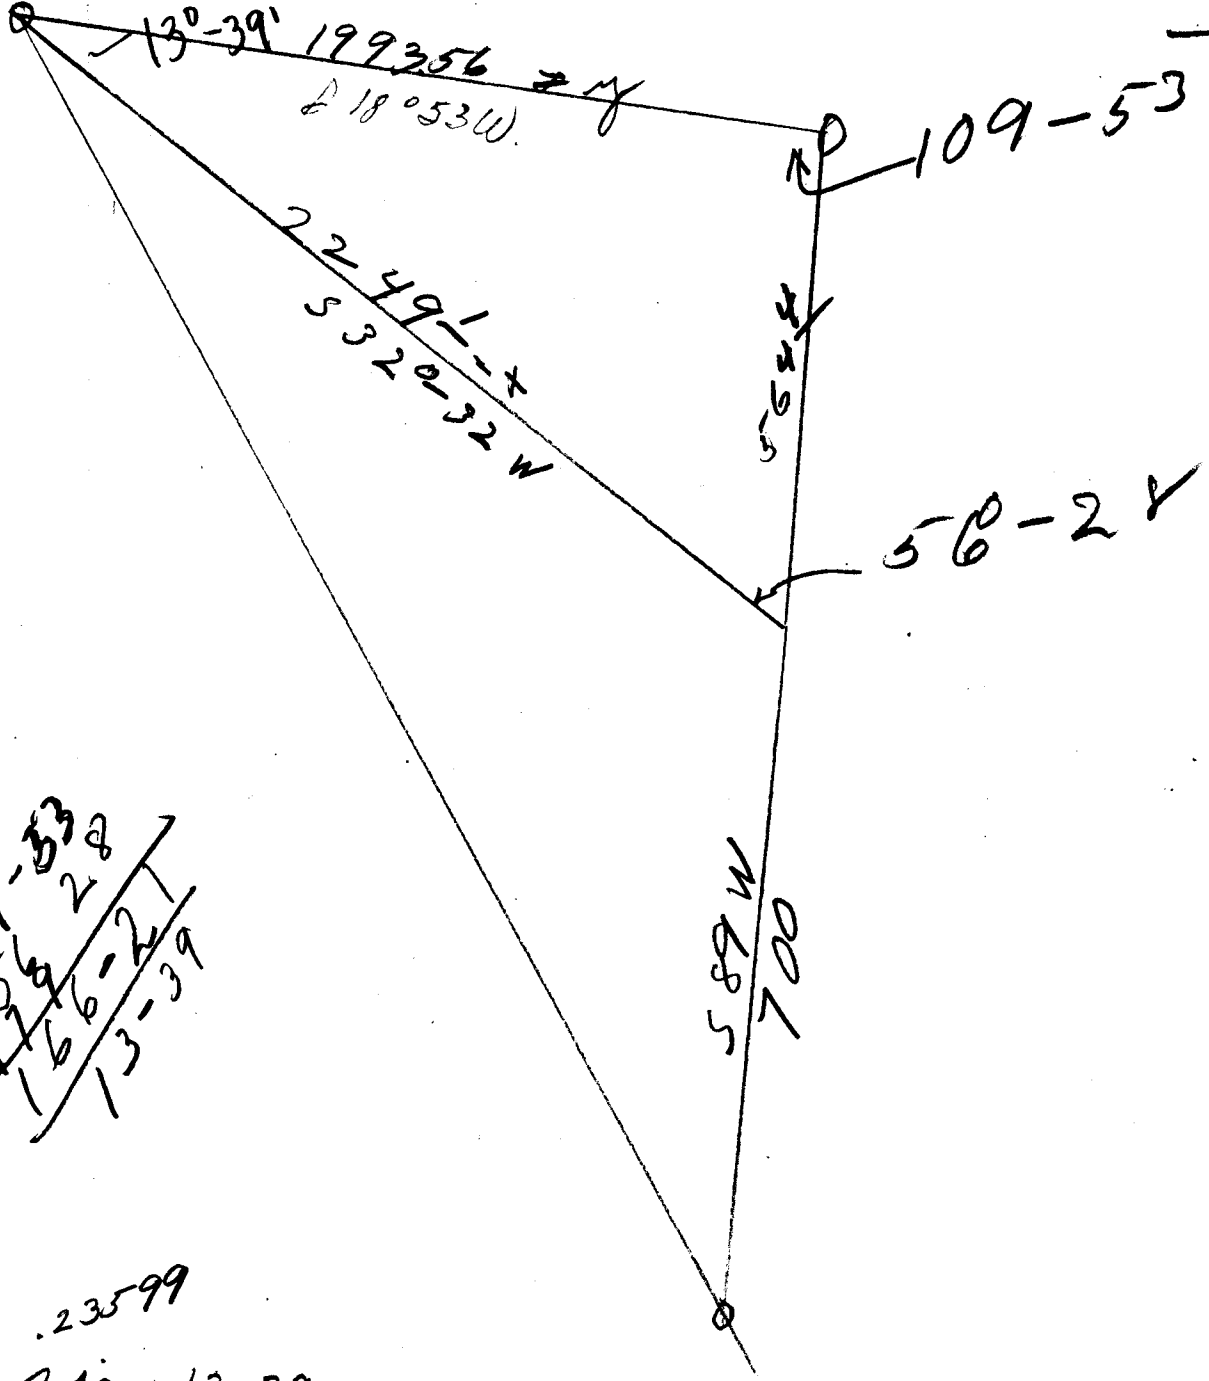

109-53
56-24
166-21
13-39

.23599

$$\frac{\sin 13\text{-}39}{\sin 70°\text{-}07} = \frac{564.4}{x}$$

.94039

$$\frac{530\,756116}{.23599}$$

$$x = 2249'$$

$$\frac{\sin 13\text{-}39}{\sin 56\text{-}28} = \frac{564.4}{y}$$

83336

$$y = \frac{470.461264}{.23599}$$

89
56-28
32-32

179
109-53
70-07

Description 2664 P. foot road
From ℄ L. Branton to E E Dent.

Beginning at a point which bears
N 45°-01' E 2699.5 feet from the North
West Corner of L.D.L. C. 43. T 27 S
R 4 W. W.M. Douglas County Oregon
Thence S 89° W 1264 feet along
the centerline of a 40 foot road. 20 feet
on each side of said center line, to
ending point. Containing 1.16 acres
of land more or less.

SURVEYS AND ESTIMATES
OFFICE IN THE COURT HOUSE
PHONE 281

F. C. FREAR
COUNTY SURVEYOR AND ROADMASTER
DOUGLAS COUNTY
ROSEBURG, OREGON

Deseription of 40 f00t road

Deeded

By C. L. Branton to E. E. Dent

Beginning at a point,which bears N.45° OI' E. 2699.5 feet from the North West Corner of the J. Matthews D.L.C. No. 43. T. 27 S. R. 4 W. W. M. Douglas County, Oregon.
Thence S. 89° 00' W. I264.4 feet along the center line of a 40 foot road; 20 feet on each side of said center line, to ending point.
Containing I.I6 acres more or less.

C. S. File No. 4/40

CS FILE FOLDER

CONTAINS

MORE

INFORMATION