

C. S. 4-70

Camas School.

Dist. No.

C. S. File No. 4/70

⊕

School

		-	+		
$\Delta 7$					N 89-44W
$\Delta 0$	2720		20°-22'		569-54W
$\Delta 11$	1355		69°-32'	369 W	50-22W
NE cur $\Delta 10$			90°	S 89 W	
	210		10°		589-38E
NE cur $\Delta 9$	35L	20			N 80-22E
$\Delta 8$	35L		15°		579-38E
$\Delta 7$	on line 65	10°			N 85-22E
$\Delta 6$	65		5°		584-38E
$\Delta 5$	60		80°	S 89 E	589-38E
NW cur $\Delta 4$	40		10°		N 10-22E
$\Delta 3$	192		890°	N 1° E	N 0-22E
SW cur $\Delta 2$	282				N 89-38W
$\Delta 1$	1920				N 89-38W
$\Delta 0$					

		-	+		
Δ 4	275 ⁵⁻¹³⁶	2719	8-32		50-30W 50-48W
Δ 3	192 ⁵⁰	191.3		5-07	51W 51-70W
Δ 2		12.0	7-34		5-10 53-50E
Δ 1	100.4				55-20W 55-44W
NEWS BTDL Tie old BT DLC		33*	52-08		54-30E
Δ 4		98.7		14 ⁰ -52'	512-30W 512-34W
Δ 3		438.5		91-48	51-30E 52-18E
2		626.5	7-16		N 87E N 86-54E
Δ 1		719.5!			
272 ⁰		334 ⁰		2-48	586-50E 1E
NE C...					587-38E

PAINTED BAR
Found old BT

#18 344
RF. 30°S 66°E
RF 20°S 15W 55.9
RF 24°E 76E 13/0

7-14-81

9.9L
7.5L
6.5L
5.5L
4.5L
3.5L
2.5L
1.5L
0.5L

W.G. Cline
W.G. Rely
C.W. Wiley
R.J. Dunton

21-20'
10'
10'

DLC
N.E. Sec.

30 \perp 69-20 left

S71-30E S71-38E

$\Delta 4$

D.L.C.
on NE

3142.4

205 67-05

S67E S67-00⁰⁰

D.L.C.
4.30⁰⁰ 4.12³⁰

711.4

2⁰-39'

S0-28E S0-05W

203.5 0-14'

S2-30E S2-34E

$\Delta 8$

468.5

465.4 2041'

S2-38E S2-20E

3⁰⁰ 5 120⁰⁰

$\Delta 6$

419.1

1-03

S0-21W

$\Delta 5$

449.0 0-24

S0-45E S0-42E

180 515


179.2 1⁰-03

S-30'E S0-18E

$\Delta 4$

1/2 sec in Back light on A3

1/16 sec. Post 10 West

 

4

C. S. File No. 4/70

Elpel & Manfred.

cov Δ 11			
87 17-20	830		
Δ 10			
169 13-20	1642		3.2 ^{note} 8?
Δ 9			
	3880	90°	30°
Δ 8			
	5		90 West
Δ 7			
	482		2.5 ✓
Top hill Δ 6			
	60		1.9 ✓
Δ 5			
238 ⁶ 11	2342		1.8 ✓
Δ 4			
132 ⁸ 15°	1283		1.5 ✓
Δ 3			
	3593		1.3 ✓
Δ 2			
300 200 181°	4802		1.0 ^{note}
Δ 1.			
	2699		west
1429-32	2649.6		0.4 8.

Fell 8.5 feet North of corner

county road,

Found old B.T.

R Fiv 10" N42W
" " 6" S41W

32

29 Wit	CREAY
G.W.S.	Wade
Henry	Eipel
Antony	Manfred
Sam	"
T.C.	wiley

