

Sta

1

472.05

2

472.20

3

469.95

4

469.35

5


467.95

6

468.53

7


468.99

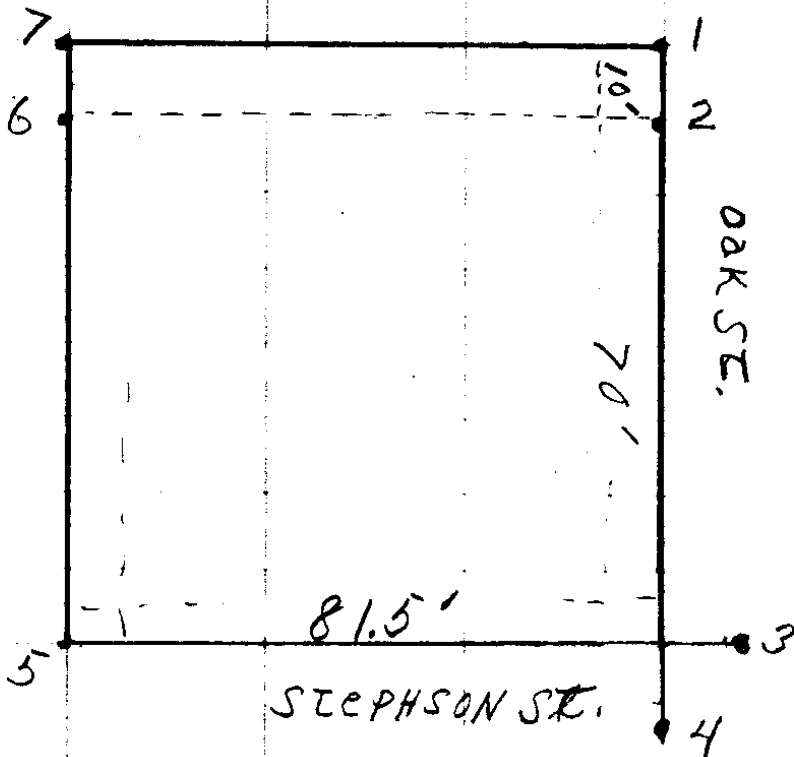

May 7-1929

H. Epstein

C.S. 5/43

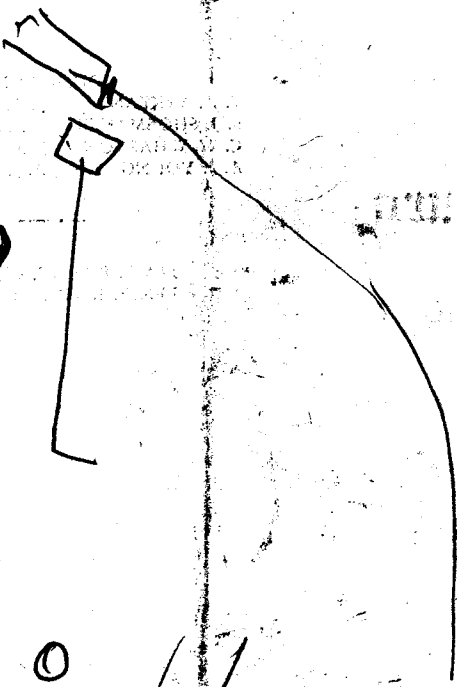

$$\begin{array}{r}
 386.15 \\
 60 \\
 \hline
 41326.15 \\
 \hline
 81.54
 \end{array}$$

6222

$$\begin{array}{r}
 386.1 \\
 385.8 \\
 \hline
 3
 \end{array}$$

$$\begin{array}{r}
 27.37 \\
 2.24 \\
 \hline
 29.61
 \end{array}$$

$$\begin{array}{r}
 81.45 \\
 325.80 \\
 \hline
 385.80
 \end{array}$$

