

School Dist # 21

Camas Valley Cracker

Jack Wolford

Trueman-

School Board.

C. S. File No.

6/46

Cor Center Sec. 2a T29-B

③

160.0
150.0 645.8
120.0

④

300.0
734.1

107°06'R

A.1.

6°50'R

A.2

S1°30'W S1°30'W

N74'E N74°24'E

N66°29'E N67°34'E

C. S. File No. 6/46

Sta Dist Angle Slope N.C C.C

Cor. Center Sec. 20 T 29 - 8.


	645.8			S 1° 30' W	S 1° 30' W
△		107° 06' R			
	734.1			N 74° E	N 74° 24' E
△ 1		6° 50' R			
				N 66° 30' E	N 67° 34' E
△ 2				S 66° 30' W	S 67° 34' W
△ 1		87° 37' R			
	277.5			S 20° E	S 20° 03' E
△ 7		76° 02' R			
	^{149.9} 145.0 294.9		Vert A 5° 13' 145.6	N 84° E	N 83° 55' E
△ 6		33° 49' R			
	249.0			N 50° E	N 50° 06' E
△ 5		32° 34' R			
	285.7			N 17° E	N 17° 32' E
△ 4		88° 27' R			
	^{32.27} 246.0 278.2			N 71° 30' W	N 70° 55' W
△ 3		74° 20' R			
	217.7	(65° 39')		S 34° 30' W	S 34° 45' W
△ 2		32° 49' L			
	301.6			S 66° 30' W	S 67° 34' W
△ 1					

C. S. File No. 6/46

Sta.	Dist.	Angle	Slope	N.C.	C.C.
Δ 2				S 66° 30' W	S W
Δ 1	151.0	87° 37' R		S 20° E	
	<u>126.5</u>				
	277.5				
Δ 7	149.9	76° 02' R	V.A 5° 13	N 84° E	N E
	<u>145.0</u>		145.6		
	294.9				
Δ 6	249.0 ^{1° 30'}	33° 49' R	1° 30'	N 50° E	N E
			249.0		
Δ 5	255.7	32° 34' R		N 17° E	N E
Δ 4	32.7	88° 27' R		N 71° 30' W	N W
	<u>246.0</u>				
	278.7				
Δ 3	217.7	74° 20' R		S 34° 30' W	S W
		65° 39'			
Δ 2		32° 49' L		S 66° 30' W	S W
	301.6				
Δ 1					

School Site Dist #21

Beginning at a point in the Center of the County
Road, which point bears N 57° 00' W - 822.9 feet from the center
of Section 20 Township 29 South, Range 8 West, Willamette
Meridian, Douglas County, Oregon, thence S 67° 34' W 201.6 feet,
thence S 84° 43' W 217.7 feet, thence N 70° 55' W 278.2 feet, thence
N 17° 32' E 285.7 feet, thence N 60° 06' E 249.0 feet, thence
N 83° 55' E 294.9 feet, thence S 80° 03' E 277.5 feet to the place of
beginning, containing 4.90 acres more or less.

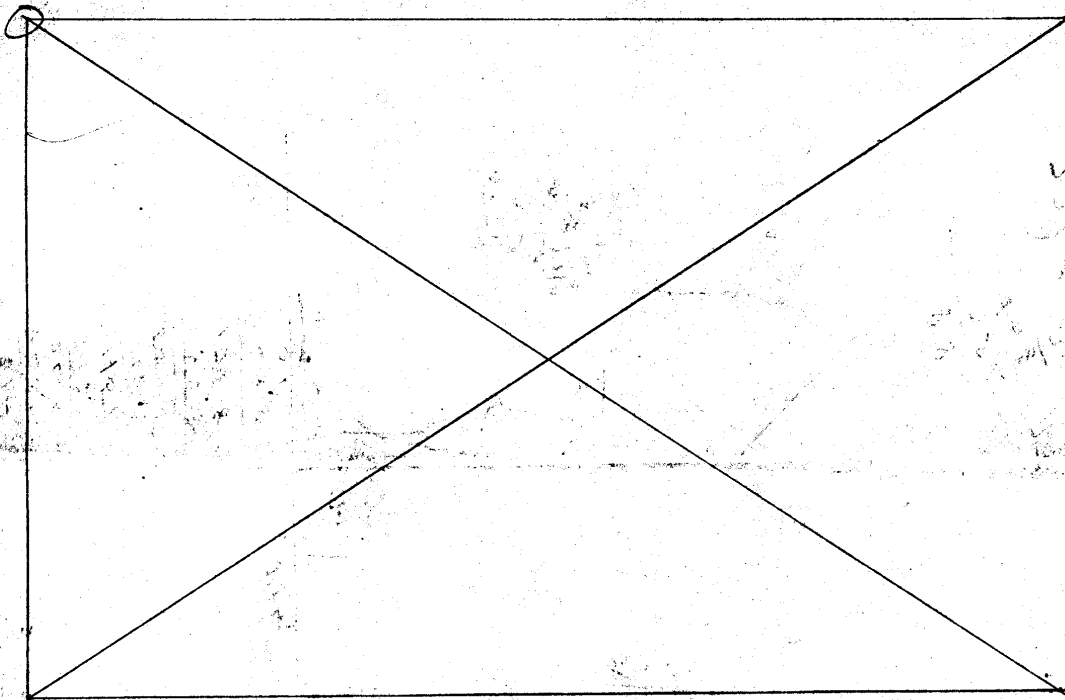

CS FILE FOLDER

CONTAINS

MORE

INFORMATION