

6-57
1
Glide school

Richardson
Smith
Eppstein

Fell 65 Feet North of Gurney line
set $\Delta 6-6.5$ Feet south

From I Bar to $\frac{1}{4}$ cor 275 lbs

Gurney NW, Cor, I Bolt

cor $\Delta 6$

6.5 573

$\Delta 6$

July 31-1922

3-14 PM.

Vert. $44^{\circ}04'$

Hor. $71^{\circ}16'$

Needles 573-30W

C. S. File No.

6/57

Back sight on bolt east

W. A. Burr Irrigation System,

Glide School

2

Richardson
Eppstein
Bob Blakeley


W 589-35W



July 29-1922
6 P.M.

Vert 160-11'
Hor 110-28'

C. S. File No. 6/57

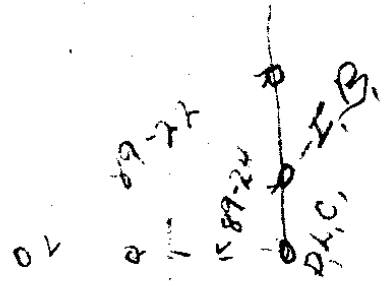

West
N 18-35W

Δ4


W. K. C. Iron Bar. N.W. Cor. Shuld.

Tom
Henry

Guide School 6-57

NE			
^{Δ6} SE Cor	247.5	89-12	
Enter L SW	528 ⁰	90-48	S 89-48E
inter by SE Cor	82.5	on East line of 2 acres tract	S 10° W
NEC		X	
NEC	264 ⁰		N 89-48E
SE Cor	493 ⁰	89-12	N 10° E
^{140°} SW Cor	264 ⁰	90-48	S 89-48E
SW Cor	330 ⁰		
NE Cor	1645	89-12'	S 123° W S 10° W
0+00 104C			S 89-48E ^W

13

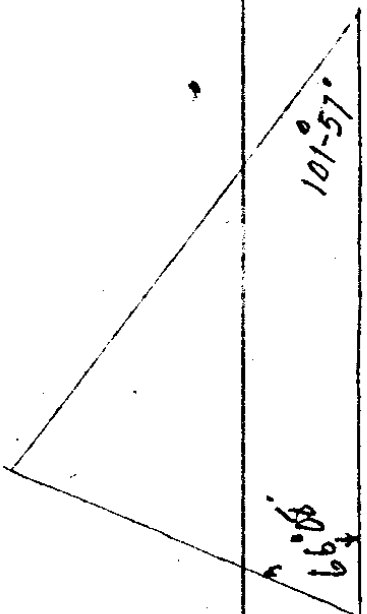

End of Road

Guide School

Sta	Dist	L A	R A	M.C.	C.C.
-----	------	-----	-----	------	------

P, N

Δ 6^{NE}_{cm.} 161⁵

Δ 5 169⁰

Δ 4^{SE}_{cm} 161⁰_{cm} 90⁰

N 0-25 W

Δ 3 105³

Δ 2^{SW}_{cm} 158⁷ 90⁰₈₉₋₅₉

East N 89-35 E

Δ 1^{SW}_{cm} 330⁰

South 50-25 E

165⁰

South 50-25 E

0700

IRA B. RIDDLE, COUNTY CLERK
S. W. STARMER, SHERIFF
J. E. SAWYERS, TREASURER
FRANK L. CALKINS, ASSESSOR
O. C. BROWN, SCHOOL SUPT.
M. E. RITTER, CORONER
F. C. FREAR, SURVEYOR

DOUGLAS COUNTY
ROSEBURG, OREGON

COUNTY JUDGE, GEORGE K. QUINE
COMMISSIONERS: EDWIN WEAVER
R. W. LONG
DIST. ATTORNEY, GEORGE NEUNER, JR

COUNTY COURT
FIRST WEDNESDAY IN EACH MONTH

DEED DESCRIPTION FOR GLIDE SCHOOL.

Beginning at a point, marked by a $\frac{1}{2}$ " x 18" galv. iron pipe, from which the North West Corner of the Thomas Shrum Donation Land Claim No. 42 in Section 19 Township 26 South, Range 3 West, Wil. Meridian, bears North 165.0 feet;

Thence East 264.0 feet to $\frac{1}{2}$ " x 18" Galv. iron pipe and the west line of the property owned by Delilah J. Gurney,

Thence South 330.0 feet to $\frac{1}{2}$ " x 18" galv. iron pipe.

Thence West 264.0 feet to $\frac{1}{2}$ " x 18" galv. iron pipe.

Thence North along the West line of D. L. C. No. 42 330.0 feet to the place of beginning. Containing 2.0 acres. Variation 20° 15'

ALSO.

Beginning at a point, marked by $\frac{1}{2}$ " x 18" galv. iron pipe, from which the North West Corner of Donation Land Claim No. 42 in section 19 Township 26 South Range 3 West Wil. Meridian, Douglas County, Ore. bears North 165.0 feet and West 264.0 feet;

Thence East, along the South line of the property owned by Delilah J. Gurney, 825.0 feet to $\frac{1}{2}$ " x 18" galv. iron pipe.

Thence South 247.5 feet to $\frac{1}{2}$ " x 18" galv. iron pipe.

Thence West 825.0 feet to $\frac{1}{2}$ " x 18" galv. iron pipe.

Thence North 247.5 feet to the place of beginning. Containing 3.0 acres Variation 20° 15'

80/382

80/488

E² SW⁴ 18 Lyng E. of Rump R

J Alex.

Lots 2 + 3 Sec 19 26/S

CS FILE FOLDER

CONTAINS

MORE

INFORMATION